

New Location
 Drill Deeper 5486 ✓
 Abandonment

MAP SHEET 17 - Square N16-17E17-18 - FB. 119.P. 19-21

4.21-5
~~4.27 S~~
 367 W
 (3.28 W)

Company <u>HOPE NATURAL GAS CO.</u>	
Address <u>CLARKSBURG, W. VA.</u>	
Farm <u>S.H. SHRIVER</u>	
Tract _____	Acres <u>600</u> Lease No. <u>676</u>
Well (Farm) No. <u>4</u>	Serial No. <u>5486</u>
Elevation (Spirit Level) <u>1148</u>	
Quadrangle <u>MANNINGTON</u>	
County <u>MONONGALIA</u>	District <u>BATTELLE</u>
Engineer <u>W.M. Brewer</u>	
Engineer's Registration No. <u>900</u>	
File No. _____	Drawing No. _____
Date <u>6-29-42</u>	Scale <u>1" = 80 poles</u>

STATE OF WEST VIRGINIA
 DEPARTMENT OF MINES
 OIL AND GAS DIVISION
 CHARLESTON

WELL LOCATION MAP
 FILE NO. Mon 147

+ Denotes location of well on United States Topographic Maps, scale 1 to 62,500, latitude and longitude lines being represented by border lines as shown.
 - Denotes one inch spaces on border line of original tracing.

WEST VIRGINIA DEPARTMENT OF MINES
OIL & GAS DIVISION
W E L L R E C O R D

Permit No. Mon-147					
Company	Hope Natural Gas Company			Gas Well	
Address	445 West Main St., Clarksburg, W. Va.			CASING & TUBING	
Farm	S.H. Shriver	Acres 600	10	989	989
Location	---		8 $\frac{1}{2}$	1621	1621
Well No.	5486	Elev. 1148	65/8	2146	2146
District	Batelle	Monongalia County	5 3/16	3098	3098
Surface	---				
Mineral	---				
Commenced	June 29, 1942				
Completed	July 27, 1942				
Volume	No Production Found				

DRILLED DEEPER

Record of drilling deeper

Started drilling at	3300	
Top Bayard Sand	3320	3328
White Limo	3356	
TOTAL DEPTH	3400	

NR-35
22-Oct-96

API # 47- 61-00147-P

STATE OF WEST VIRGINIA
DIVISION OF ENVIRONMENTAL PROTECTION
SECTION OF OIL AND GAS

JUN 03 1999
RECEIVED

AFFIDAVIT OF PLUGGING AND FILLING WELL

AFFIDAVIT SHOULD BE IN TRIPPLICATE, one copy mailed to the Division, one copy to be retained by the Well Operator and the third copy (and extra copies if required) should be mailed to each coal operator at their respective addresses.

Farm name: EASTERN ASSOCIATED COAL Operator Well No.: CNG 5486

LOCATION: Elevation: 1,080.00 Quadrangle: WADESTOWN
District: BATTELLE County: MONONGALIA
Latitude: 6950 Feet South of 39 Deg. 42 Min. 30 Sec.
Longitude 6800 Feet West of 80 Deg. 17 Min. 30 Sec.

Well Type: OIL _____ GAS X

Company: Eastern Associated Coal Corp
Route 1, Box 144
Fairview, WV 26570

Coal Operator Eastern Associated Coal Corp
or Owner Route 1, Box 144
Fairview, WV 26570

Agent: Terry O. Hendershot

Coal Operator _____
or Owner _____

Permit Issued: 10/22/96

AFFIDAVIT

STATE OF WEST VIRGINIA,
County of Monongalia ss:


Jim Gump and Melvin Eddy being first duly sworn according to law depose and say that they are experienced in the work of plugging and filling oil and gas wells and were employed by the above named well operator, and participated in the work of plugging and filling the above well, and Randal Mick Oil and Gas Inspector representing the Director, say that said work was commenced on the 12th day of November, 1996, and that the well was plugged and filled in the following manner:

TYPE	FROM	TO	PIPE REMOVED	LEFT
Cleaned out to 3,200', run 20	20 sks gell and 50 sks Portland cement.			
Cut 5" pipe @ 2,700', 2,600'	2,480'. Shot off @ 2,080' and pulled		Run 5 sks gell and 120 sks	
Portland cement. Cut 7" pipe @ 2,100' and 1,800' and pulled.			Pulled all 8". 1.621 gelled hole	
10 sks gell 350 sks Portland	Logged hole Gamma Ray, Neutron and 3 arm caliper			
Cut 10" @ 506'. Ripped old	10" from 860 to 874 2 times.			
Run 4 1/2" pipe to 1,015'. Pulled 506' of 10". Run 475 sks Portland cement and 300 sks			Chem Comp	
cement and got circulation.	Pumped plug to 995. Checked plug OK			
Pittsburgh coal 862'-872'				

Description of monument: 4 1/2" x 2" swedge, metal plate with A.P.I. # and date plugged. and that the work of plugging and filling said well was completed on the 14th day of December, 1996.

And further deponents saith not.

Sworn and subscribe before me this 23rd day of December, 1996
My commission expires: January 13, 2003

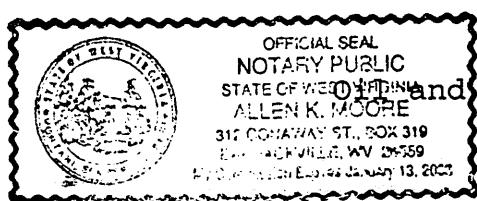

and Gas Inspector:

James V Gump Jr
Melvin B Eddy
Allen K Moore
Notary Public
Randal Mick

JUL 12 1999

MONO 0147 P