


Latitude 39° 40'

Longitude 80° 10'

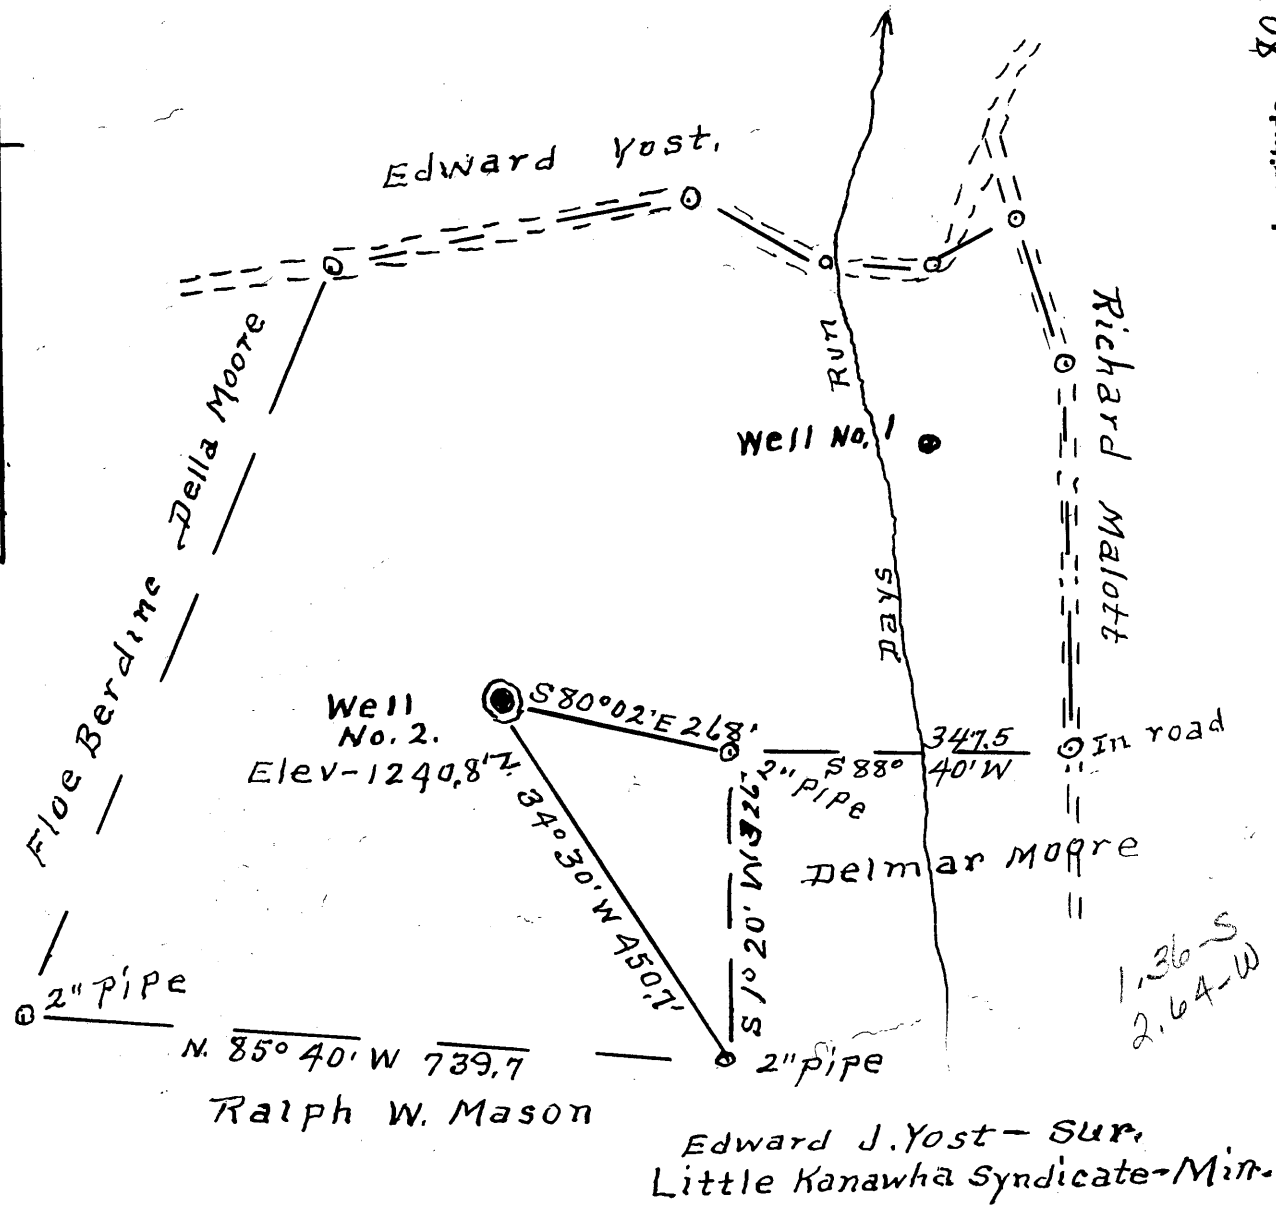

Ralph W. Mason

Edward J. Yost - Sur.
Little Kanawha Syndicate - Min.

"I, the undersigned, hereby certify that this map is correct to the best of my knowledge and belief and shows all the information required by paragraph 6 of the rules and regulations of the oil and gas section of the mining laws of West Virginia."

New Location
 Drill Deeper
 Abandonment

Company Yost & Yost Inc.
 Address R# 2, Fairview, W.Va.
 Farm Edward Yost
 Tract 1 Acres 15.53 Lease No. _____
 Well (Farm) No. 2 Serial No. _____
 Elevation (Spirit Level) 1240.8'
 Quadrangle Blacksville WC
 County Monongalia District Clay
 Engineer A. L. Headley
 Engineer's Registration No. 2021
 File No. _____ Drawing No. _____
 Date 1-18-63 Scale 1" = 200'

STATE OF WEST VIRGINIA
 DEPARTMENT OF MINES
 OIL AND GAS DIVISION
 CHARLESTON

WELL LOCATION MAP
 FILE NO. MON-263

+ Denotes location of well on United States Topographic Maps, scale 1 to 62,500, latitude and longitude lines being represented by border lines as shown.

- Denotes one inch spaces on border line of original tracing.



STATE OF WEST VIRGINIA
DEPARTMENT OF MINES
OIL AND GAS DIVISION 17

Rotary
Spudder
Cable Tools
Storage

Quadrangle Blacksville

Permit No. MON-263

WELL RECORD

Oil or Gas Well OIL
(KIND)

Company Yost & Yost, Inc.
Address Rt. 2, Fairview, West Virginia
Farm Edward J. Yost Acres 15
Location (waters) Doys Run
Well No. 2 Elev. 1240.8'
District Clay County Monongalia
The surface of tract is owned in fee by Edward J. Yost
Address Fairview, w. Va.
Mineral rights are owned by Same as surface
Address _____
Drilling commenced Jan. 30, 1962
Drilling completed Feb. 31, 1963
Date Shot no From _____ To _____
With _____

Casing and Tubing	Used in Drilling	Left in Well	Packers
Size			Kind of Packer
16.			
13.			
10.	450	450 none	Size of
8 1/4	850	850	
6 3/4	1707	none	Depth set
5 3/16	2070	2070	
3.			Perf. top
2.	2220	2220	Perf. bottom
Liners Used			Perf. top
			Perf. bottom

Open Flow /10ths Water in _____ Inch

/10ths Merc. in. _____ Inch

Volume _____ Cu. Ft.

Rock Pressure _____ lbs. _____ hrs.

Oil 5 No _____ bbls., 1st 24 hrs.

WELL ACIDIZED No

WELL FRACTURED No

CASING CEMENTED No SIZE _____ No. Ft. _____ Date _____

COAL WAS ENCOUNTERED AT _____ FEET _____ INCHES

_____ FEET _____ INCHES _____ FEET _____ INCHES


_____ FEET _____ INCHES _____ FEET _____ INCHES

RESULT AFTER TREATMENT

ROCK PRESSURE AFTER TREATMENT

Fresh Water _____ Feet Salt Water _____ Feet

Formation	Color	Hard or Soft	Top	Bottom	Oil, Gas or Water	Depth	Remarks
Slate	dark	soft	10	20			
Red rock	red	soft	20	35			
Sand	light	hard	35	70			
Red rock	red	soft	70	80			
Slate	dark	soft	80	100			
Lime	light	hard	100	120			
Slate	dark	soft	120	134			
Red Rock	red	soft	134	140			
Slate	dark	soft	140	162			
Lime	light=	hard	162	243			
Slate	dark	soft	243	317			
Lime	light	hard	317	332			
Slate	dark	soft	332	346			
Lime	light	hard	346	390			
Sand	light	hard	390	445			
lime	light	hard	445	464			
Coal	Black	soft	464	467			
Lime	light	hard	467	472			
sand	light	hard	472	500			
shale	dark	soft	500	560			
Lime	light	hard	560	710			
Coal <u>Sw</u>	Black	soft	710	719			
Slate	dark	soft	719	745			
Lime	light	hard	745	812			
Coal <u>Pgh</u>	Black	soft	812	820			
Slate	dark	soft	820	900			
Lime	light	hard	900	975			
Red Rock	Red	soft	975	1020			
Slate & Shells	Dark	soft	1020	1300			

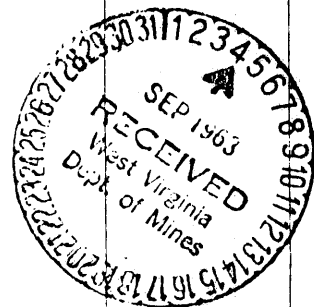

Formation	Color	Hard or Soft	Top	Bottom	Oil, Gas or Water	Depth Found	Remarks
Lime	light	hard	1300	1385		1385	
sand	light	hard	1385	1415		1241	
sand	light	hard	1470	1495	BI	1441	
Slate & Shell	dark	soft	1495	1675			
sand	light	hard	1675	1700			
Slate	dark	soft	1700	1887	2023		
sand	light	hard	1887	1895			
slate	dark	soft	1895	1940			
Red Rock	red	soft	1940	2023			
lime	light	hard	2023	2075			
Pencil	dark	soft	2084	2155			
Lime	light	hard	2155	2160			
Sand 371	light	hard	2160	2275	Oil & Water	2239	Big 1 1/2 in
Total depth			- 2275				

Date August 14, 1963

APPROVED Yost & Yost, Inc. Owner

By Joe D. Yost, President
(Title)