

6100336P

WW-7
8-30-06



West Virginia Department of Environmental Protection
Office of Oil and Gas
WELL LOCATION FORM: GPS

API: 47-061-00336 WELL NO.: 7121

FARM NAME: Deckers Creek

RESPONSIBLE PARTY NAME: Sarah Weigand

COUNTY: Monongalia DISTRICT: Morgan

QUADRANGLE: Morgantown South

SURFACE OWNER: Royce H. Heiskell, Harriet Jane Harworth, & Joseph Mark Harworth

ROYALTY OWNER: SAME

UTM GPS NORTHING: 4,381,814.882 METERS

UTM GPS EASTING: 596,383.141 METERS GPS ELEVATION: 630.436 METERS (2068')

The Responsible Party named above has chosen to submit GPS coordinates in lieu of preparing a new well location plat for a plugging permit or assigned API number on the above well. The Office of Oil and Gas will not accept GPS coordinates that do not meet the following requirements:

1. Datum: NAD 1983, Zone: 17 North, Coordinate Units: meters, Altitude: height above mean sea level (MSL) – meters.
2. Accuracy to Datum – 3.05 meters
3. Data Collection Method:

Survey grade GPS : Post Processed Differential

Real-Time Differential

Mapping Grade GPS : Post Processed Differential

Real-Time Differential

4. **Letter size copy of the topography map showing the well location.**

I the undersigned, hereby certify this data is correct to the best of my knowledge and belief and shows all the information required by law and the regulations issued and prescribed by the Office of Oil and Gas.

Sarah Weigand
Signature

Permitting Manager
Title


9/28/17
Date

RECEIVED
Office of Oil and Gas

OCT 12 2017

WV Department of
Environmental Protection

12/01/2017

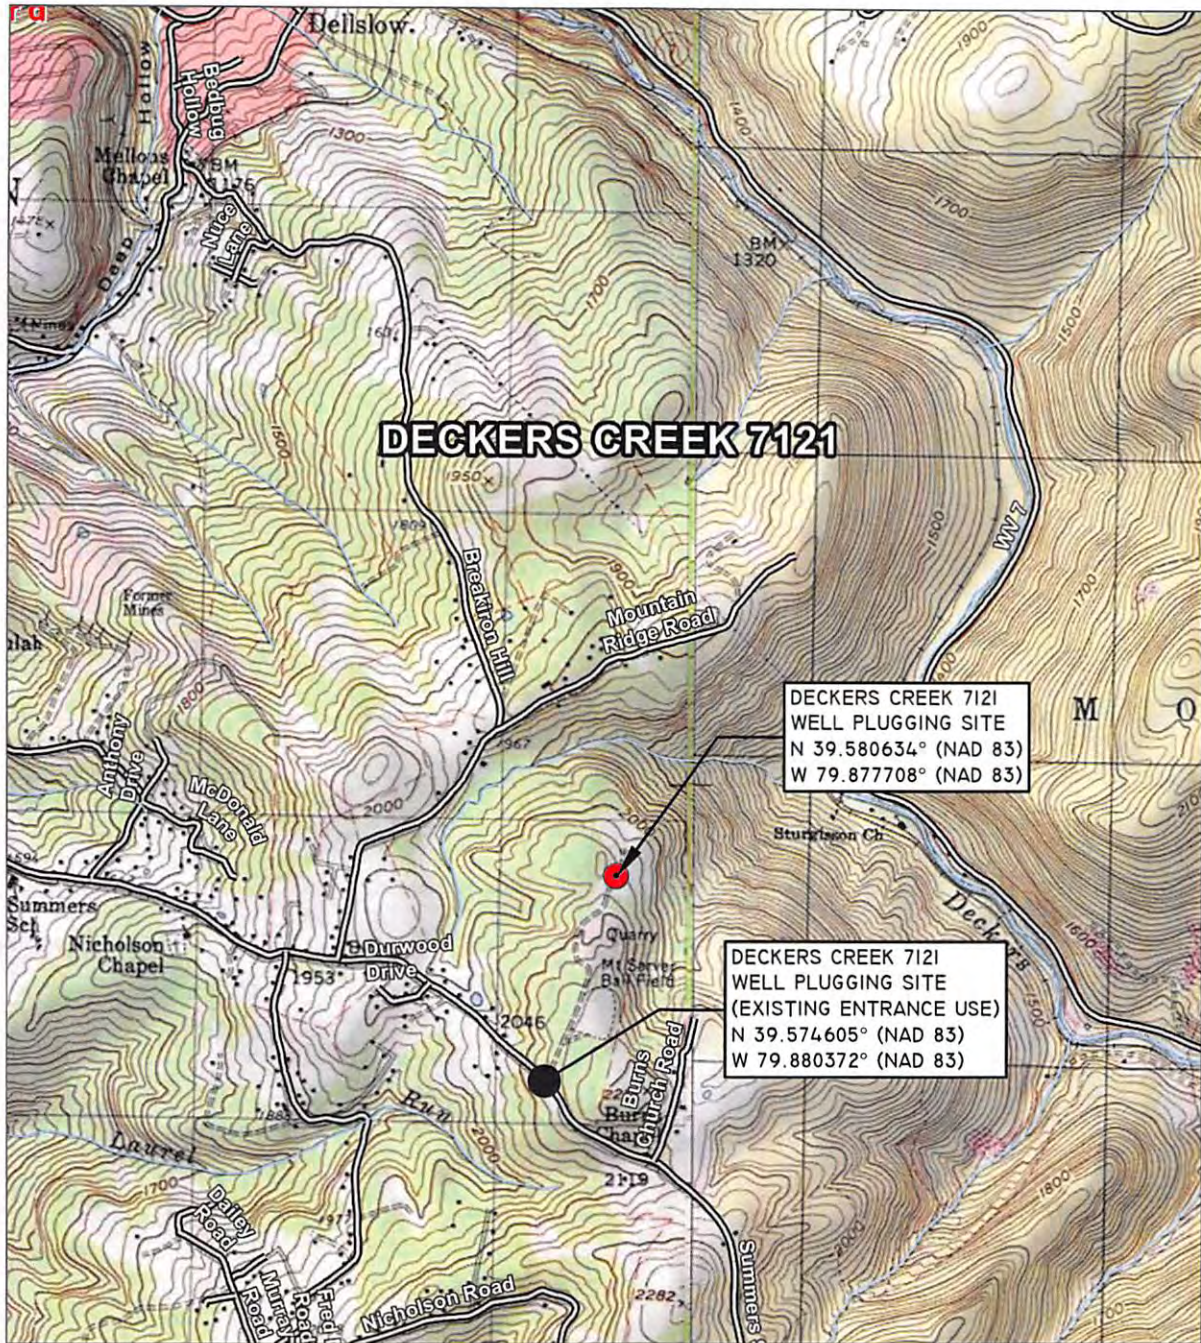

LOCATION MAP
MORGANTOWN SOUTH, WV 7.5M USGS QUADRANGLE
SCALE: 1"=2000'



RECEIVED
Office of Oil and Gas



Blue Mountain Inc.

Engineers and Land Surveyors
Woman Owned Small Business

11023 Mason Dixon Hwy.
Burton, WV 26562-9656
(304) 662-6486

LOCATION MAP
GAS WELL PLUGGING
DECKERS CREEK 7121 GAS WELL
MORGAN DISTRICT
MONONGALIA COUNTY, WV
CONSOL GAS COMPANY
200 HALLAM ROAD
WASHINGTON, PA 15301

DRAWN BY: LLF	Office of Oil and Gas
CHECKED BY: WPF	OCT 12 2017
DATE: 07/21/2017	
SCALE: 1"=2000'	WV Department of Environmental Protection
WATERSHED:	
OUTLET DECKERS CREEK	
PAGE 4 OF 4	