


LATITUDE 39° 37' 30"

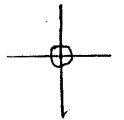

D

80° 12' 30"

LONGITUDE

7'5 OGIS topo location

7.5' LOC 0.145
0.18w

15' LOC _____
(calc.) _____

Company _____

Farm _____

Quad GRANT TOWN 7 1/2'

County MONTGOMERIA

District CLAY


Elev. 1430 ± (topo)

WELL LOCATION MAP

File No. 061-0465

138 in 1912 Co. Rpt

Old = 70282

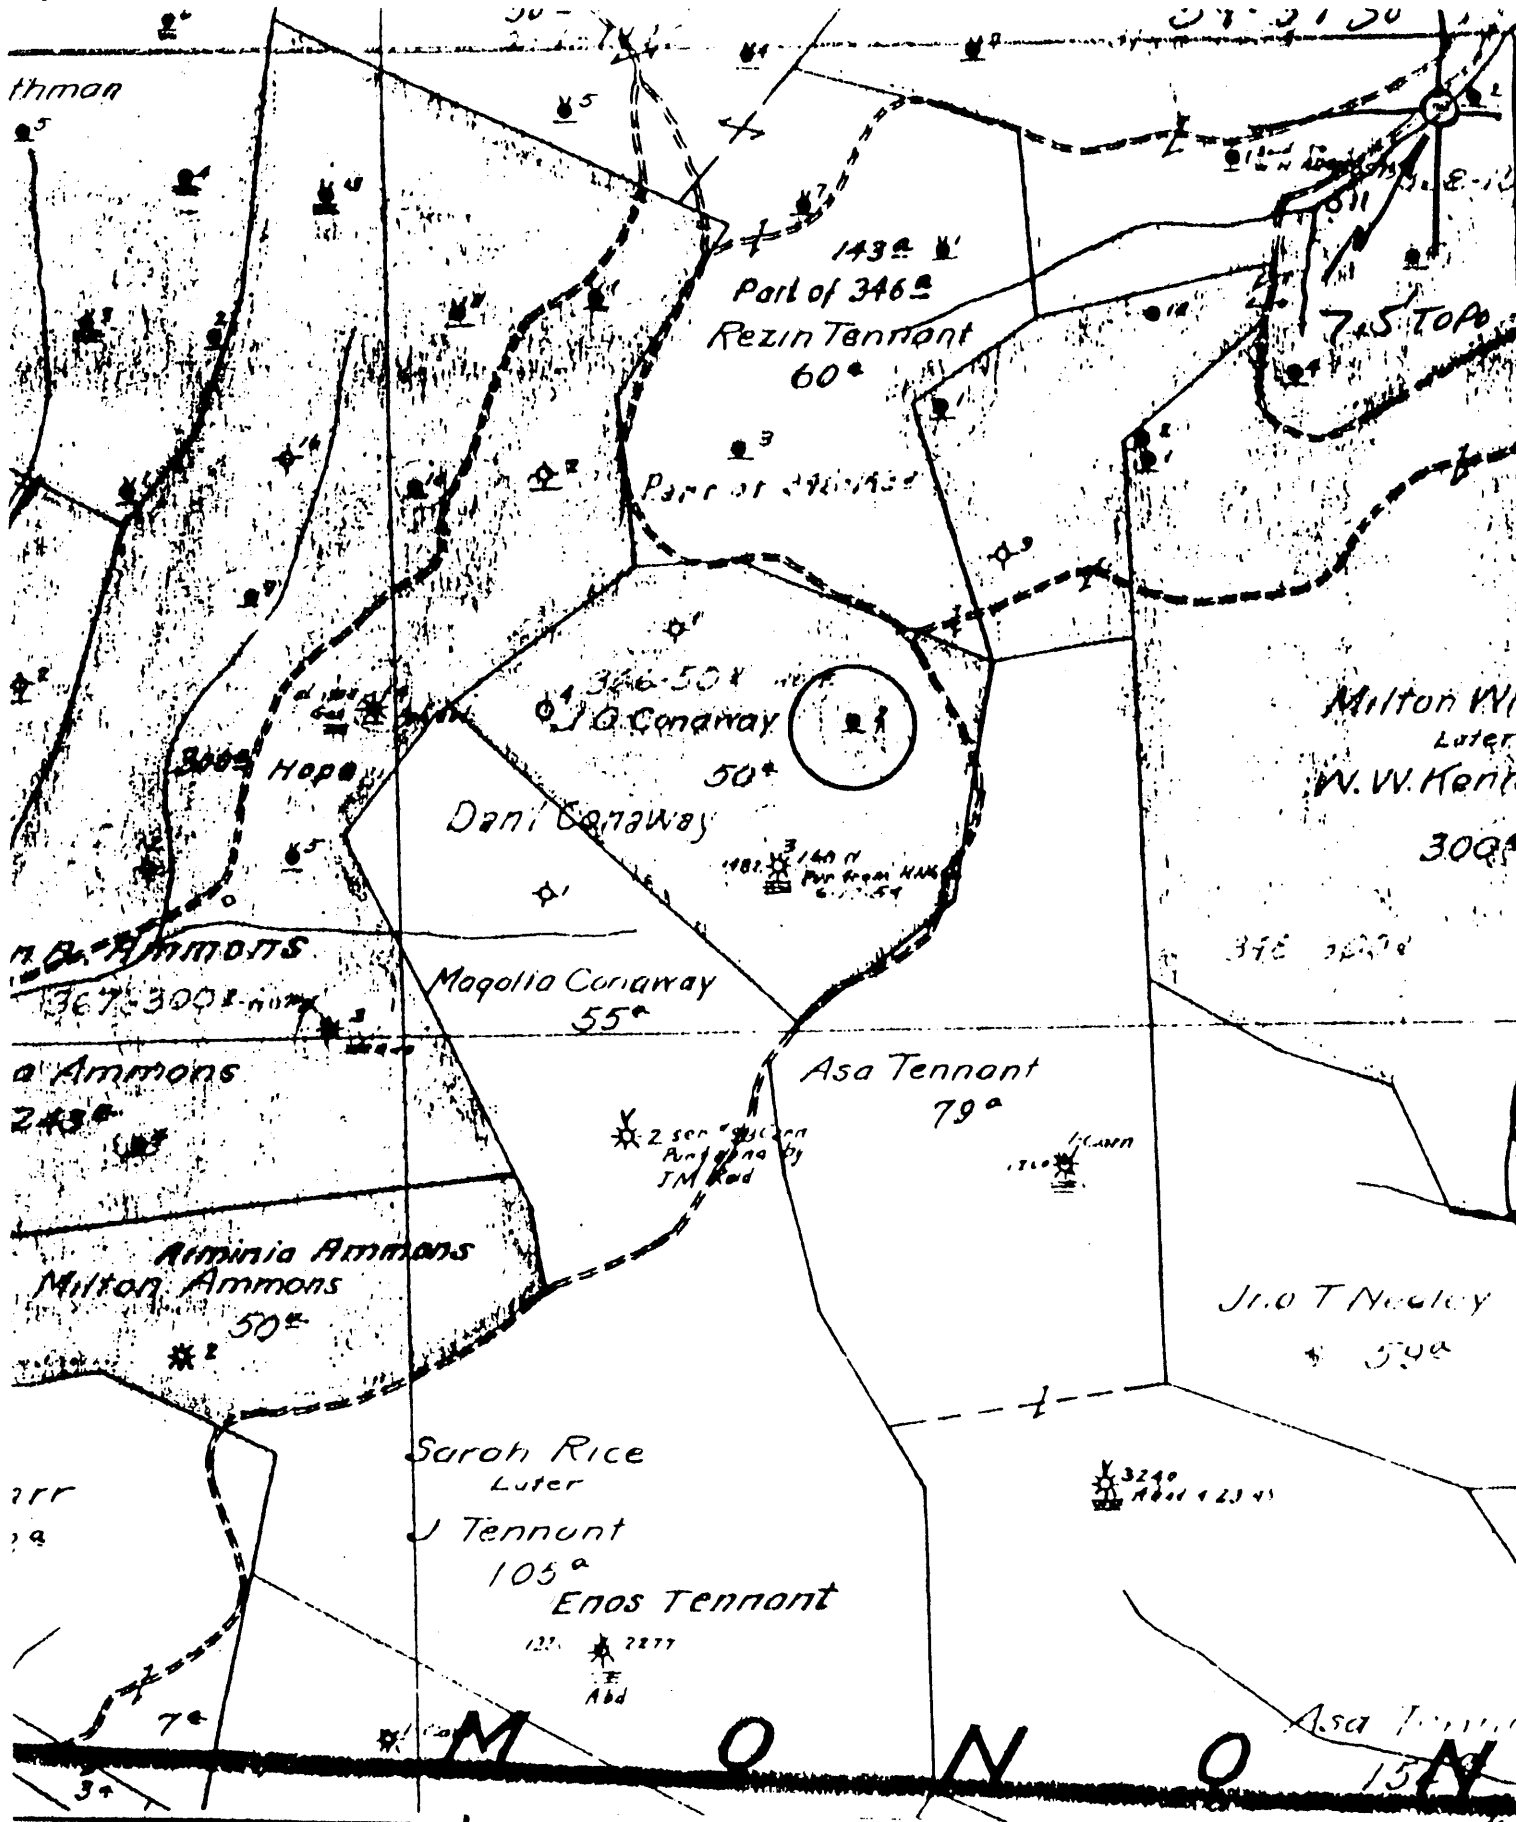

+) DENOTES LOCATION OF WELL ON UNITED STATES TOPOGRAPHIC MAPS

FORM IV-6 (8-78)

16ZEN12G2A

STATE OF WEST VIRGINIA DEPARTMENT OF MINES OIL AND GAS DIVISION

WELL TYPE: OIL GAS LIQUID INJECTION WASTE DISPOSAL
 (IF "GAS", PRODUCTION STORAGE DEEP SHALLOW)

LOCATION: ELEVATION _____ WATER SHED BENEFIELD PRONG
 DISTRICT CLAY COUNTY MONONGALIA
 QUADRANGLE GRANT TOWN 7.5'

SURFACE OWNER _____ ACREAGE _____
 OIL & GAS ROYALTY OWNER _____ LEASE ACREAGE _____
 LEASE NO. _____

PROPOSED WORK: DRILL CONVERT DRILL DEEPER REDRILL FRACTURE OR STIMULATE PLUS OFF OLD FORMATION PERFORATE NEW FORMATION OTHER PHYSICAL CHANGE IN WELL (SPECIFY) _____

PLUG AND ABANDON CLEAN OUT AND REPLUG

TARGET FORMATION _____ ESTIMATED DEPTH _____

WELL OPERATOR Pennzoil Company DESIGNATED AGENT James A. Crews
 ADDRESS P. O. Box 1588 ADDRESS P. O. Box 1588
Parkersburg, WV 26101 Parkersburg, WV 26101

DATE 1-24-, 1979
 OPERATOR'S WELL NO. 2
 API WELL NO. 47-061-0465
 STATE COUNTY PERMIT

SOUTH PENN OIL COMPANY—COMPLETION

SERIAL NO. _____ FARM Gonaway J. G. WELL NO. 2
 ELEVATION _____ N. 12 S. _____ E. 23 W. _____
 LEASE NO. _____ ACRES 50
 WATERS OF Branch of Bennifield
 DISTRICT Clay COUNTY Monongalia STATE W. Va.
 DRILLING COMMENCED 9/7/92. COMPLETED 12/24/92. DEPTH 2348'

SANDS	TOP		BOTTOM		ELEV. TOP	CASING USED
	PTH. COAL OR BTG. LINE	DEPTH	DEPTH	DEPTH		
Big Injun		900'			10"	910'
Gas-medium		2197'			8 1/2"	780'
1st. Pay		2300'			6 5/8"	1930'
2nd. Pay		2322'			5 3/16"	2661'

INITIAL PROD. No record SAND Big Injun DEPTH 2322'
 GAS TEST No test.
 SHOT _____ QUARTS _____
 REMARKS "Not drilled through Big Injun"
 REPORTED BY [Signature] ABANDONED _____

47-061-0465