


LATITUDE 39° 40' 00"

D

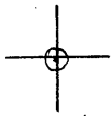

LONGITUDE 80° 10' 00"

7'5 OGIS topo location

7.5' loc 1.09 S 15' loc _____
' 1.39 W (calc.) _____

Company _____

Farm _____

Quad BLACKSVILLE 7 1/2'


County MONONGALIA

District CLAY

Plan 1120± (Tops)

WELL LOCATION MAP

File No. 061-0516

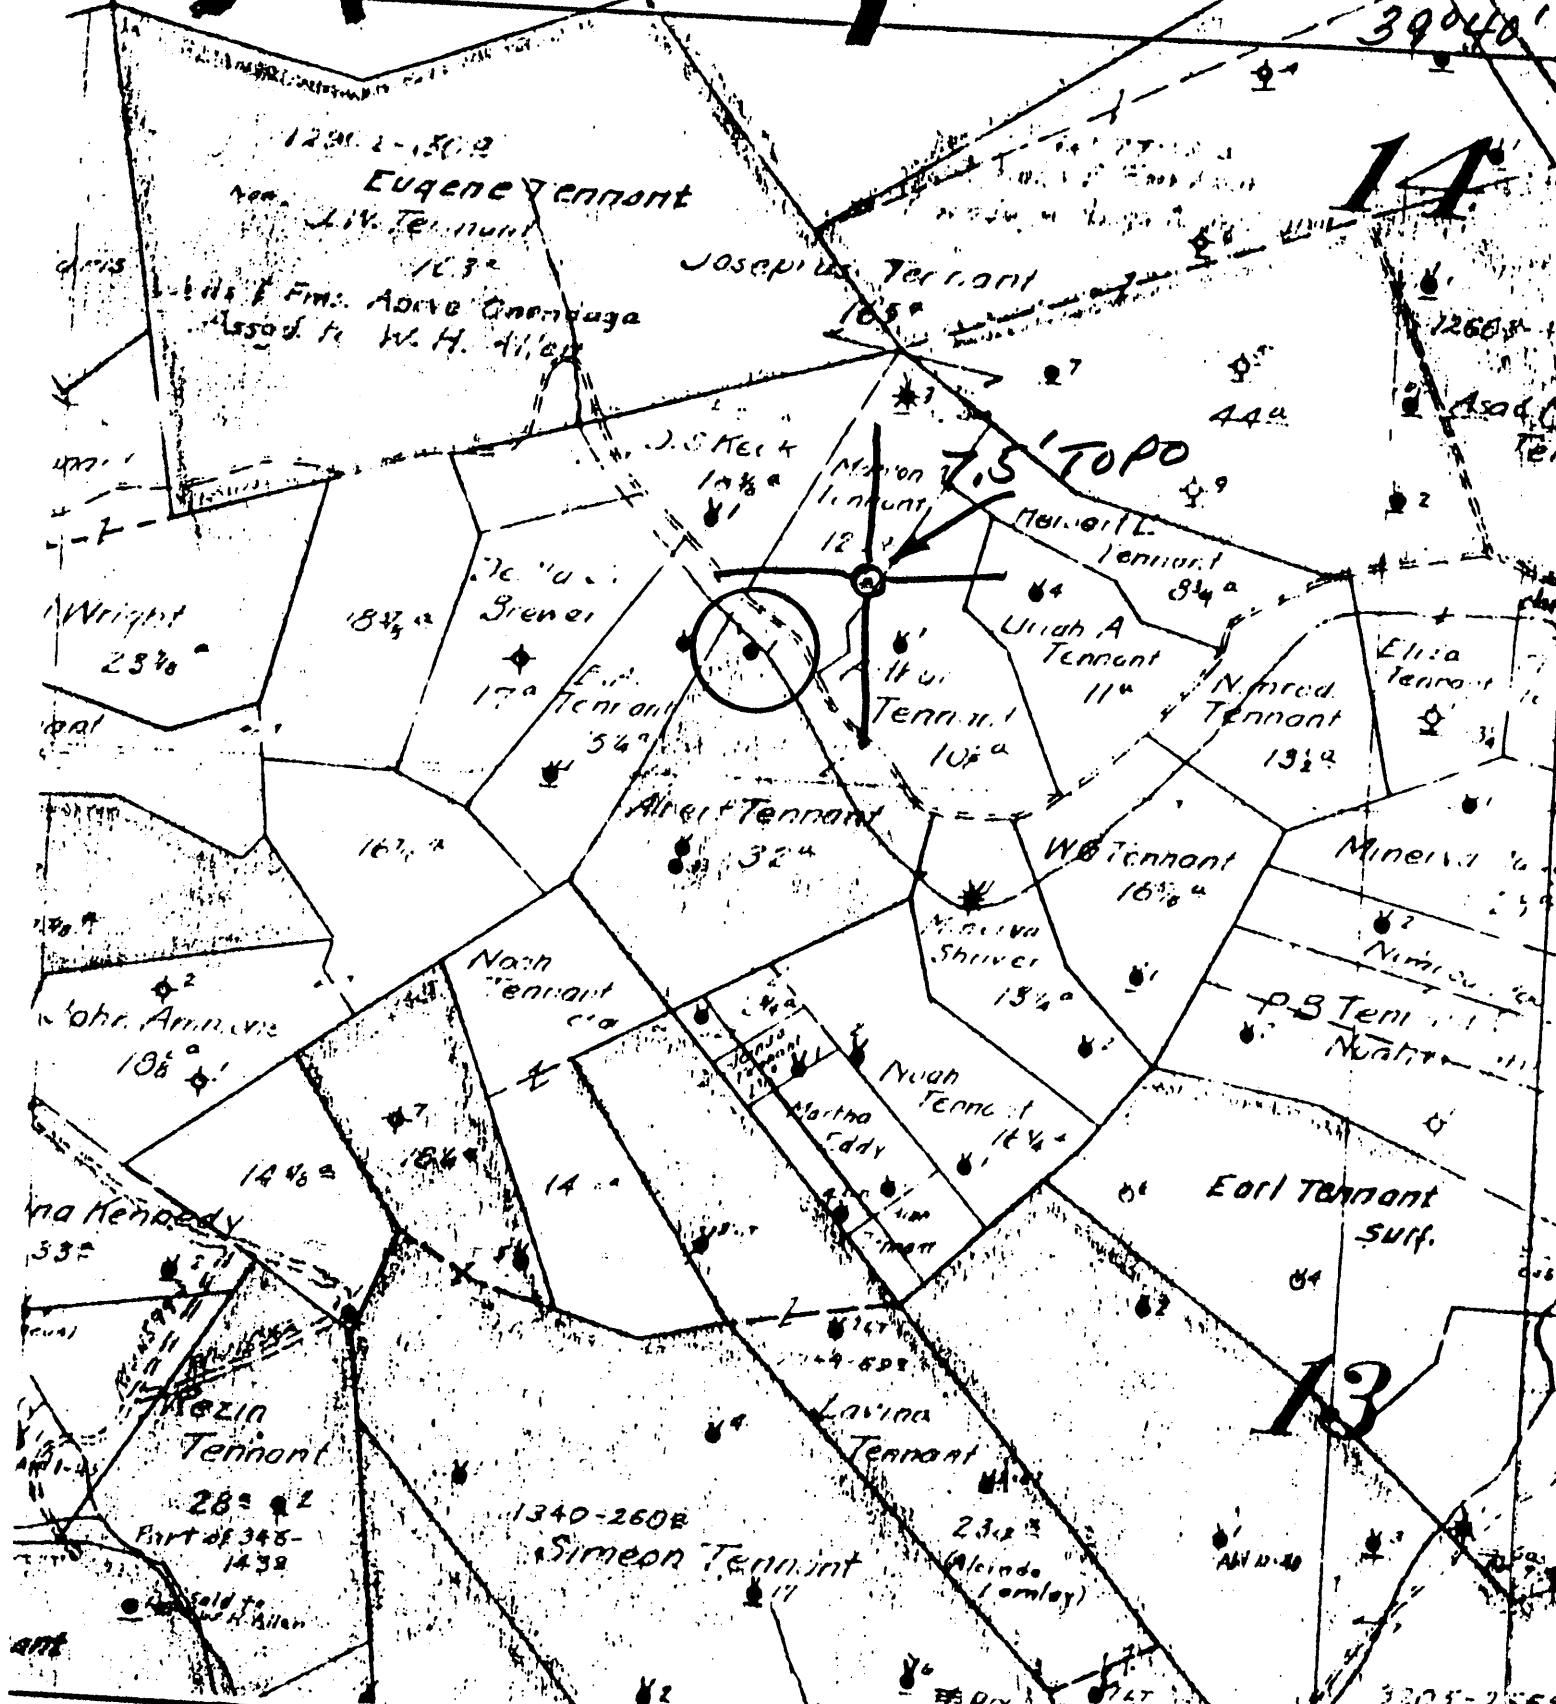

(+) DENOTES LOCATION OF WELL ON UNITED STATES TOPOGRAPHIC MAPS

FORM IV-6
(8-78)
V7ZE N13E24



STATE OF WEST VIRGINIA
DEPARTMENT OF MINES

DATE 1-24, 1972
OPERATOR'S WELL NO. 1
API WELL NO. 47
STATE 061 COUNTY 05 PERMIT 576

WELL TYPE: OIL GAS LIQUID INJECTION WASTE DISPOSAL
(IF "GAS", PRODUCTION STORAGE DEEP SHALLOW
LOCATION: ELEVATION _____ WATER SHED JAKES RUN
DISTRICT CLAY COUNTY MONONGALIA
QUADRANGLE BLACKSVILLE 7.5
SURFACE OWNER _____
OIL & GAS ROYALTY OWNER _____ ACREAGE _____
LEASE NO. _____ LEASE ACREAGE _____
PROPOSED WORK: DRILL CONVERT DRILL DEEPER REDRILL FRACTURE OR
STIMULATE PLUS OFF OLD FORMATION PERFORATE NEW
FORMATION OTHER PHYSICAL CHANGE IN WELL (SPECIFY) _____

PLUS AND ABANDON CLEAN OUT AND REPLUS _____
TARGET FORMATION _____ ESTIMATED DEPTH _____
WELL OPERATOR Pennzoil Company DESIGNATED AGENT James A. Crews
ADDRESS P. O. Box 1588 ADDRESS P. O. Box 1588
Parkersburg, WV 26101 ADDRESS Parkersburg, WV 26101

Albert TENNANT - 1

SOUTH PENN OIL COMPANY—COMPLETION

SERIAL NO. _____ FARM Tennant Albert WELL NO. _____
 ELEVATION _____ N. 13-14 E. 24 W. _____
 LEASE NO. 360 ACRES 32 1/4
 WATERS OF Jakes Run
 DISTRICT Clay COUNTY Monongalia STATE W. Va.
 DRILLING COMMENCED 3/14/1894 COMPLETED 5/8/1894 DEPTH 2008'

BANDS	TOP	BOTTOM	ELEV. TOP	CASING USED
Pen. Coal	595			
Big Injun	1915	2080	10"	610
1st pay	2000	1595	8 1/2"	825
2nd pay	2008	1405	6 5/8"	1650
			5 3/16"	292

INITIAL PROD. No record 45 bbl SAND Big Injun DEPTH 2008

GAS TEST No

SHOT 3 QUARTS 12 to 40

REMARKS (Not drilled through Big Injun)

REPORTED BY J. M. ... ABANDONED _____

516

47-001 - ~~05177~~

061- 516