

LATITUDE 39° 40' 00"



03' 40.08" LONGITUDE

7'5 OGIS topo location

7.5' loc 1.00 S 15' loc \_\_\_\_\_  
' 1.78 W (calc.) \_\_\_\_\_

Company \_\_\_\_\_

Farm \_\_\_\_\_

Quad BLACKSVILLE 7 1/2'

County MONONGALIA


District CLAY

Elev 1270 ± (TOPO)

WELL LOCATION MAP

File No. 061-0522

34040

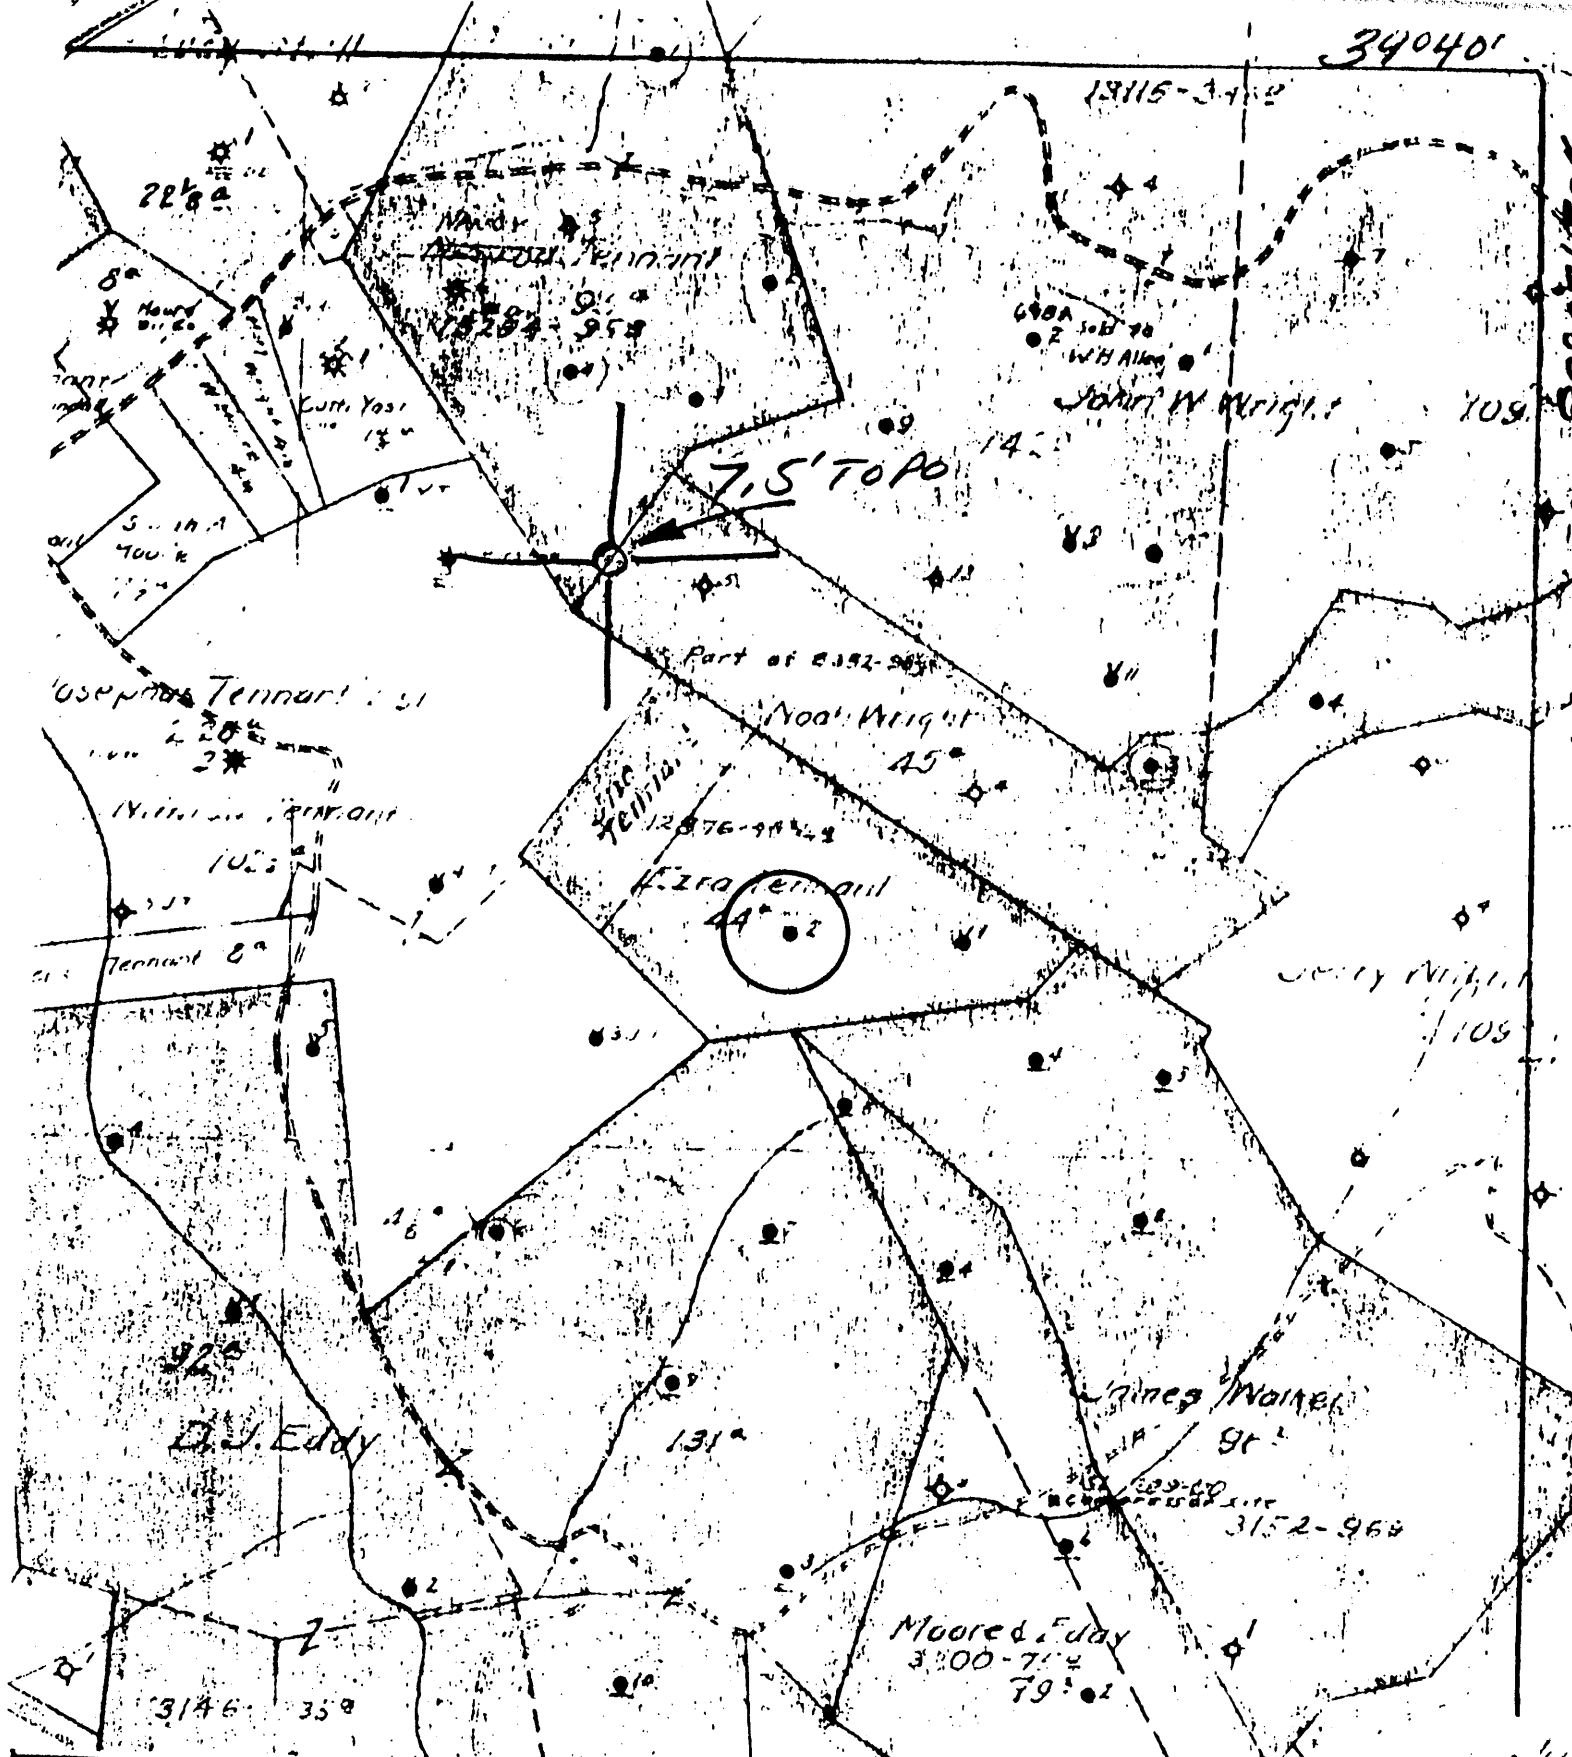

(+) DENOTES LOCATION OF WELL ON UNITED STATES TOPOGRAPHIC MAPS

FORM IV-6  
(8-78)  
*N72E N12E2A*



STATE OF WEST VIRGINIA  
DEPARTMENT OF MINES  
OIL AND GAS DIVISION

DATE 1-24- 1979  
OPERATOR'S WELL NO. 2  
API WELL NO. 47-061-0502  
STATE COUNTY PERMIT

WELL TYPE: OIL  GAS \_\_\_\_\_ LIQUID INJECTION \_\_\_\_\_ WASTE DISPOSAL \_\_\_\_\_  
( IF "GAS", PRODUCTION \_\_\_\_\_ STORAGE \_\_\_\_\_ DEEP \_\_\_\_\_ SHALLOW \_\_\_\_\_ )  
LOCATION: ELEVATION \_\_\_\_\_ WATER SHED JAKES RUN  
DISTRICT CLAY COUNTY MONONGALIA  
QUADRANGLE BLACKVILLE 7.5'

SURFACE OWNER \_\_\_\_\_ ACREAGE \_\_\_\_\_  
OIL & GAS ROYALTY OWNER \_\_\_\_\_ LEASE NO. \_\_\_\_\_ LEASE ACREAGE \_\_\_\_\_

PROPOSED WORK: DRILL \_\_\_\_\_ CONVERT \_\_\_\_\_ DRILL DEEPER \_\_\_\_\_ REDRILL \_\_\_\_\_ FRACTURE OR STIMULATE \_\_\_\_\_ PLUS OFF OLD FORMATION \_\_\_\_\_ PERFORATE NEW FORMATION \_\_\_\_\_ OTHER PHYSICAL CHANGE IN WELL (SPECIFY) \_\_\_\_\_

PLUG AND ABANDON \_\_\_\_\_ CLEAN OUT AND REPLUG \_\_\_\_\_  
TARGET FORMATION \_\_\_\_\_ ESTIMATED DEPTH \_\_\_\_\_  
WELL OPERATOR Pennzoil Company DESIGNATED AGENT James A. Crews  
ADDRESS P. O. Box 1588 ADDRESS P. O. Box 1588  
Parkersburg, WV 26101 Parkersburg, WV 26101

*ERRATA TENNANT - 2*

# SOUTH PENN OIL COMPANY COMPLETION

SERIAL NO. \_\_\_\_\_ FARM Tennant Ezra WELL NO. 2  
 ELEVATION \_\_\_\_\_ N. 14 S. \_\_\_\_\_ E. 26 W. \_\_\_\_\_  
 LEASE NO. \_\_\_\_\_ ACRES 44  
 WATERS OF Jakes Run  
 DISTRICT Clay COUNTY Monongalia STATE W. Va.  
 DRILLING COMMENCED 11/7/1896 COMPLETED 1/15/1897 DEPTH 2101 1/2

SANDS	TOP	BOTTOM	ELEV. TOP	DEPTH	PACKERS AND DEPTH SET
Per. COAL OR BIG INJUN	683			10'	Used
Big Injun	2003			8 1/2'	707
1st. pay	2073			6 5/8'	1542
				5 3/15'	1697
					336

INITIAL PROD. No record SAND Big Injun in on 16/15/1897  
 GAS TEST: No DEPTH 2073  
 SHOT: 5 QUARTS 4 to 20  
 REMARKS: (Not drilled through Big Injun)

REPORTED BY [Signature] ABANDONED

47-061-0522