

LATITUDE 39° 40' 00"

9



nationalatlas.gov  
Where We Are

Steve Sherman  
596

00° 00' 00" LONGITUDE



7.5 OGIS topo location

7.5' loc 2.54 S 15' loc \_\_\_\_\_  
                  1.23 W (calc.) \_\_\_\_\_

Company \_\_\_\_\_

Farm \_\_\_\_\_

Quad WADESTOWN 7 1/2'

County MONONGALIA

District BATTELLE

Scale 1140± (TOPO)



WELL LOCATION MAP

File No. 061-0596

LATITUDE 39° 40'

LONGITUDE 80° 22' 30"

NORTH

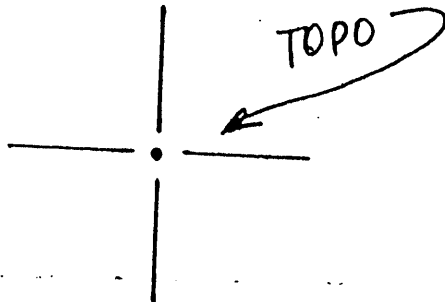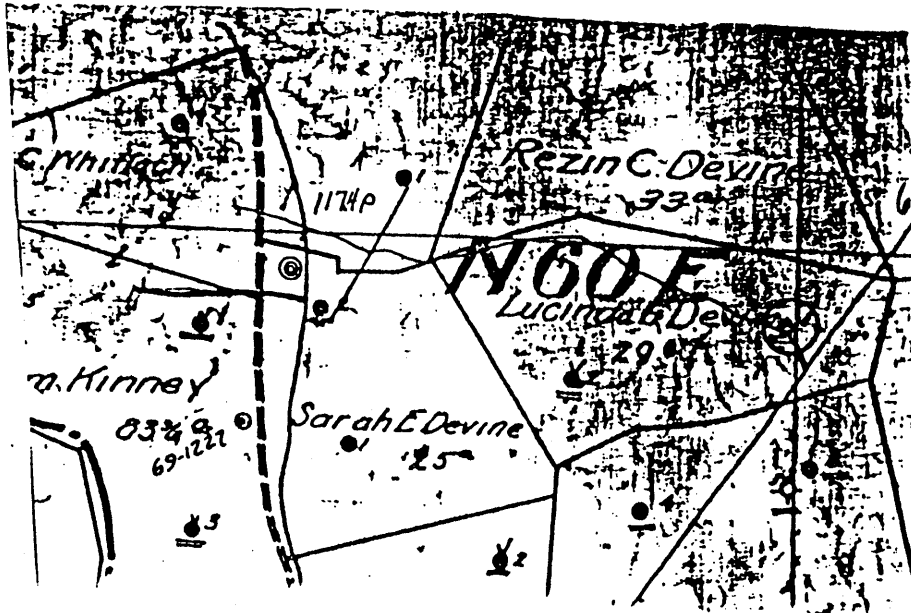

MINIMUM DEGREE OF ACCURACY \_\_\_\_\_  
 PROVEN SOURCE OF ELEVATION \_\_\_\_\_

BY LAW AND THE REGULATIONS ISSUED AND PRESCRIBED BY THE DEPARTMENT OF MINES.

(SIGNED) \_\_\_\_\_  
 R.P.E. \_\_\_\_\_ L.L.S. \_\_\_\_\_

PLACE SEAL HERE

(+) DENOTES LOCATION OF WELL ON UNITED STATES TOPOGRAPHIC MAPS

FORM IV-6  
(8-78)



DATE 7-9, 1979  
 OPERATOR'S WELL NO. 1  
 API WELL NO. 47-061-596  
 STATE COUNTY PERMIT

STATE OF WEST VIRGINIA  
 DEPARTMENT OF MINES  
 OIL AND GAS DIVISION

LOVIE HAUGHT #1

WELL TYPE: OIL  GAS \_\_\_\_\_ LIQUID INJECTION \_\_\_\_\_ WASTE DISPOSAL \_\_\_\_\_  
 (IF "GAS", PRODUCTION \_\_\_\_\_ STORAGE \_\_\_\_\_ DEEP \_\_\_\_\_ SHALLOW   
 LOCATION: ELEVATION \_\_\_\_\_ WATER SHED DUNKARD CREEK  
 DISTRICT BATTELLE COUNTY MONONGALIA  
 QUADRANGLE WADESTOWN 7.5

SURFACE OWNER \_\_\_\_\_ ACREAGE \_\_\_\_\_  
 OIL & GAS ROYALTY OWNER \_\_\_\_\_ LEASE NO. \_\_\_\_\_ LEASE ACREAGE \_\_\_\_\_

PROPOSED WORK: DRILL \_\_\_\_\_ CONVERT \_\_\_\_\_ DRILL DEEPER \_\_\_\_\_ REDRILL \_\_\_\_\_ FRACTURE OR STIMULATE \_\_\_\_\_ PLUS OFF OLD FORMATION \_\_\_\_\_ PERFORATE NEW FORMATION \_\_\_\_\_ OTHER PHYSICAL CHANGE IN WELL (SPECIFY) \_\_\_\_\_

PLUG AND ABANDON \_\_\_\_\_ CLEAN OUT AND REPLUG \_\_\_\_\_  
 TARGET FORMATION \_\_\_\_\_ ESTIMATED DEPTH \_\_\_\_\_  
 WELL OPERATOR WILLIAM R. ICE, AGENT DESIGNATED AGENT WILLIAM R. ICE, AGENT  
 ADDRESS RT 1 BOX 179 FAIRVIEW, WV 26570 ADDRESS RT 1 BOX 179 FAIRVIEW, WV 26570

Well No. 1 *Worcester* District *Worcester* County *Mass*

Rig built by

Well drilled by *D. D. Jones* Contractor.

Began drilling *Jan* 1907 Completed *Feb 17* 1907

ROCK FORMATION.	TOP.	BOTTOM.	REMARKS.
Commenced			
Drilling	3441		
Sand	3441	3450	
with shells	3450	3474	
London sand	3478	3481	
Sand	3481	3495	
Clay	3495	3500	
Sand	3500	3510	
Fourth sand	3512		
1st Clay Oil	3515		
2nd Clay Oil	3521		
Total depth	3528		
	<u>3441</u>		
	87		

BORDON  
+ 4<sup>TH</sup>

474	190		170	6 in. 1/11/13-27 "
				" 6/10/13-20 " "
				" 5/24/13-10 " "
				" 7/2/13-16 " "

Production First 24 Hours } 245 Bbls Signed *D. D. Jones* Supt

061-596