


LATITUDE 39° 42' 30"

88° 00' 00" LONGITUDE

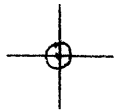

7'5 OGIS topo location

7.5' loc 2.28 S 15' loc _____
 1.96 W (calc.) _____

Company _____

Farm _____

Quad OSAGE 7 1/2'

County MONONGALIA


District CASS

Claw 975± (TOPO)

WELL LOCATION MAP

File No. 061-0610
(SEE 102)

061-610

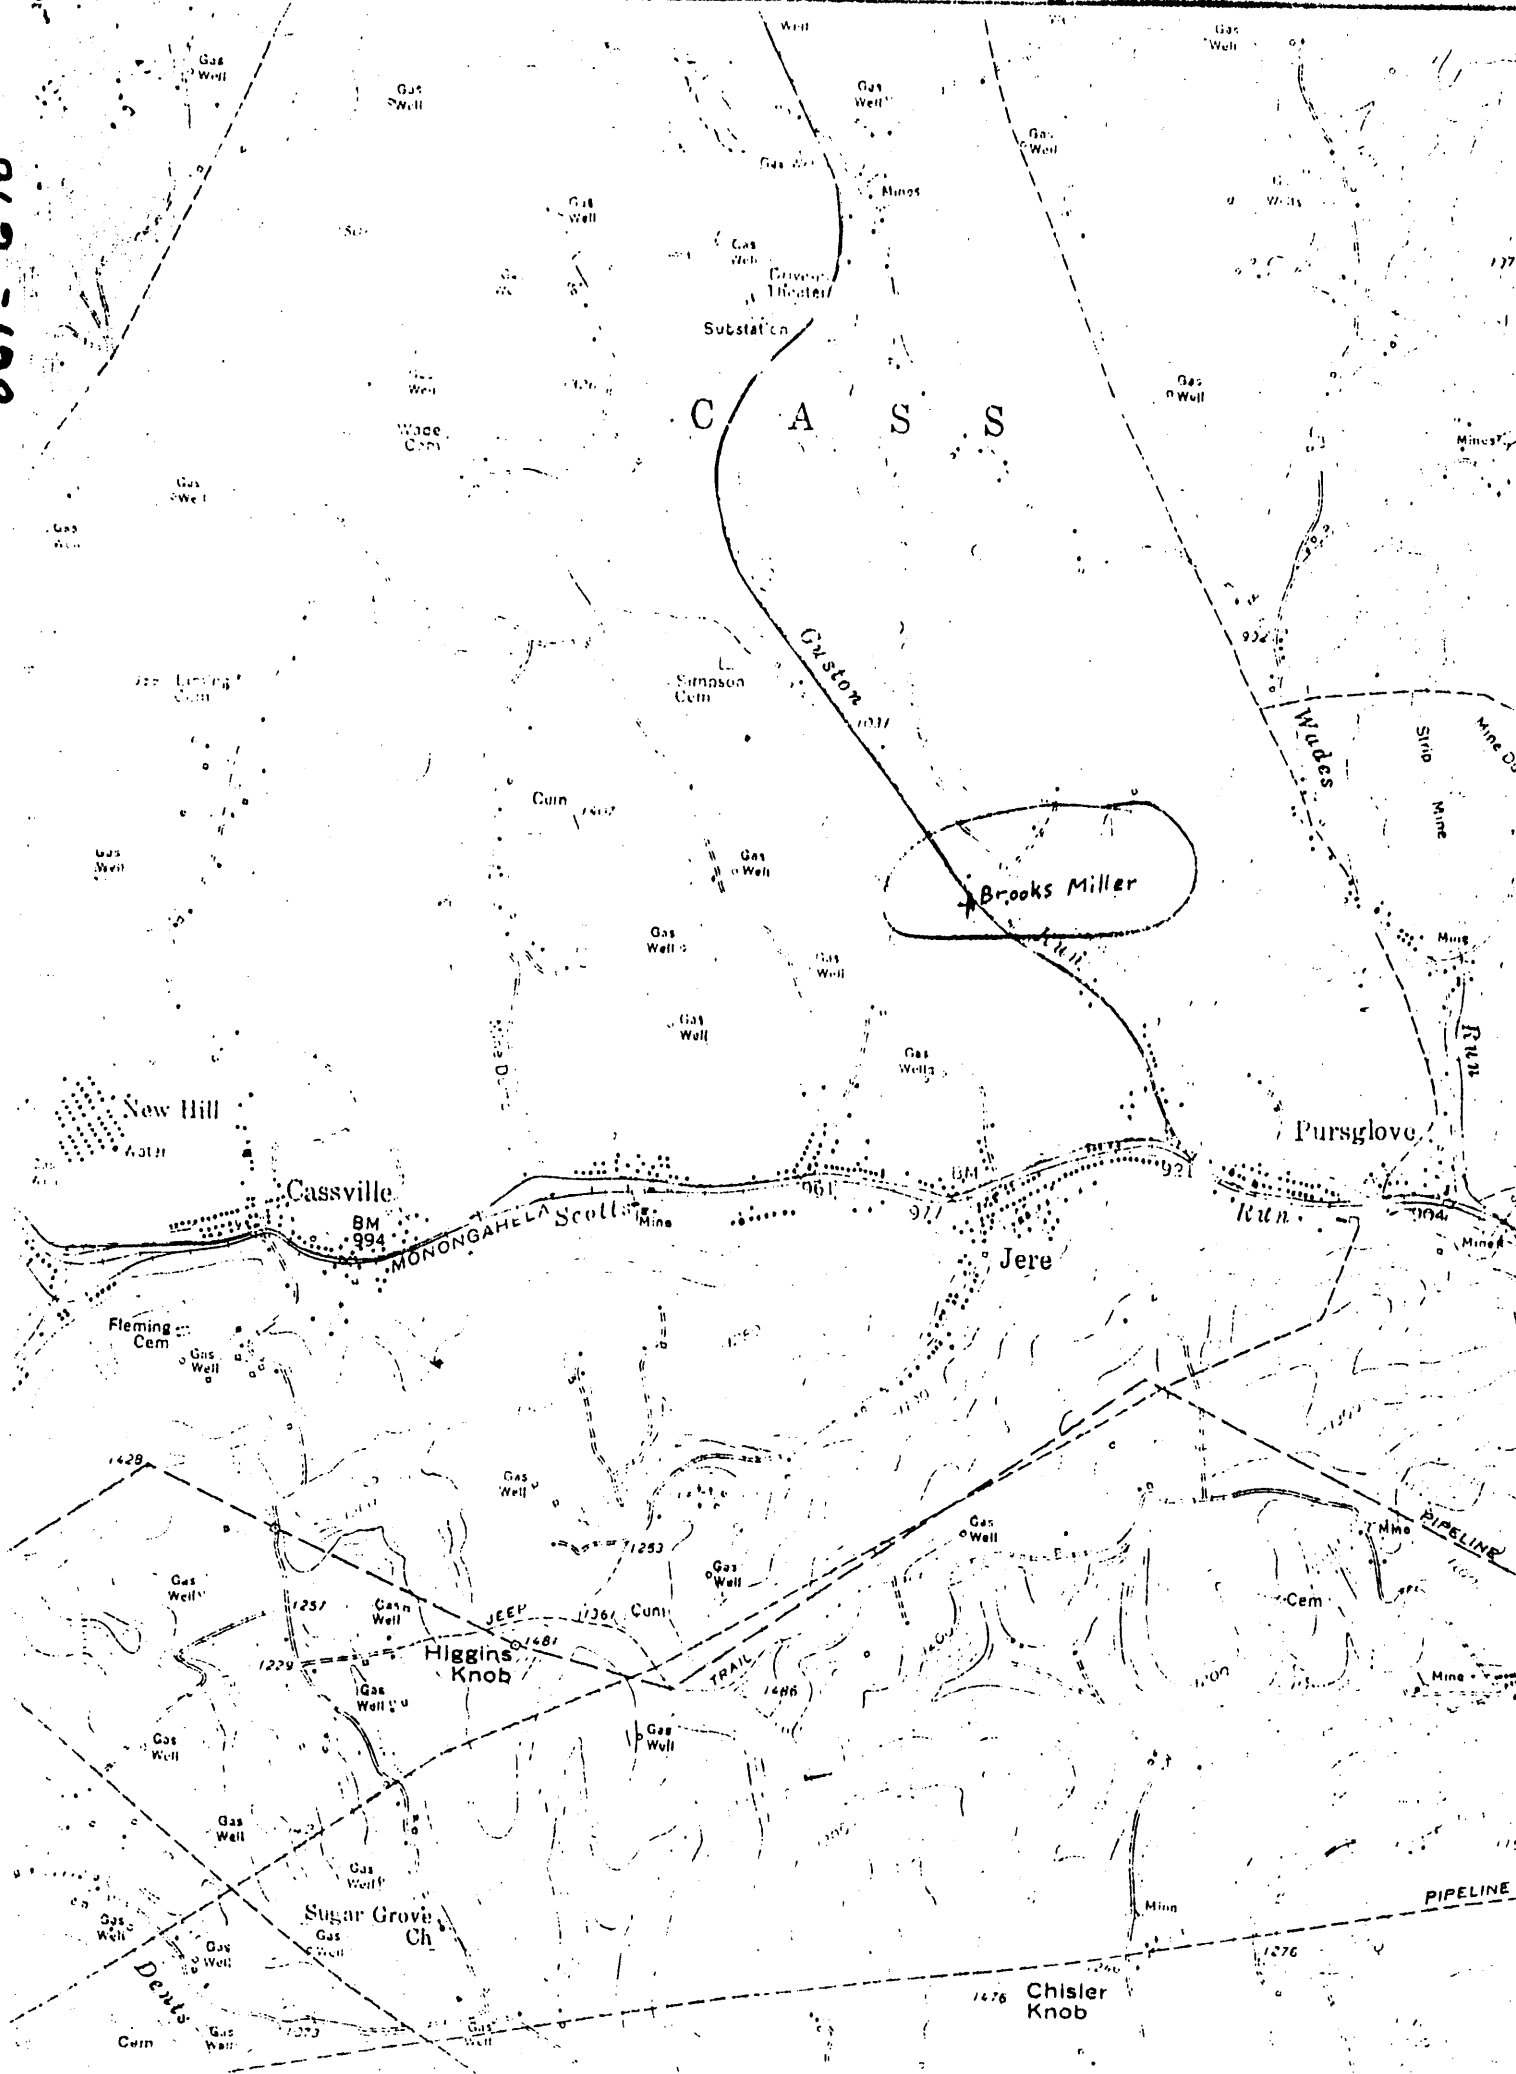

061-610

061-616

WELL NO. #1 LESSOR Brooks Miller LEASE NO. ACRES ELEVATION L DIV. DIST. DATE

W/O NO. DATE CONTRACTOR COMMENCED DATE PURCHASED PURCHASED FROM DATE PURCHASED OUTSIDE SERIAL NO. ROAD TO DATE SOLD DATE PLUGGED AVERAGE ROYALTY % WORKMEN'S COMP NOTICE POSTED DRILLER'S LOG IN FILE

OWNER ADDRESS DATE NOTIFIED LOCATION DATE APPROVED LOCATION DEPARTMENT OF MINES DATA

ANNUAL ALLOWANCE COMSUMER ADDRESS PERCENT ALLOWANCE (O/T) TOTAL DEPTH

FORMATION TOP BOTTOM GAS AT OIL AT WATER AT 100 SAND 100 SAND 30 SAND (METHUEN) SWEET SAND (BLUE ROOM) GON STRAY SAND GORDON SAND (THRO) 4M SAND 4M SAND (ADCOWALDI) 5M SAND BAYARD SAND (SILTH) BAYARD STRAY SAND BAYARD STRAY STR SC ELIZABETH SAND 1M WARREN SAND 2M WARREN SAND SPECTON STRAY SAND SPEEDWLEY SAND SAND 1M SAND 2M SAND SHEPHERD SAND 1M BRADFORD SAND (BENSON) 2M BRADFORD SAND 3M BRADFORD SAND KANE SAND ELK SAND ORISKANY SAND

CLASIFICATION CASING AND TUBING DATA

DATE FROM TO CASING CEMENTED OIL DATA

PIPE LINE DATA DATE TURNED IN LINE DATE DISCONNECTED

REPAIR AND DRILLING DEEPER SHOOTING RECORD

W/O NO. DATE REASON COMMENCED COMPLETED

DATE READING LIQUID OPENING TURNING SIZE MINUTES

DATE READING LIQUID OPENING TURNING SIZE MINUTES

