

D 10-20-80

Latitude 39° 40'


15'

75'

Longitude 80° 07' 30"

(15')

PHYLLIS STATLER

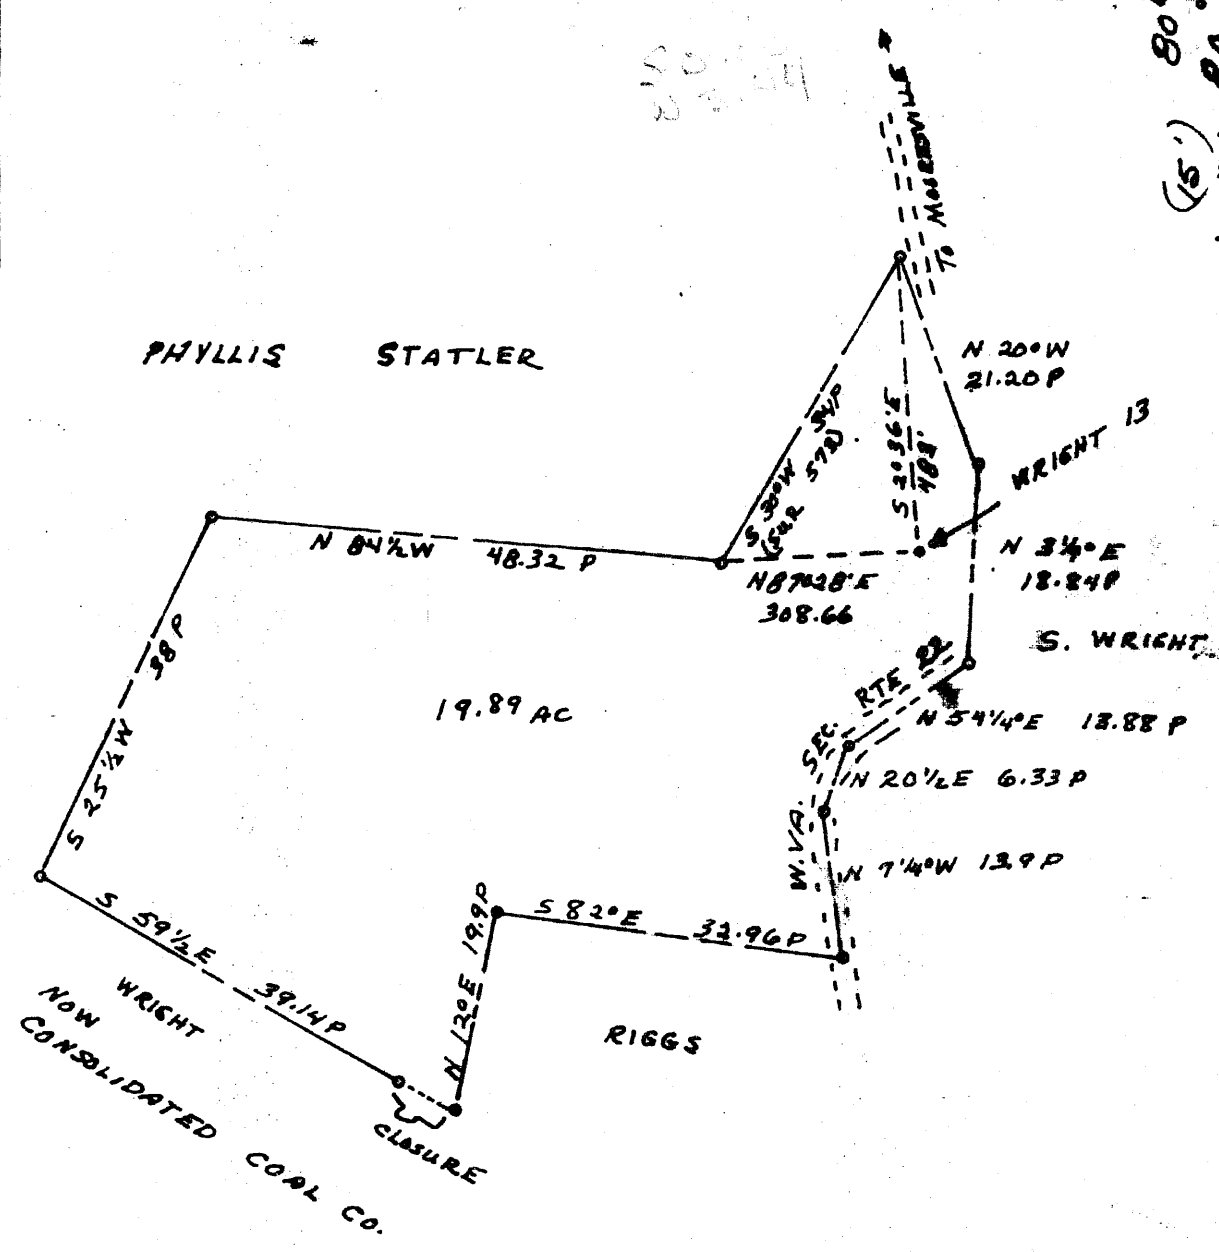

- New Location...
- Drill Deeper...
- Abandonment...

Company KAY MYERS
 Address REYNOLDSVILLE, W.V.
 Mine D.R. Station (New Consol)
 Tract 4 Acres 19.89 Lease No. _____
 Well (Farm) No. WRIGHT 13 Serial No. 1
 Elevation (Spirit Level) _____
 Quadrangle BLACKSVILLE W.V.-PA NW 1/4 T21S
 County Monongalia District CLAY
 Engineer KENNARD P TENNANT
 Engineer's Registration No. 4478
 File No. 2-19E-47H Drawn 10800
 Date 12/8/78 Scale 1" = 400'

STATE OF WEST VIRGINIA
 DEPARTMENT OF MINES
 OIL AND GAS DIVISION
 CHARLESTON

WELL LOCATION MAP
 FILE NO. 08-613-P

• Denotes location of well on United States Topographic Maps, scale 1 to 62,500, latitude and longitude lines being represented by border lines as shown.
 ✎ Denotes one inch spaces on DEEDS of original tracing.

2-19E-47H