


15'

5,760
"00,01,08 E (LONGITUDE)

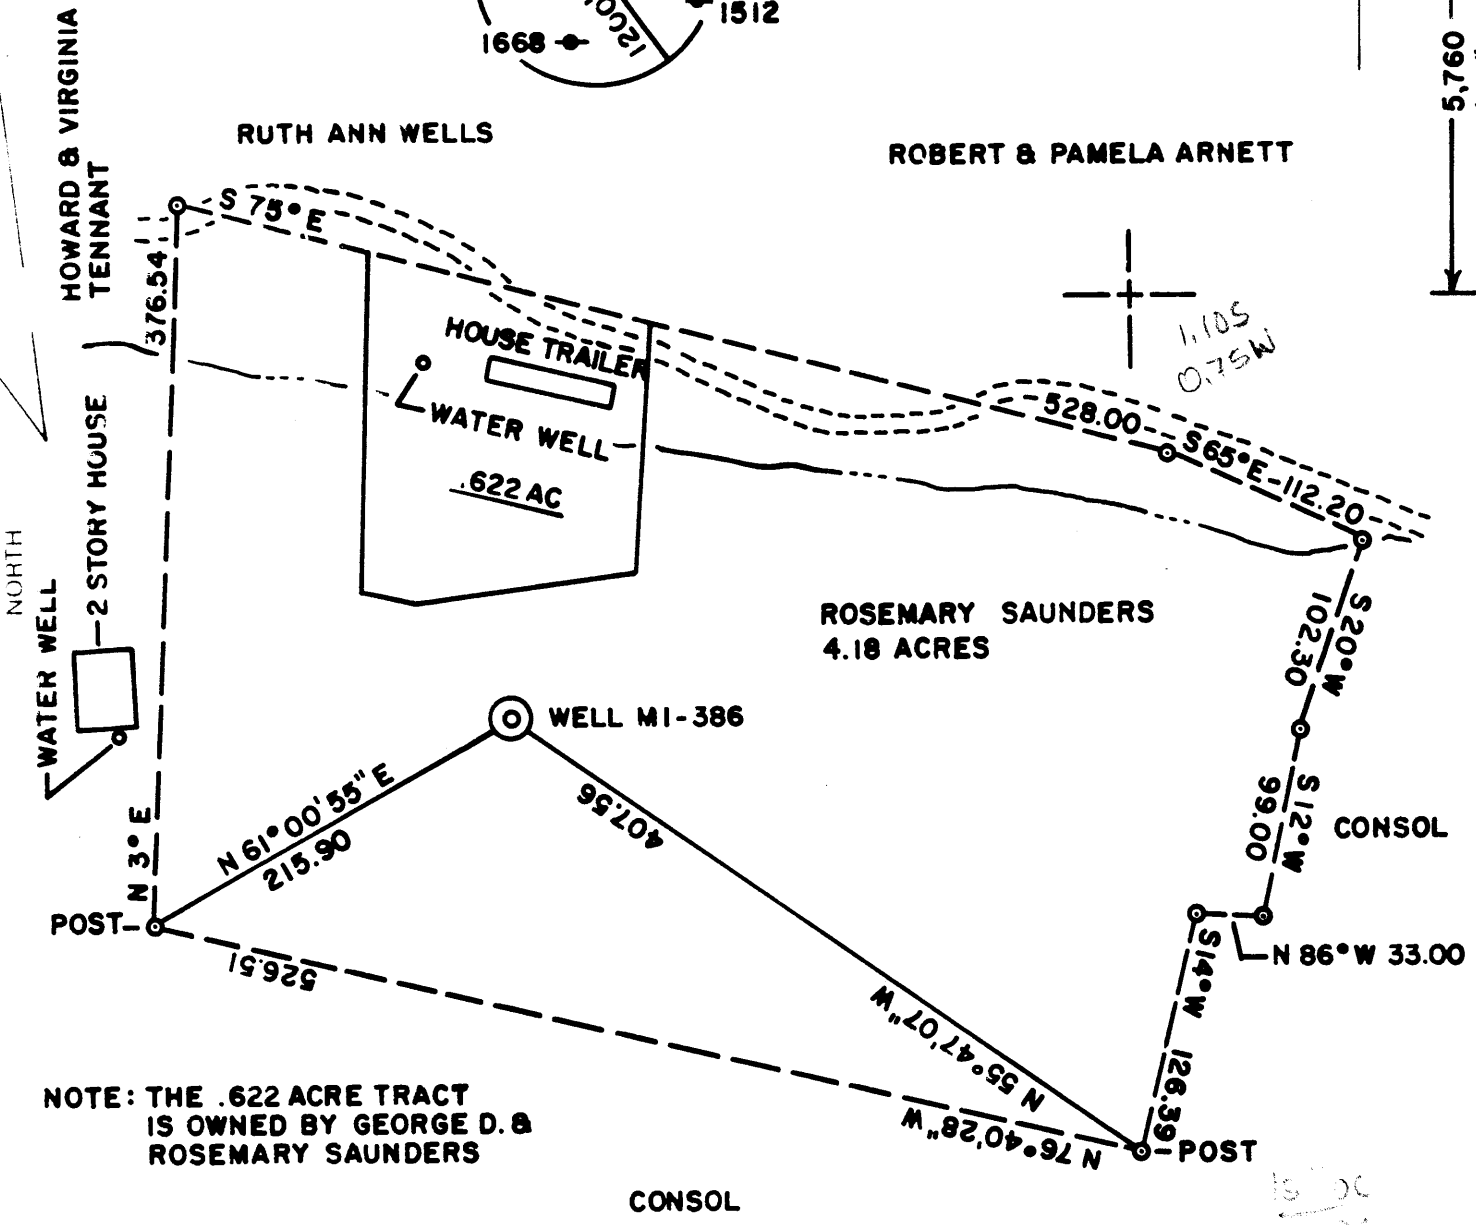

NOTE: THE .622 ACRE TRACT IS OWNED BY GEORGE D. & ROSEMARY SAUNDERS

CONSOL

(+) DENOTES LOCATION OF WELL ON UNITED STATES TOPOGRAPHIC MAPS

FILE NO. _____
 DRAWING NO. _____
 SCALE 1" = 100'
 MINIMUM DEGREE OF ACCURACY 1 IN 5000
 PROVEN SOURCE OF ELEVATION COMPANY SURVEY
TIED INTO THE U.S.G.S. NETWORK

I THE UNDERSIGNED, HEREBY CERTIFY THAT THIS PLAT IS CORRECT TO THE BEST OF MY KNOWLEDGE AND BELIEF AND SHOWS ALL THE INFORMATION REQUIRED BY LAW AND THE REGULATIONS ISSUED AND PRESCRIBED BY THE DEPARTMENT OF MINES.
 (SIGNED) R. Wilson McCoy
 R.P.E. _____ L.L.S. 110

PLACE SEAL HERE

STATE OF WEST VIRGINIA
 DEPARTMENT OF MINES
 OIL AND GAS DIVISION



DATE MARCH 12, 1984
 OPERATOR'S WELL NO. MI-386
 API WELL NO. _____

WELL TYPE: OIL ___ GAS ___ LIQUID INJECTION ___ WASTE DISPOSAL ___ STATE COUNTY PERMIT
 (IF "GAS,") PRODUCTION ___ STORAGE ___ DEEP ___ SHALLOW X ABANDONED X
 LOCATION: ELEVATION 1038.50 WATER SHED JAKES RUN
 DISTRICT CLAY COUNTY MONONGALIA
 QUADRANGLE BLACKSVILLE W.V. PA. 7.5 & 15 W.

SURFACE OWNER ROSEMARY MARIE SAUNDERS ACREAGE 4.18
 OIL & GAS ROYALTY OWNER UNKNOWN LEASE ACREAGE _____

PROPOSED WORK: DRILL ___ CONVERT ___ DRILL DEEPER ___ REDRILL X FRACTURE OR STIMULATE ___ PLUG OFF OLD FORMATION ___ PERFORATE NEW FORMATION ___ OTHER PHYSICAL CHANGE IN WELL (SPECIFY) _____

PLUG AND ABANDON ___ CLEAN OUT AND REPLUG X
 TARGET FORMATION NONE ESTIMATED DEPTH _____
 WELL OPERATOR CONSOLIDATION COAL COMPANY DESIGNATED AGENT ROGER E. DUCKWORTH
 ADDRESS P.O. BOX 1314 MORGANTOWN W.V. 26505 ADDRESS P.O. BOX 1314 MORGANTOWN W.V. 26505

APR 24 1984

FORM IV 5 (8-78) HT. HALL

COUNTY NAME PERMIT

AFFIDAVIT OF PLUGGING AND FILLING WELL

AFFIDAVIT SHOULD BE MADE IN TRIPPLICATE, ONE COPY MAILED TO THE DEPARTMENT, ONE COPY TO BE RETAINED BY THE WELL OPERATOR AND THE THIRD COPY (AND EXTRA COPIES IF REQUIRED) SHOULD BE MAILED TO EACH COAL OPERATOR AT THEIR RESPECTIVE ADDRESSES.

Consolidation Coal Company

Consolidation Coal Company

COAL OPERATOR OR OWNER

NAME OF WELL OPERATOR

P.O. Box 1314 Morgantown, W.Va. 26507

P.O. Box 1314 Morgantown, W.Va. 26507

ADDRESS

COMPLETE ADDRESS

May 3

19 84

COAL OPERATOR OR OWNER

WELL AND LOCATION

Clay

District

ADDRESS

Rosemary Marie Saunders

Monongalia

County

LEASE OR PROPERTY OWNER

Well: No. M1-386

ADDRESS

SAUNDERS

Farm

STATE INSPECTOR SUPERVISING PLUGGING

Don Ellis

AFFIDAVIT

STATE OF WEST VIRGINIA,

County of Monongalia

Larry L. Yost

and David D. Yost

RECEIVED
MAY 1 1984

OIL & GAS DIVISION

DEPT. OF MINES

being first duly sworn according to law depose and say that they are experienced in the work of plugging and filling oil and gas wells and were employed by Consolidation Coal Company well operator, and participated in the work of plugging and filling the above well, that said work was commenced on the 16th day of April, 1984, and that the well was plugged and filled in the following manner:

SAND OR ZONE RECORD	FILLING MATERIAL	PLUGS USED	CASING	
			LOG PULLED	LOG LEFT IN
FORMATION		SIZE & KIND		
Cleaned out to 1204 ft.		2 5/8 tubing	from 1170	to 614
Pulled 64 ft. of 8 5/8 in. casing.		4 1/2" casing	from 614	to surface
Left in hole 8 5/8 in. casing from 524 ft. to clean out depth. Cut 8 5/8 in. at 608 ft. Could not pull.				
Run Coal protection string as follows; 614' of 4 1/2" casing 556' of 2 3/8" tubing				
Circulating cement to surface as follows: Pumped 1000 gal. mud flush 445 sks. of Poz Mix followed by 315 sks. of expanding type cement Displaced cement to 598' with water. Let set and bailed dry.				
COAL SEAMS			DESCRIPTION OF MONUMENT	
61 Pittsburgh Coal	493' to 500'		5 ft. of 4 1/2" casing with plaque stating Consol M1-386	
			47-061-0745-P	

and that the work of plugging and filling said well was completed on the 27th day of April, 1984

And further deponents saith not.

Larry L. Yost
David D. Yost
Kelli D. Weber

Sworn to and subscribed before me this 4th day of May, 1984

My commission expires:

Notary Public.

March 15 1983