


LATITUDE 39°42'30"

7,050'

LONGITUDE 80°15'

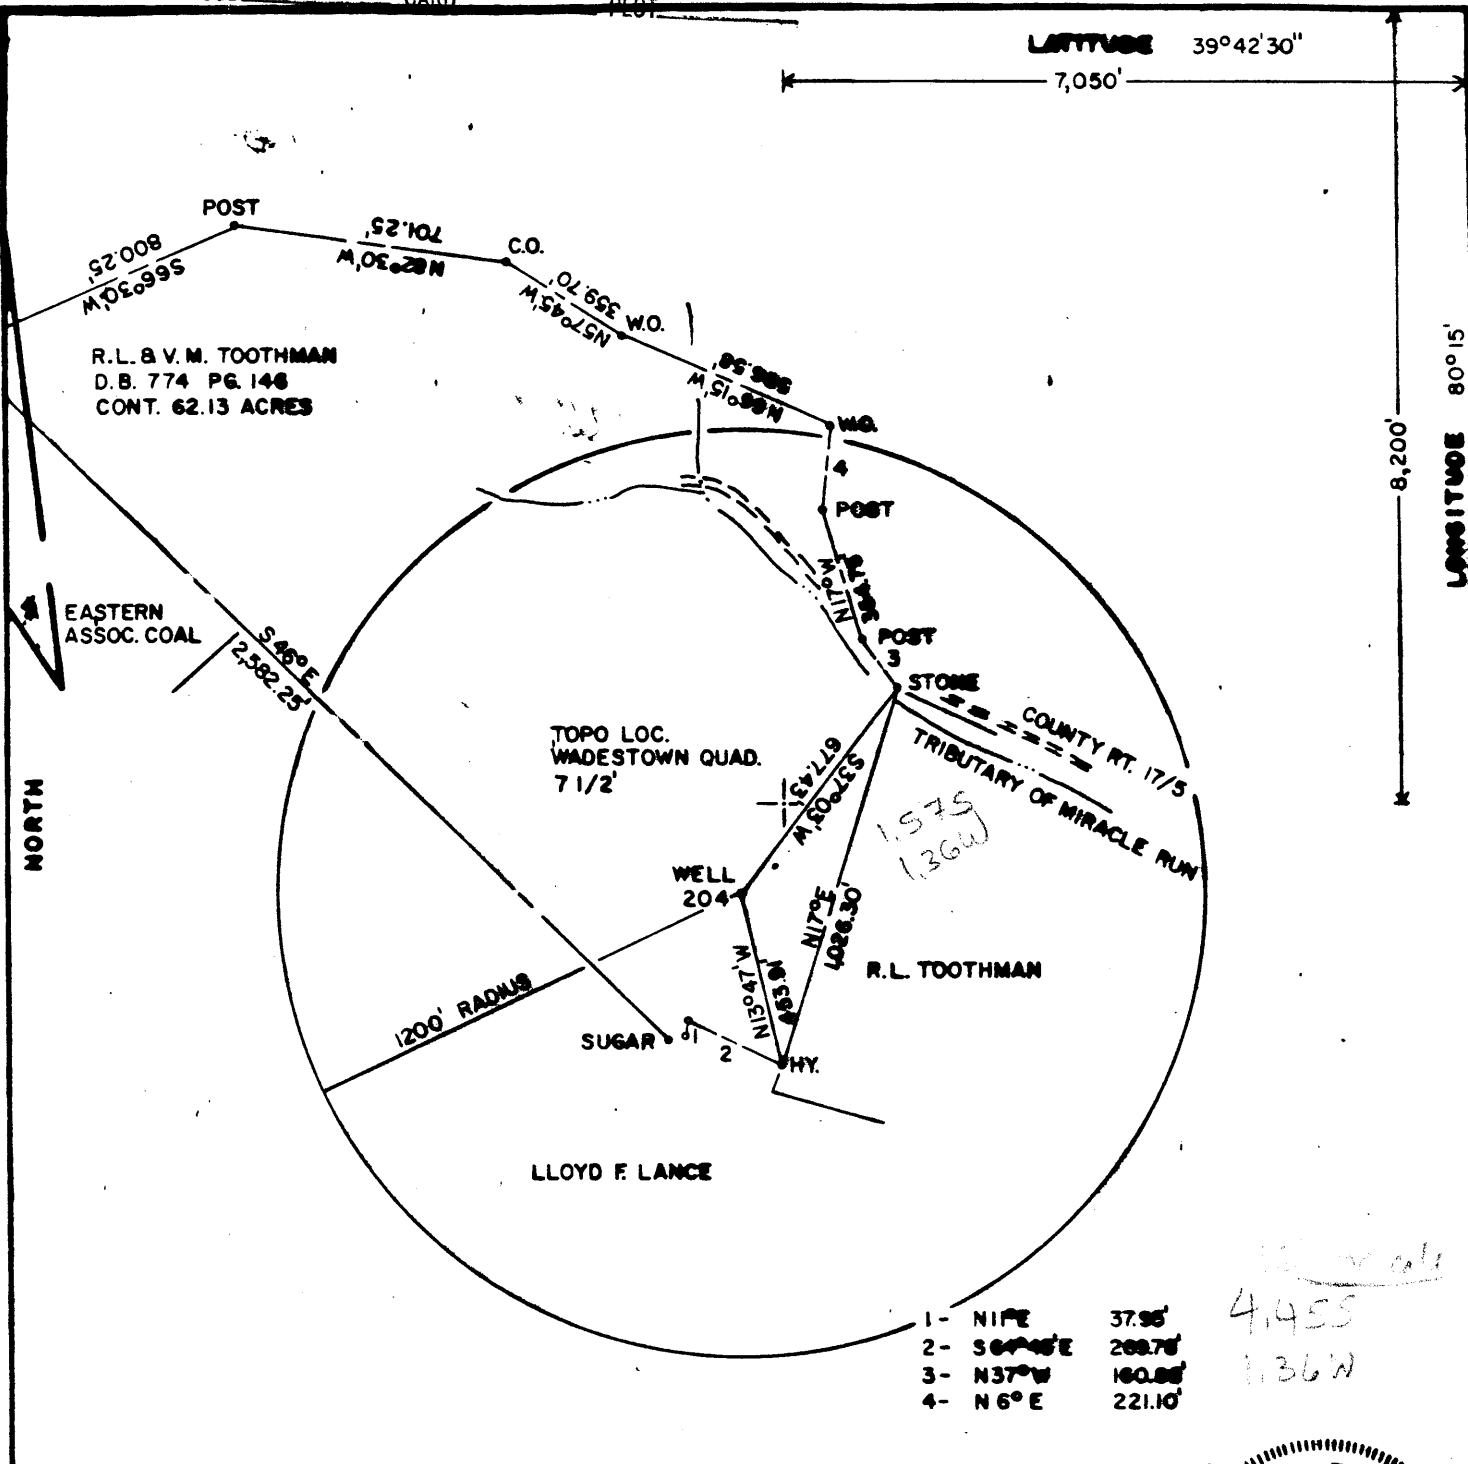


- 1- N19°E 37.95'
- 2- S64°45'E 288.78'
- 3- N37°W 160.88'
- 4- N6°E 221.10'

4,455
1,36W

FILE NO. F2-06-128
 DRAWING NO. F2-2-143
 SCALE 1"=500'
 MINIMUM DEGREE OF ACCURACY 1/2500
 PROVEN SOURCE OF ELEVATION USGS-BM 1014 GRAFTON 1902

I THE UNDERSIGNED, HEREBY CERTIFY THAT THIS PLAT IS CORRECT TO THE BEST OF MY KNOWLEDGE AND BELIEF AND SHOWS ALL THE INFORMATION REQUIRED BY LAW AND THE REGULATIONS ISSUED AND PRESCRIBED BY THE DEPARTMENT OF MINES.
 (SIGNED) Frank Peduti of Feb. 1985
 R.P.E. 9240 L.L.S. _____

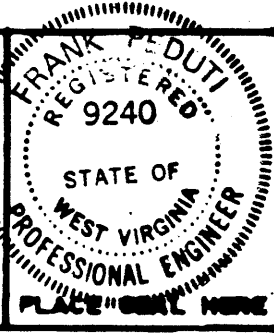

(+) DENOTES LOCATION OF WELL ON UNITED STATES TOPOGRAPHIC MAPS
 FORM IV-6
 (8-78)



DATE FEBRUARY 4, 1985
 OPERATOR'S WELL NO F2-204
 API WELL NO. 47-061-0758-P
 STATE COUNTY PERMIT

STATE OF WEST VIRGINIA
 DEPARTMENT OF MINES
 OIL AND GAS DIVISION

(Wad Hope (4005))

WELL TYPE: OIL GAS LIQUID INJECTION WASTE DISPOSAL
 (IF "GAS", PRODUCTION STORAGE DEEP SHALLOW)
 LOCATION: ELEVATION 1298.00 WATER SINES TRIBUTARY OF MIRACLE RUN
 DISTRICT BATTELLE COUNTY MONONGALIA
 QUADRANGLE WADESTOWN 7 1/2 Charleston 102
 SURFACE OWNER RUSSELL & VIRGINIA TOOTHMAN ACREAGE 62.13
 OIL & GAS ROYALTY OWNER FORMERLY CONSOLIDATED GAS SUPPLY CO. INC. LEASE ACREAGE 103
 LEASE NO. 10432
 PROPOSED WORK: DRILL CONVERT DRILL DEEPER REBRILL FRACTURE OR STIMULATE PLUS OFF OLD FORMATION PERFORATE NEW FORMATION OTHER PHYSICAL CHANGE IN WELL (SPECIFY) _____
 PLUS AND ABANDON CLEAN OUT AND REPLUS _____
 TARGET FORMATION FIFTH SAND ESTIMATED DEPTH 352'
 WELL OPERATOR EASTERN ASSOC. COAL CORP. DESIGNATED AGENT JOHN A. VEITCH
 ADDRESS RT. 1 BOX 144 FAIRVIEW, W. VA. 26570 ADDRESS SAME
 FEB 19 1985

AFFIDAVIT OF PLUGGING AND FILLING WELL

AFFIDAVIT SHOULD BE MADE IN TRIPLICATE, one copy mailed to the Department, one copy to be retained by the Well Operator and the third copy (and extra copies if required) should be mailed to each coal operator at their respective addresses.

Eastern Associated Coal Corp.
Coal Operator or Owner
Rt. 1, Box 144, Fairview, WV 26570
Address

Coal Operator or Owner
Address
Russell & Virginia Toothman
Lease or Property Owner
Rt. 1, Box 25A, Fairview, WV 26570
Address

Eastern Assoc. Coal Corp.
Name of Well Operator
Rt. 1, Box 144, Fairview, WV 26570
Complete Address

April 5 19 85
WELL AND LOCATION
Battelle District
Monongalia County

WELL NO. EACC-F2- 204 (Formerly Hope #4005)
W.L. Parks, 103 acre Farm

STATE INSPECTOR SUPERVISING PLUGGING Don Ellis

AFFIDAVIT

STATE OF WEST VIRGINIA,
County of Monongalia

ss:

Ray Smith

and

Dave Chisler

being first duly sworn according to law depose and say that they are experienced in the work of plugging and filling oil and gas wells and were employed by Chisler Brothers, well operator, and participated in the work of plugging and filling the above well, that said work was commenced on the 4th day of March, 19 85, and that the well was plugged and filled in the following manner:

Sand or Zone Record Formation	Filling Material	Plugs Used Size & Kind	Casing	
			CSG PULLED	CSG LEFT IN
1. Cleaned out well to a depth of 1395'			Set a total	
2. Ran 8" pipe to 988' to drill deeper.			of 1106' of	
3. Put stone bridge to set 4 1/2" pipe on from 1395 to 1368.			4 1/2" casing	
4. Ran 2 3/8" tubing to 1368' to gel hole. Ran 39 sacks gel & got circulation			starting at	
5. Pulled 2 3/8" tubing 1368'			the surface	
6. Ran 4 1/2" pipe to 1368', pulled 988' of 8" pipe.				
7. Ran 16 sacks of gel, 2 bags of lime, and 8 bags paper mulch and got circulation.				
8. Ran 200 bags Chem Comp cement & pulled 4 1/2" pipe to 1106'. Ran 710 bags Portland cement, 200 bags Chem Comp cement. Pumped latch down plug to 1086'.				
9. Ran 2 3/8" tubing down outside 4 1/2" pipe and tagged cement at 206'. Pumped 550 bags Portland Cement and got circulation, pulled 2 3/8" tubing.				
10. Bailed water out of 4 1/2" pipe to top of plug.				
Coal Seams			Description of Monument	
(Name) Pittsburgh 978' to 986'			4 1/2" X 2" swedge with a 2" stop	
(Name)			at surface, 2" pipe with a	
(Name)			metal plate monument welded to	
(Name)			2" pipe.	

and that the work of plugging and filling said well was completed on the 4th day of April, 19 85.

And further deponents saith not.

Sworn to and subscribed before me this 5th day of April, 19 85.

Ray Smith
Dave Chisler
James Moore
Notary Public

My commission expires:

July 14, 1985

Permit No. 47-061-0758-RP