


(+) DENOTES LOCATION OF WELL ON UNITED STATES TOPOGRAPHIC MAPS

FILE NO. _____
 DRAWING NO. _____
 SCALE 1" = 500'
 MINIMUM DEGREE OF ACCURACY 1 IN 5000
 PROVEN SOURCE OF ELEVATION COMPANY SURVEY
TIED INTO THE U.S.G.S. NETWORK

I THE UNDERSIGNED, HEREBY CERTIFY THAT THIS PLAT IS CORRECT TO THE BEST OF MY KNOWLEDGE AND BELIEF AND SHOWS ALL THE INFORMATION REQUIRED BY LAW AND THE REGULATIONS ISSUED AND PRESCRIBED BY THE DEPARTMENT OF MINES.
 (SIGNED) R. Nelson McCoy
 R.P.E. _____ L.L.S. 110

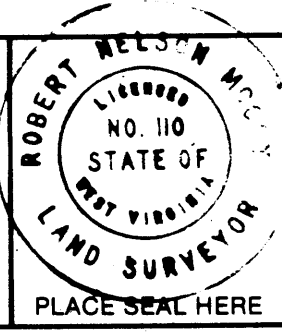

STATE OF WEST VIRGINIA
 DEPARTMENT OF MINES
OIL AND GAS DIVISION

DATE FEBRUARY 17, 19 84
 OPERATOR'S WELL NO. MI-359
 API WELL NO. _____

WELL TYPE: OIL ___ GAS ___ LIQUID INJECTION ___ WASTE DISPOSAL ___
 (IF "GAS,") PRODUCTION ___ STORAGE ___ DEEP ___ SHALLOW X ABANDONED X

LOCATION: ELEVATION 1282.45 WATERSHED JAKES RUN
 DISTRICT CLAY COUNTY MONONGALIA
 QUADRANGLE BLACKSVILLE W.V. - PA. 7.5

SURFACE OWNER M.C. MORAN ACREAGE 39.88
 OIL & GAS ROYALTY OWNER _____ LEASE ACREAGE _____
 LEASE NO. _____

PROPOSED WORK: DRILL ___ CONVERT ___ DRILL DEEPER ___ REDRILL X FRACTURE OR
 STIMULATE ___ PLUG OFF OLD FORMATION ___ PERFORATE NEW
 FORMATION ___ OTHER PHYSICAL CHANGE IN WELL (SPECIFY) _____

PLUG AND ABANDON ___ CLEAN OUT AND REPLUG X
 TARGET FORMATION NONE ESTIMATED DEPTH _____
 WELL OPERATOR CONSOLIDATION COAL COMPANY DESIGNATED AGENT ROGER E. DUCKWORTH
 ADDRESS P.O. BOX 1314 MORGANTOWN W.V. 26505 ADDRESS P.O. BOX 1314 MORGANTOWN W.V. 26505

DATE FEB 10 1985

FORM IV-6 (8-78)
 H.T. HALL

COUNTY NAME
 PERMIT

AFFIDAVIT OF PLUGGING AND FILLING WELL

AFFIDAVIT SHOULD BE MADE IN TRIPPLICATE. ONE COPY MAILED TO THE DEPARTMENT, ONE COPY TO BE RETAINED BY THE WELL OPERATOR AND THE THIRD COPY (AND EXTRA COPIES IF REQUIRED) SHOULD BE MAILED TO EACH COAL OPERATOR AT THEIR RESPECTIVE ADDRESSES.

Consolidation Coal Co.
COAL OPERATOR OR OWNER
P.O. Box 1314, Morgantown, W.Va.
ADDRESS
Same
COAL OPERATOR OR OWNER
ADDRESS
M.C. Moran
LEASE OR PROPERTY OWNER
ADDRESS

Consolidation Coal Co.
NAME OF WELL OPERATOR
BoO. Box 1314, Morgantown, W.Va.
COMPLETE ADDRESS
April 9 1985
WELL AND LOCATION
Clay District
Monongalia County
Well No M1-359
Farm

STATE INSPECTOR SUPERVISING PLUGGING Don Ellis

AFFIDAVIT

RECEIVED
MAY 23 1985

STATE OF WEST VIRGINIA, } SEC


County of Monongalia
Larry L. Yost

and David D. Yost

OIL & GAS DIVISION
DEPT. OF MINES

being first duly sworn according to law depose and say that they are experienced in the work of plugging and filling oil and gas wells and were employed by Consolidation Coal Co. well operator, and participated in the work of plugging and filling the above well, that said work was commenced on the 14th day of March, 1985, and that the well was plugged and filled in the following manner:

SAND OR ZONE RECORD	FILLING MATERIAL	PLUGS USED	CASINGS	
			INS PULLED	INS LEFT IN
FORMATION	Cleaned wellbore to 2230'. Cut 5 1/2" at 1850'; Could not pull.	5 1/2"	1610'	500'
	Cut again at 1610' & pulled. Ran tubing to 2200'; pumped 65 sks of cement. Tagged plug at 1850 ft.	7" 8"	1515' 310'	? ?
	pulled 7" to 1515; pulled 8" to 1070' Cut 8" at 1400' & 1200'. Ran coal protection string as follows: 987' of 4 1/2" Latendown at 962'; float at 987'. Swedge at 987'. Circulated cement to surface as follow: 700-sks. of Poz Mix; 400sks. of expanding type cement; 1000 gal. mud flush. Let set, bailed dry, and set monument.	714' of 2 3/8"		
COAL SEAMS				
NAME) Pittsburgh - 820'				
NAME)				
NAME)				
NAME)				
			DESCRIPTION OF MONUMENT 5 ft. of 4 1/2" casing with plaque stating Consol M1-359 . 47-061-0762-P	

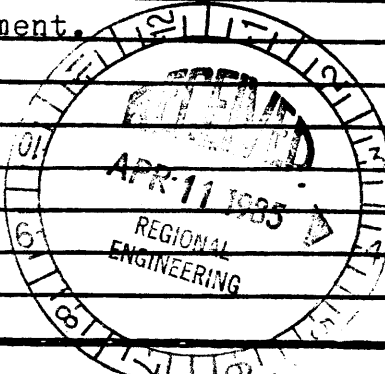

MJ 5-23-85

and that the work of plugging and filling said well was completed on the 3rd day of April, 1985

And further deponents saith not.

Larry L. Yost
David D. Yost

Sworn to and subscribed before me this 3rd day of April, 1985

Janice L. Nelson

My commission expires:

March 11, 1989

Notary Public.

Permit No. 47-061-0762-P