


(+) DENOTES LOCATION OF WELL ON UNITED STATES TOPOGRAPHIC MAPS

FILE NO. \_\_\_\_\_  
 DRAWING NO. \_\_\_\_\_  
 SCALE 1" = 500'  
 MINIMUM DEGREE OF ACCURACY 1 IN 5000  
 PROVEN SOURCE OF ELEVATION COMPANY SURVEY  
TIED INTO THE U.S.G.S. NETWORK

I THE UNDERSIGNED, HEREBY CERTIFY THAT THIS PLAT IS CORRECT TO THE BEST OF MY KNOWLEDGE AND BELIEF AND SHOWS ALL THE INFORMATION REQUIRED BY LAW AND THE REGULATIONS ISSUED AND PRESCRIBED BY THE DEPARTMENT OF MINES.

(SIGNED) R. Nelson McCoy  
 R.P.E. \_\_\_\_\_ L.L.S. 110

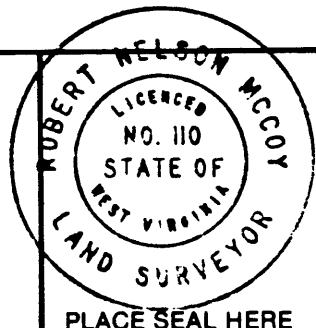

**STATE OF WEST VIRGINIA**  
 DEPARTMENT OF MINES  
 OIL AND GAS DIVISION



DATE FEB. 5, 1985  
 OPERATOR'S WELL NO. MI-532  
 API WELL NO. \_\_\_\_\_

WELL TYPE: OIL \_\_\_ GAS \_\_\_ LIQUID INJECTION \_\_\_ WASTE DISPOSAL \_\_\_ STATE COUNTY PERMIT  
 (IF "GAS,") PRODUCTION \_\_\_ STORAGE \_\_\_ DEEP \_\_\_ SHALLOW X ABANDONED X

LOCATION: ELEVATION 1115.88 WATERSHED DAYS RUN  
 DISTRICT CLAY COUNTY MONONGALIA

QUADRANGLE BLACKSVILLE W.V. PA. 7.5 15162  
 SURFACE OWNER VIRGINIA BUNNER ACREAGE 86.71

OIL & GAS ROYALTY OWNER UNKNOWN LEASE ACREAGE \_\_\_\_\_

PROPOSED WORK: DRILL \_\_\_ CONVERT \_\_\_ DRILL DEEPER \_\_\_ REDRILL X FRACTURE OR  
 STIMULATE \_\_\_ PLUG OFF OLD FORMATION \_\_\_ PERFORATE NEW  
 FORMATION \_\_\_ OTHER PHYSICAL CHANGE IN WELL (SPECIFY) \_\_\_\_\_

PLUG AND ABANDON \_\_\_ CLEAN OUT AND REPLUG X  
 TARGET FORMATION NONE ESTIMATED DEPTH \_\_\_\_\_

WELL OPERATOR CONSOLIDATION COAL COMPANY DESIGNATED AGENT ROGER E. DUCKWORTH

ADDRESS P.O. BOX 1314 MORGANTOWN W.V. 26505 ADDRESS P.O. BOX 1314 MORGANTOWN W.V. 26505

FORM IV-6 (8-78)  
 H.T. HALL

COUNTY NAME  
 PERMIT

APR 01 1985



STATE OF WEST VIRGINIA  
DEPARTMENT OF MINES  
OIL AND GAS WELLS DIVISION

AFFIDAVIT OF PLUGGING AND FILLING WELL

AFFIDAVIT SHOULD BE MADE IN TRIPPLICATE. ONE COPY MAILED TO THE DEPARTMENT. ONE COPY TO BE RETAINED BY THE WELL OPERATOR AND THE THIRD COPY (AND EXTRA COPIES IF REQUIRED) SHOULD BE MAILED TO EACH COAL OPERATOR AT THEIR RESPECTIVE ADDRESSES.

<u>Consolidation Coal Company</u> COAL OPERATOR OR OWNER P. O. Box 1314, Morgantown, WV 26507-1314 ADDRESS	<u>Consolidation Coal Company</u> NAME OF WELL OPERATOR P. O. Box 1314, Morgantown, WV 26507-1314 COMPLETE ADDRESS
<u>Consolidation Coal Company</u> COAL OPERATOR OR OWNER P.O. Box 1314, Morgantown, W.Va. 26507 ADDRESS	<u>October 2</u> 19 <u>85</u> WELL AND LOCATION
<u>Virginia Runner</u> LEASE OR PROPERTY OWNER Rt.2 Fairview, W.Va. ADDRESS	<u>Clay</u> District <u>Monongalia</u> County Well No. <u>MT-532</u> Farm


STATE INSPECTOR SUPERVISING PLUGGING Don Ellis

AFFIDAVIT

STATE OF WEST VIRGINIA,  
County of Monongalia } ss:

Larry L. Yost and David D. Yost  
being first duly sworn according to law depose and say that they are experienced in the work of plugging and filling oil and gas wells and were employed by Consolidation Coal Co. well operator, and participated in the work of plugging and filling the above well, that said work was commenced on the 13th day of September, 1985, and that the well was plugged and filled in the following manner:

BAND OR ZONE RECORD FORMATION	FILLING MATERIAL	PLUGS USED SIZE & KIND	CASING	
			CSG PULLED	CSG LEFT IN
	Cleaned wellbore to 1362'. Made 10 cuts from 712' to	8 1/2" casing	-	1235' to 9
	685'. Made cuts at 621' & 557'. Ran coal protection	10" casing		386' to 7
	string as follows; 841' of 1 1/2" casing; 502' of 3 1/2" tubing			
	Batchdown at 820'; Float at 811'; Swedge at 811'. Circulated cement to surface as follows: 670 sks. of Fox Mix; 465 sks. of Thizetopic; 1,000 gal. of mud flush. Set Set, bailed dry, set monument.			
COAL BEAMS (NAME) Pittsburgh- 700'				
(NAME)				
(NAME)				
(NAME)				
				DESCRIPTION OF MONUMENT 5 ft. of 4 1/2" casing with plaque stating Consol M1-532. 47-61-0769-P

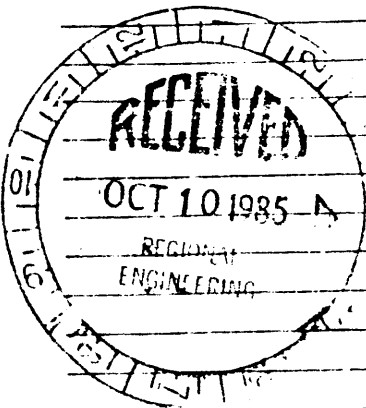

*M. J. 10/21/85*

and that the work of plugging and filling said well was completed on the 1st day of October, 1985

And further deponents saith not.

Sworn to and subscribed before me this 1st day of October, 1985

Larry L. Yost  
David D. Yost  
John D. Robinson

My commission expires: March 10 1993

Notary Public.

Permit No. 47-61-0769-P