

6100781 P

RECEIVED
Office of Oil and Gas

MAY 20 2016

WV Department of
Environmental Protection

WW-7
8-30-06



West Virginia Department of Environmental Protection
Office of Oil and Gas

WELL LOCATION FORM: GPS

API: 47-061-00781 WELL NO.: 2

FARM NAME: J.M. Tennant

RESPONSIBLE PARTY NAME: Noumenon Corporation

COUNTY: Monongalia DISTRICT: Clay

QUADRANGLE: Blacksville, WV

SURFACE OWNER: Rebecca B. and G. W. Moore Estate, Et.Al.

ROYALTY OWNER: Not Producing

UTM GPS NORTHING: 426466.585 = 4391339.860N

UTM GPS EASTING: 1779222.575 = 570983.485E GPS ELEVATION: 1102.18

The Responsible Party named above has chosen to submit GPS coordinates in lieu of preparing a new well location plat for a plugging permit or assigned API number on the above well. The Office of Oil and Gas will not accept GPS coordinates that do not meet the following requirements:

1. Datum: NAD 1983, Zone: 17 North, Coordinate Units: meters, Altitude: height above mean sea level (MSL) – meters.
2. Accuracy to Datum – 3.05 meters
3. Data Collection Method:

Survey grade GPS : Post Processed Differential

Real-Time Differential

Mapping Grade GPS : Post Processed Differential

Real-Time Differential

4. Letter size copy of the topography map showing the well location.

I the undersigned, hereby certify this data is correct to the best of my knowledge and belief and shows all the information required by law and the regulations issued and prescribed by the Office of Oil and Gas.

President


5/20/2016

Signature

Title


Date

06/17/2016

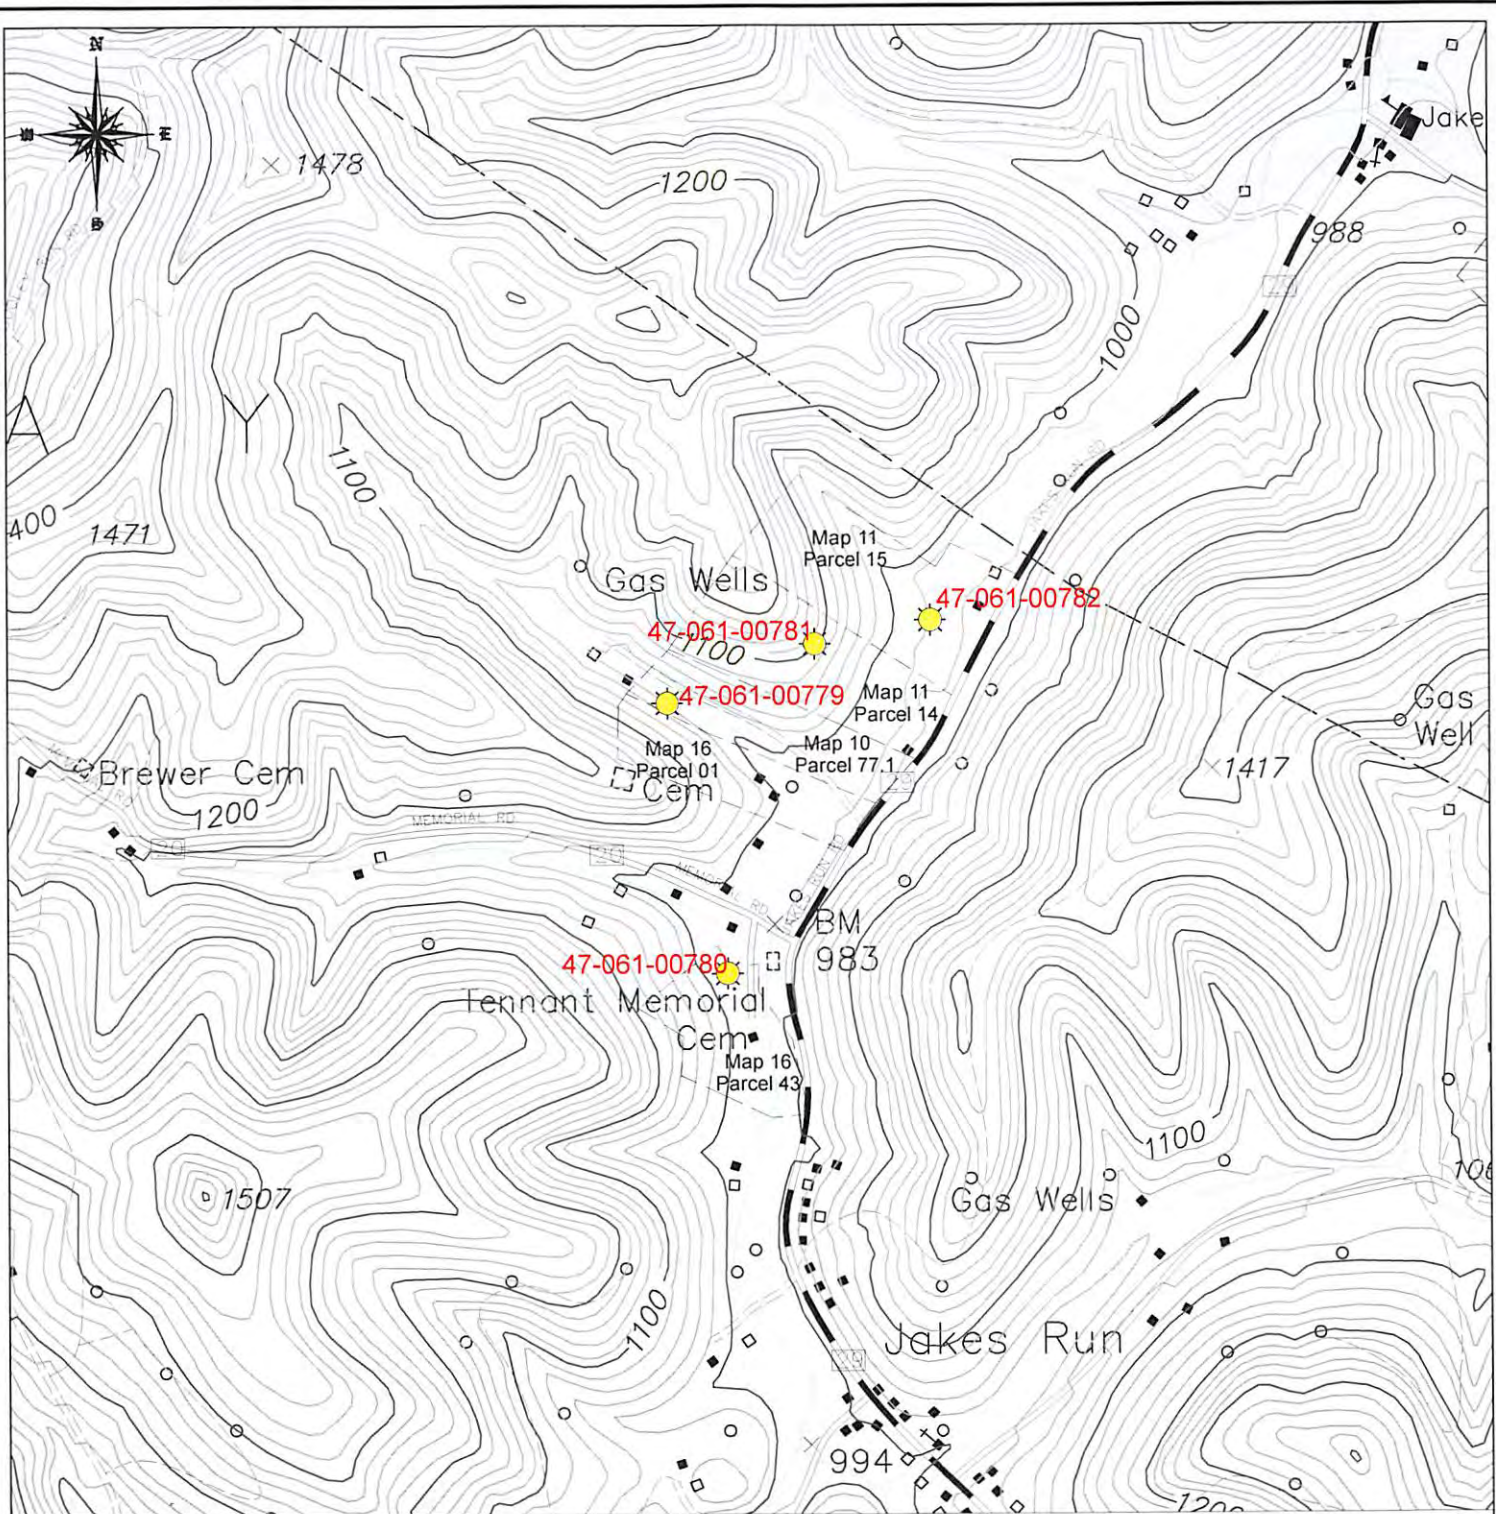

LEGEND

GAS WELL
 LATITUDE: 39 40 08.9
 LONGITUDE: 80 10 20.5
 ELEVATION: 1114'

HAND HELD GPS SURVEYED WELL LOCATION 

PROPERTY LINE - - - - -

0FT 1000FT 2000FT



LOCATION MAP

NOUMENON CORPORATION
 2461 MASON DIXON HIGHWAY CORE, WV 26541

RECEIVED
 Office of Oil and Gas
 API WELL NO. - 47-061-00781
 OPERATOR'S WELL NO. - 1 - JM TENNANT

MAY 16 2016
 CLAY DISTRICT - MONONGALIA COUNTY, WV
 7.5 MINUTE SERIES - 20' CONTOUR INTERVAL
 BLACKSBURG, WV TOPO QUAD

WV Department of Environmental Protection

06/17/2016