



M-J 4-11-85

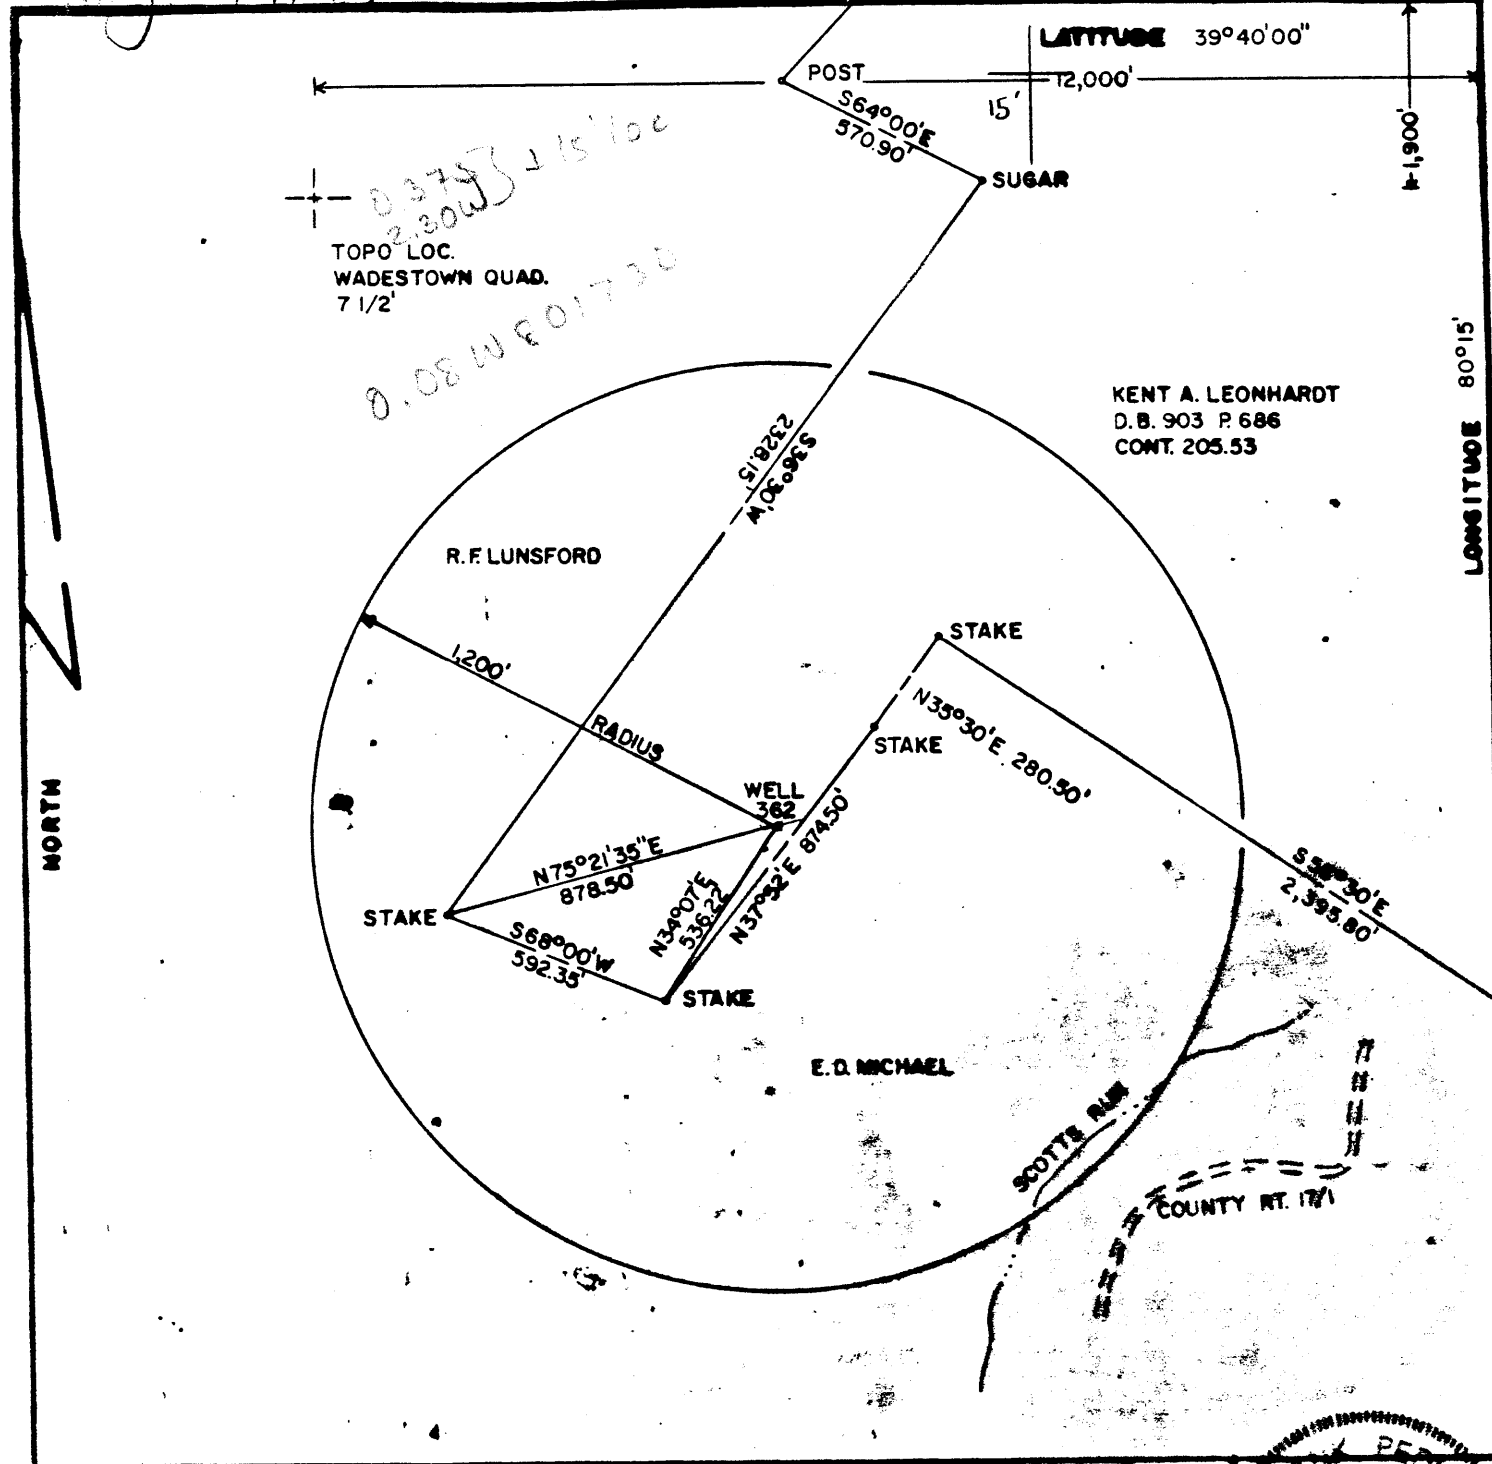

KENT A. LEONHARDT
D.B. 903 P. 686
CONT. 205.53

FILE NO. F2-OG-150
DRAWING NO. F2-2-147
SCALE 1" = 500'
MINIMUM DEGREE OF ACCURACY 1/2500
PROVEN SOURCE OF ELEVATION USGS-BM "1014 GRAB ON 1902"

I THE UNDERSIGNED, HEREBY CERTIFY THAT THIS PLAT IS CORRECT TO THE BEST OF MY KNOWLEDGE AND BELIEF AND SHOWS ALL THE INFORMATION REQUIRED BY LAW AND THE REGULATIONS ISSUED AND PRESCRIBED BY THE DEPARTMENT OF MINES.
(SIGNED) Frank Peduti 22 March 1985
R.P.E. 9240 L.L.S. _____

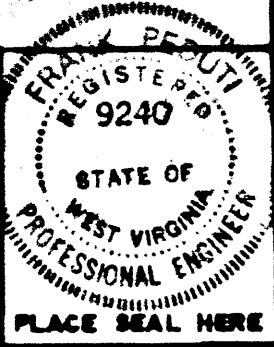

(+) DENOTES LOCATION OF WELL ON UNITED STATES TOPOGRAPHIC MAPS
FORM IV-6'
(8-78)



DATE MARCH 21, 19 85
OPERATOR'S WELL NO F2-362
API WELL NO. 47-061-0791-P
STATE COUNTY PERMIT

STATE OF WEST VIRGINIA
DEPARTMENT OF MINES
OIL AND GAS DIVISION

WELL TYPE: OIL GAS LIQUID INJECTION WASTE DISPOSAL
(IF "GAS", PRODUCTION STORAGE DEEP SHALLOW
LOCATION: ELEVATION 1,518' WATER SHED SCOTTS RUN
DISTRICT BATTELLE COUNTY MONONGALIA
QUADRANGLE WADESTOWN 7 1/2'
SURFACE OWNER KENT A. LEONHARDT ACREAGE 205.53
OIL & GAS ROYALTY OWNER CONSOLIDATED GAS SUPPLY CORP. LEASE ACREAGE 295
LEASE NO. 61831
PROPOSED WORK: DRILL CONVERT DRILL DEEPER REDRILL FRACTURE OR STIMULATE PLUS OFF OLD FORMATION PERFORATE NEW FORMATION OTHER PHYSICAL CHANGE IN WELL (SPECIFY) _____
PLUS AND ABANDON CLEAN OUT AND REPLUG _____
TARGET FORMATION FIFTH SAND ESTIMATED DEPTH 3,850
WELL OPERATOR EASTERN ASSOC. COAL CORP. DESIGNATED AGENT JOHN A. VEITCH
ADDRESS RT. 1 BOX 144 FAIRVIEW W.VA. 26570 ADDRESS SAME

APR 22 1985

JAN 29 1986

AFFIDAVIT OF PLUGGING AND FILLING WELL

AFFIDAVIT SHOULD BE MADE IN TRIPPLICATE, one copy mailed to the Department, one copy to be retained by the Well Operator and the third copy (and extra copies if required) should be mailed to each coal operator at their respective addresses.

Eastern Associated Coal Corp.
Coal Operator or Owner
Rt. 1, Box 144, Fairview, WV
Address
Coal Operator or Owner
Address
Kent A. Leonhardt
Lease or Property Owner
8230 Lexington Dr., Severn, MD 21144
Address

Eastern Associated Coal Corp.
Name of Well Operator
Rt. 1, Box 144, Fairview, WV 26570
Complete Address
June 10, 19 85
WELL AND LOCATION
Battelle District
Monongalia County
WELL NO. EACC-F2-362
Lemasters 295 Ac. Farm

STATE INSPECTOR SUPERVISING PLUGGING Don Ellis

AFFIDAVIT

STATE OF WEST VIRGINIA,
County of Monongalia

ss:

Ray Smith and David Chisler

being first duly sworn according to law depose and say that they are experienced in the work of plugging and filling oil and gas wells and were employed by Chisler Brothers, well operator, and participated in the work of plugging and filling the above well, that said work was commenced on the 7th day of May, 19 85, and that the well was plugged and filled in the following manner:

Sand or Zone Record Formation	Filling Material	Plugs Used Size & Kind	Casing	
			CSG PULLED	CSG LEFT IN
1. Cleaned well out to 1986'			Left 8" casing	in place from surface to 1360.
2. Ran 2 3/8" tubing to 1983', pumped 5 sacks of gel and got circulation.				
3. Ran 200 bags of Chem Comp cement and pulled 1983' of 2 3/8" tubing.				
4. Tagged cement at 1345'.				
5. Bailed water out of 8" pipe.				
Coal Seams			Description of Monument	
(Name) Pittsburgh 1264 to 1272			4 1/2" X 2" swedge with a 2" stop at surface. 2" pipe with a metal plate monument welded to 2" pipe.	
(Name)				
(Name)				
(Name)				

and that the work of plugging and filling said well was completed on the 28th day of May, 19 85.

And further deponents saith not.

Sworn to and subscribed before me this 11th day of June, 19 85.

Ray Smith
David Chisler
James Morris
Notary Public

My commission expires:

July 14, 1985