



(+) DENOTES LOCATION OF WELL ON UNITED STATES TOPOGRAPHIC MAPS

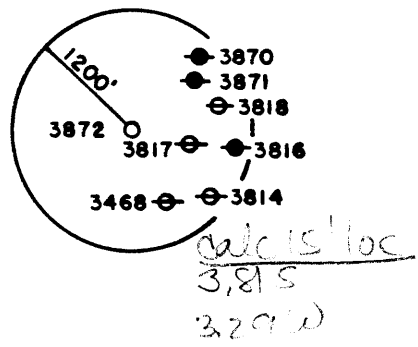

FILE NO. \_\_\_\_\_  
 DRAWING NO. \_\_\_\_\_  
 SCALE 1" = 200'  
 MINIMUM DEGREE OF ACCURACY 1 IN 5000  
 PROVEN SOURCE OF ELEVATION COMPANY SURVEY  
 TIED INTO THE U.S.G.S. NETWORK

I THE UNDERSIGNED, HEREBY CERTIFY THAT THIS PLAT IS CORRECT TO THE BEST OF MY KNOWLEDGE AND BELIEF AND SHOWS ALL THE INFORMATION REQUIRED BY LAW AND THE REGULATIONS ISSUED AND PRESCRIBED BY THE DEPARTMENT OF MINES.  
 (SIGNED) R. Nelson McCoy  
 R.P.E. \_\_\_\_\_ L.L.S. 118

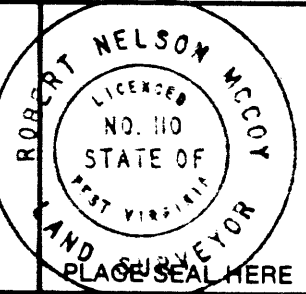

**STATE OF WEST VIRGINIA**  
 DEPARTMENT OF MINES  
 OIL AND GAS DIVISION



DATE FEBRUARY 28, 19 85  
 OPERATOR'S WELL NO. 3872  
 API WELL NO. \_\_\_\_\_

WELL TYPE: OIL  GAS  LIQUID INJECTION  WASTE DISPOSAL   
 (IF "GAS,") PRODUCTION  STORAGE  DEEP  SHALLOW  ABANDONED

LOCATION: ELEVATION 1585.60 WATERSHED MIRACLE RUN  
 DISTRICT BATTELLE COUNTY MONONGALIA  
 QUADRANGLE MANNINGTON, W.V. 7.5 + 15 EC.

SURFACE OWNER OAKIE WALLS ACREAGE 13.67  
 OIL & GAS ROYALTY OWNER UNKNOWN LEASE ACREAGE \_\_\_\_\_

LEASE NO. \_\_\_\_\_  
 PROPOSED WORK: DRILL  CONVERT  DRILL DEEPER  REDRILL  FRACTURE OR STIMULATE  PLUG OFF OLD FORMATION  PERFORATE NEW FORMATION  OTHER PHYSICAL CHANGE IN WELL (SPECIFY) \_\_\_\_\_

PLUG AND ABANDON  CLEAN OUT AND REPLUG   
 TARGET FORMATION NONE ESTIMATED DEPTH \_\_\_\_\_

WELL OPERATOR CONSOLIDATION COAL COMPANY DESIGNATED AGENT ROGER E. DUCKWORTH  
 ADDRESS P.O. BOX 1314 MORGANTOWN, W.V. 26505 ADDRESS P.O. BOX 1314 MORGANTOWN, W.V. 26505

NOV 4 1985

FORM IV-6 (8-78)  
 H.T. HALL

COUNTY NAME  
 PERMIT



AFFIDAVIT OF PLUGGING AND FILLING WELL

DIVISION OF OIL & GAS  
DEPARTMENT OF ENERGY

AFFIDAVIT SHOULD BE MADE IN TRIPLICATE, one copy mailed to the Department, one copy to be retained by the Well Operator and the third copy (and extra copies if required) should be mailed to each coal operator at their respective addresses.

Consolidation Coal Company  
Coal Operator or Owner  
P.O. Box 1314, Morgantown, WV 26507-1314  
Address

Consolidation Coal Company  
Coal Operator or Owner  
P.O. Box 1314, Morgantown, WV 26507-1314  
Address

Oakie Walls  
Lease or Property Owner  
Blacksville, WV 26521  
Address

Consolidation Coal Company  
Name of Well Operator  
P.O. Box 1314, Morgantown, WV 26507-1314  
Complete Address

January 15, 19 86  
WELL AND LOCATION

\_\_\_\_\_ District

Monongalia County

WELL NO. Consol 3872

Oakie Walls Farm

STATE INSPECTOR SUPERVISING PLUGGING Don Ellis, Fairmont, WV 26554

AFFIDAVIT

STATE OF WEST VIRGINIA,  
County of Monongalia

ss:

Calvin C. Lofton and Mark Wright  
being first duly sworn according to law depose and say that they are experienced in the work of plugging and filling oil and gas wells and were employed by Consolidation Coal Company, well operator, and participated in the work of plugging and filling the above well, that said work was commenced on the 27th day of December, 19 85, and that the well was plugged and filled in the following manner:

Sand or Zone Record Formation	Filling Material	Plugs Used Size & Kind	Casing	
			CSG PULLED	CSG LEFT IN
Cleaned out wellbore to 1,700 feet. Extreme caving down to top of casing. Pulled 223 feet of 8 inch casing. Ran coal protection string as follows: 274.84 feet of 2 3/8 inch tubing followed by 1,407.90 feet of 4 1/2 inch casing. Latch down plug at 1,380.54 feet. Float valve at 1,407.70 feet. Circulated cement to surface as follows: Pumped 1,000 sacks of poz mix followed by 150 sacks of expanding cement. Displaced cement to 1,380.54 feet with water. Let set. Bailed dry. Total plug 1,682.74 feet.				
Coal Seams				
(Name) Pittsburgh 1276 feet to 1,282 feet				
(Name)				
(Name)				
(Name)				

*Mark Wright* 11/16/87  
Description of Monument

and that the work of plugging and filling said well was completed on the 9th day of January, 19 86.

And further deponents saith not.

Sworn to and subscribed before me this 15th day of January, 19 86.

Calvin C. Lofton  
Mark Wright

J. R. Emmit  
Notary Public

NOV 23 1987

My commission expires:  
September 08, 1988

Permit No. 47-061-0802-P