


(+) DENOTES LOCATION OF WELL ON UNITED STATES TOPOGRAPHIC MAPS

FILE NO. _____
 DRAWING NO. _____
 SCALE 1" = 500'
 MINIMUM DEGREE OF ACCURACY 1 IN 5000
 PROVEN SOURCE OF ELEVATION COMPANY SURVEY
TIED INTO THE U.S.G.S. NETWORK

I THE UNDERSIGNED, HEREBY CERTIFY THAT THIS PLAT IS CORRECT TO THE BEST OF MY KNOWLEDGE AND BELIEF AND SHOWS ALL THE INFORMATION REQUIRED BY LAW AND THE REGULATIONS ISSUED AND PRESCRIBED BY THE DEPARTMENT OF ENERGY.
 (SIGNED) R. Nelson McCoy
 R.P.E. _____ L.L.S. 10

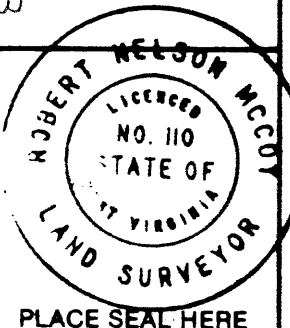

STATE OF WEST VIRGINIA
 DEPARTMENT OF ENERGY
 OIL AND GAS DIVISION

DATE OCTOBER 31, 19 85
 OPERATOR'S WELL NO. 3878
 API WELL NO. 47-61-0806-P

WELL TYPE: OIL ___ GAS ___ LIQUID INJECTION ___ WASTE DISPOSAL ___
 (IF "GAS,") PRODUCTION ___ STORAGE ___ DEEP ___ SHALLOW X ABANDONED X

LOCATION: ELEVATION 1250.4 WATERSHED MIRACLE RUN
 DISTRICT BATTELLE COUNTY MONONGALIA
 QUADRANGLE MANNINGTON, W.V. 75 4180

SURFACE OWNER JOHN W. MENDICINO ACREAGE 60.25
 OIL & GAS ROYALTY OWNER UNKNOWN LEASE ACREAGE _____
 LEASE NO. _____

PROPOSED WORK: DRILL ___ CONVERT ___ DRILL DEEPER ___ REDRILL X FRACTURE OR
 STIMULATE ___ PLUG OFF OLD FORMATION ___ PERFORATE NEW
 FORMATION ___ OTHER PHYSICAL CHANGE IN WELL (SPECIFY) _____

PLUG AND ABANDON ___ CLEAN OUT AND REPLUG X
 TARGET FORMATION NONE ESTIMATED DEPTH PRE - 1929 WELL

WELL OPERATOR CONSOLIDATION COAL COMPANY DESIGNATED AGENT ROGER E. DICKWORTH
 ADDRESS P.O. BOX 134 MORGANTOWN, W.V. 26508 ADDRESS P.O. BOX 134 MORGANTOWN, W.V. 26508

M.T. HALL 48673 FORM WW-6

COUNTY NAME PERMIT

RECEIVED
JUL 10 1986

FORM IV-38
Affidavit of Plugging)

STATE OF WEST VIRGINIA
DEPARTMENT OF MINES
OIL AND GAS WELLS DIVISION

AFFIDAVIT OF PLUGGING AND FILLING WELL

DIVISION OF OIL & GAS
DEPARTMENT OF ENERGY

AFFIDAVIT SHOULD BE MADE IN TRIPLICATE, one copy mailed to the Department, one copy to be retained by the Well Operator and the third copy (and extra copies if required) should be mailed to each coal operator at their respective addresses.

Consolidation Coal Company
Coal Operator or Owner
P.O. Box 1314, Morgantown, WV 26507-1314
Address

Consolidation Coal Company
Coal Operator or Owner
P.O. Box 1314, Morgantown, WV 26507-1314
Address

John Mendicino
Lease or Property Owner
P.O. Box 64, Pitcairn, Pa. 15140
Address

Consolidation Coal Company
Name of Well Operator
P.O. Box 1314, Morgantown, WV 26507-1314
Complete Address

June 11, 1986

WELL AND LOCATION

Battelle District

Monongalia County

WELL NO. #3878

John Mendicino Farm

STATE INSPECTOR SUPERVISING PLUGGING Don Ellis, Fairmont, WV 26554

AFFIDAVIT

STATE OF WEST VIRGINIA,
County of Harrison

ss: Calvin C. Lofton and Harold Wireman

being first duly sworn according to law depose and say that they are experienced in the work of plugging and filling oil and gas wells and were employed by Consolidation Coal Company, well operator, and participated in the work of plugging and filling the above well, that said work was commenced on the 22nd day of May, 19 86, and that the well was plugged and filled in the following manner:

Sand or Zone Record Formation	Filling Material	Plugs Used Size & Kind	Casing	
			CSG PULLED	CSG LEFT IN
Cleaned out wellbore to 1,475 feet. Pulled 278 feet of 4½ inch casing. Pulled 1,025 feet of 8½ inch casing.				
Ran coal protection string as follows: 295.40 feet of 2 3/8 inch tubing followed by 1,152.80 feet of 4½ inch casing. Latch down plug at 1,121.00 feet. Float valve at 1,152.80 feet. Circulated cement to surface as follows:				
Pumped 850 sacks of poz mix followed by 350 sacks of expanding cement. Displaced cement to 1,121 feet with water. Let set. Bailed dry.				
Coal Seams				
(Name) Pittsburgh	1,004 feet to 1,012 feet	5 feet of 4½ inch casing with plaque stating:		
(Name)		Consol #3878		
(Name)		47-061-0806-P		

M.J. 9/25/86

and that the work of plugging and filling said well was completed on the 6th day of June, 19 86.

And further deponents saith not.

Calvin C. Lofton
Harold Wireman

Sworn to and subscribed before me this 11th day of June, 19 86.

J. L. Everett
Notary Public

My commission expires:
September 08, 1988

Permit No. 47-061-0806-P

SEP 29 1986