


(+) DENOTES LOCATION OF WELL ON UNITED STATES TOPOGRAPHIC MAPS

FILE NO. \_\_\_\_\_  
 DRAWING NO. \_\_\_\_\_  
 SCALE 1" = 500'  
 MINIMUM DEGREE OF ACCURACY 1 IN 5000  
 PROVEN SOURCE OF ELEVATION COMPANY SURVEY  
TIED INTO THE U.S.G.S. NETWORK

I THE UNDERSIGNED, HEREBY CERTIFY THAT THIS PLAT IS CORRECT TO THE BEST OF MY KNOWLEDGE AND BELIEF AND SHOWS ALL THE INFORMATION REQUIRED BY LAW AND THE REGULATIONS ISSUED AND PRESCRIBED BY THE DEPARTMENT OF ENERGY.  
 (SIGNED) R. Nelson McCoy  
 R.P.E. \_\_\_\_\_ L.L.S. 110

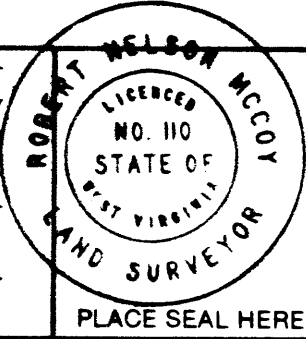

**STATE OF WEST VIRGINIA**  
 DEPARTMENT OF ENERGY  
 OIL AND GAS DIVISION

DATE NOV. 1, 19 85  
 OPERATOR'S WELL NO. 3884  
 API WELL NO. 47-61-0808-P

WELL TYPE: OIL  GAS  LIQUID INJECTION  WASTE DISPOSAL   
 (IF "GAS,") PRODUCTION  STORAGE  DEEP  SHALLOW  ABANDONED

LOCATION: ELEVATION 1337.24 WATERSHED RIGHT BRANCH MIRACLE RUN  
 DISTRICT BATTELLE COUNTY MONONGALIA  
 QUADRANGLE MANNINGTON, W.V. 75 15 FC

SURFACE OWNER GLADYS YOST ACREAGE 55.74  
 OIL & GAS ROYALTY OWNER UNKNOWN LEASE ACREAGE \_\_\_\_\_  
 LEASE NO. \_\_\_\_\_

PROPOSED WORK: DRILL  CONVERT  DRILL DEEPER  REDRILL  FRACTURE OR STIMULATE  PLUG OFF OLD FORMATION  PERFORATE NEW FORMATION  OTHER PHYSICAL CHANGE IN WELL (SPECIFY) \_\_\_\_\_

PLUG AND ABANDON  CLEAN OUT AND REPLUG

TARGET FORMATION NONE ESTIMATED DEPTH \_\_\_\_\_

WELL OPERATOR CONSOLIDATION COAL COMPANY DESIGNATED AGENT ROGERE. DUCKWORTH  
 ADDRESS P.O. BOX 1314 MORGANTOWN W.V. 26505 ADDRESS P.O. BOX 1314 MORGANTOWN, W.V. 26505

MAR 17 1985

M.T. HALL 10-96-77 FORM WV-6

COUNTY NAME PERMIT

**RECEIVED**  
AUG 31 1987

DIVISION OF OIL & GAS  
DEPARTMENT OF ENERGY

AFFIDAVIT OF PLUGGING AND FILLING WELL

AFFIDAVIT SHOULD BE MADE IN TRIPLICATE, one copy mailed to the Division, one copy to be retained by the Well Operator and the third copy (and extra copies if required) should be mailed to each coal operator at their respective addresses.

Consolidation Coal Company  
Coal Operator or Owner  
P.O. Box 1314, Morgantown, WV 26507-1314

Address  
Consolidation Coal Company  
Coal Operator or Owner

Consolidation Coal Company  
Address  
P.O. Box 1314, Morgantown, WV 26507-1314

Lease or Property Owner  
Gladys Yost, Rt. 2, Box 335C, Fayetteville,  
Address WV 25840

Consolidation Coal Company  
Name of Well Operator  
P.O. Box 1314, Morgantown, WV 26507-1314

Complete Address  
June 29, 19 87

WELL AND LOCATION  
Battelle District

Monongalia County

WELL NO. Consol 3884

Gladys Yost Farm

STATE INSPECTOR SUPERVISING PLUGGING Don Ellis, Fairmont, WV 26554

AFFIDAVIT


STATE OF WEST VIRGINIA,  
County of Harrison

ss:

Calvin C. Lofton and George R. Gore

being first duly sworn according to law depose and say that they are experienced in the work of plugging and filling oil and gas wells and were employed by Consolidation Coal Company, well operator, and participated in the work of plugging and filling the above well, that said work was commenced on the \_\_\_\_\_ day of June, 19 87, and that the well was plugged and filled in the following manner:

Sand or Zone Record Formation	Filling Material	Plugs Used Size & Kind	Casing	
			CSG PULLED	CSG LEFT IN
Cleaned out wellbore to 1,675 feet. Pulled 2 3/8 inch tubing from surface to 986 feet. Pulled 7 inch casing from 986 feet to 1,370 feet, 7 inch left in hole from 1370 feet to 1,675 feet. Ran coal protection string as follows: 262.32 feet of 2 3/8 inch tubing followed by 1,255.46 feet of 4 1/2 inch casing. Latch down plug at 1,231.36 feet. Float valve at 1,256.46 feet. Circulated cement to surface as follows: Pumped 750 sacks of poz mix followed by 190 sacks of expanding cement. Displaced cement to 1,231.36 feet with water. Let set, bailed dry.				
Total depth 1,517.78 feet.				
Coal Seams		Description of Monument		
(Name) Pittsburgh	1,145 feet to 1,151 feet	5 feet of 4 1/2 inch casing with plaque stating: Consol #3884 47-061-0808-P		
(Name)				
(Name)				
(Name)				

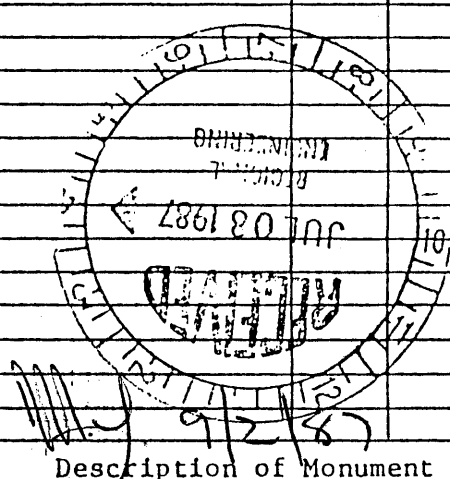

and that the work of plugging and filling said well was completed on the 24th day of June, 19 87

And further deponents saith not.

*Calvin C. Lofton*  
*George R. Gore*

Sworn to and subscribed before me this 29th day of June, 19 87.

*J. R. Egan*  
Notary Public

My commission expires:  
September 08, 1988

Permit No. 47-061-0808-P

SEP 8 1987