


LATITUDE 39°40'00"

LONGITUDE 80°15'00"

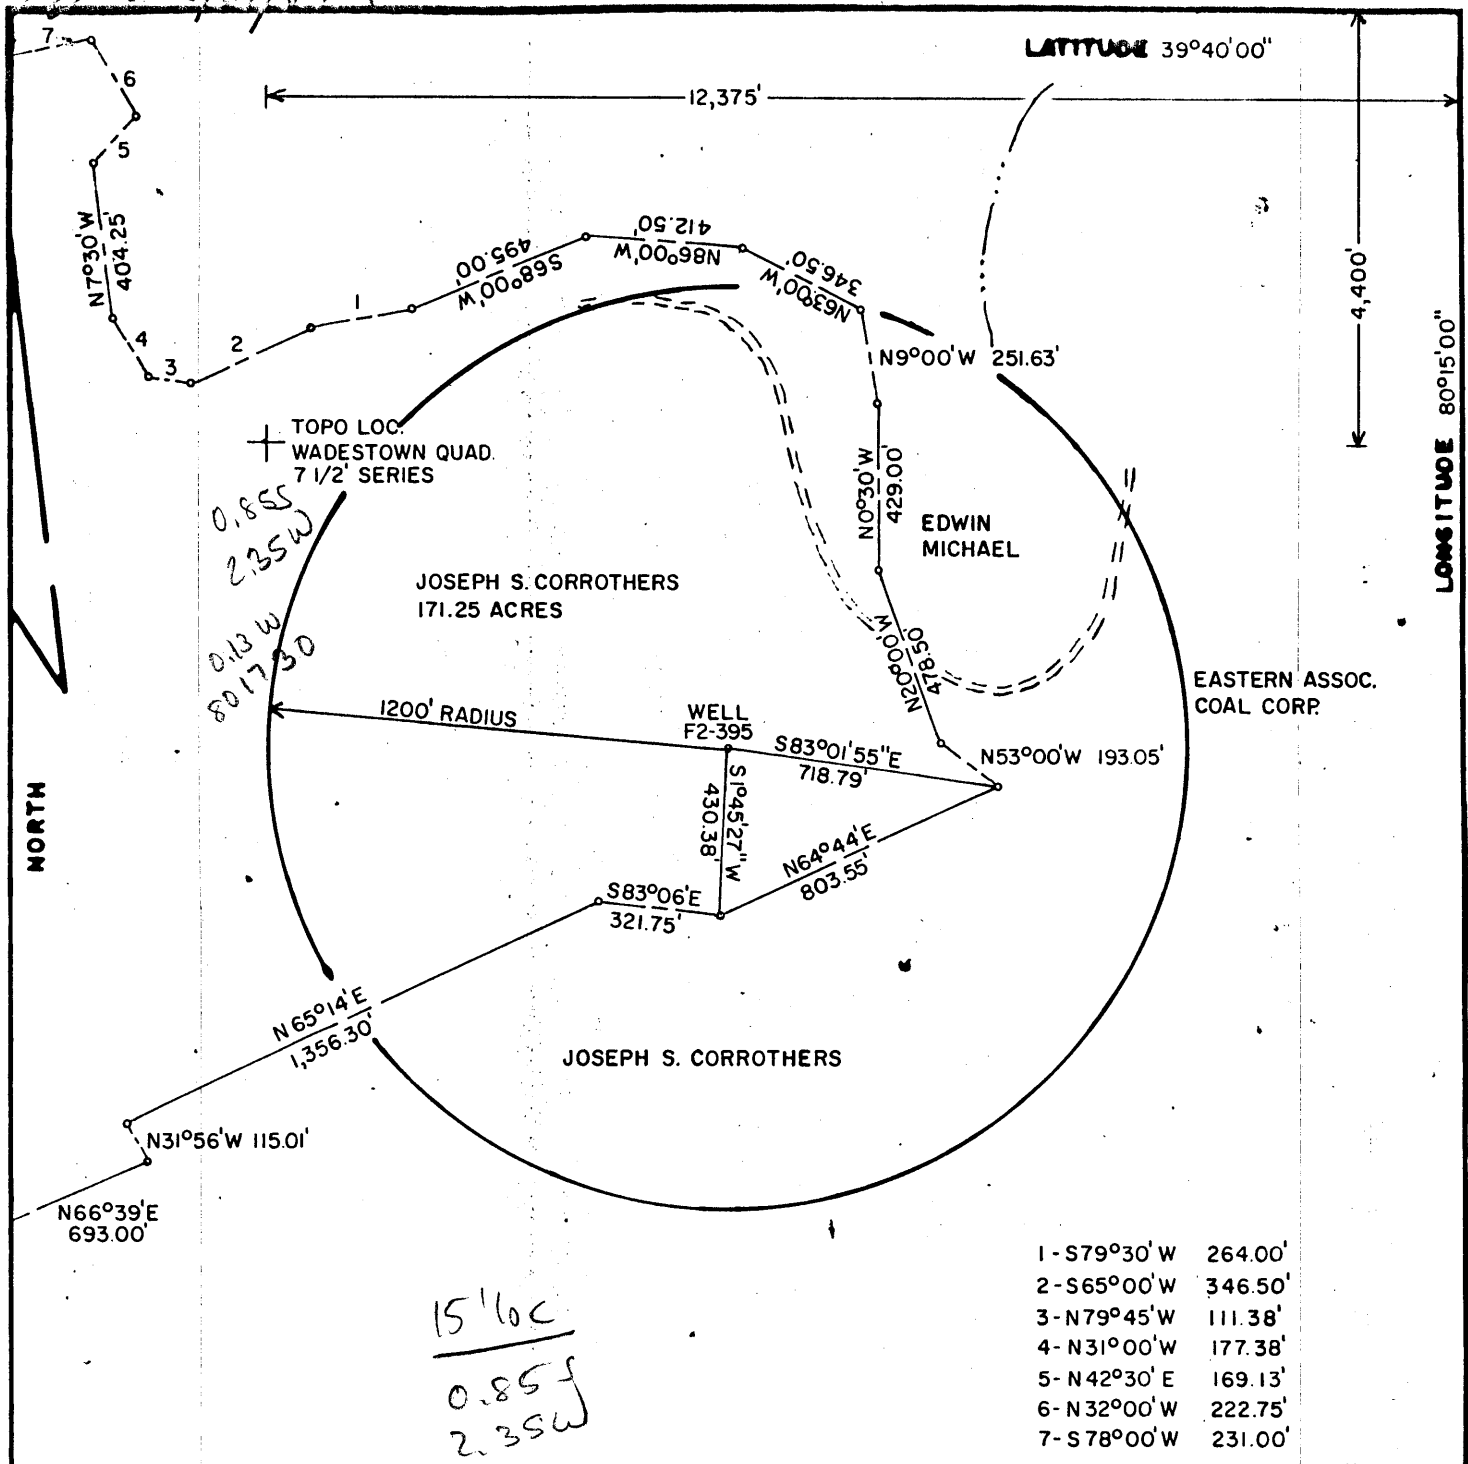


1-S79°30'W	264.00'
2-S65°00'W	346.50'
3-N79°45'W	111.38'
4-N31°00'W	177.38'
5-N42°30'E	169.13'
6-N32°00'W	222.75'
7-S78°00'W	231.00'

15' loc  
0.85  
2.35W

FILE NO. F2-2-164  
 DRAWING NO. F2-2-164  
 SCALE 1"=500'  
 MINIMUM DEGREE OF ACCURACY 1/2500'  
 PROVEN SOURCE OF ELEVATION USGS BM 1902 GRAFTON

I THE UNDERSIGNED, HEREBY CERTIFY THAT THIS PLAT IS CORRECT TO THE BEST OF MY KNOWLEDGE AND BELIEF AND SHOWS ALL THE INFORMATION REQUIRED BY LAW AND THE REGULATIONS ISSUED AND PRESCRIBED BY THE DEPARTMENT OF MINES.  
 (SIGNED) Frank Peduti 3/19/87  
 R.P.E. 9240 L.L.S. \_\_\_\_\_

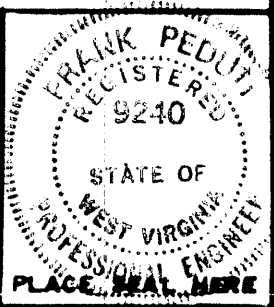

(+) DENOTES LOCATION OF WELL ON UNITED STATES TOPOGRAPHIC MAPS  
 FORM IV-6  
 (8-78)



DATE FEBRUARY 6, 19 87  
 OPERATOR'S WELL NO. F2-395  
 API WELL NO. 47-061-0835-P  
 STATE COUNTY PERMIT

STATE OF WEST VIRGINIA  
 DEPARTMENT OF MINES  
 OIL AND GAS DIVISION

WELL TYPE: OIL GAS  LIQUID INJECTION  WASTE DISPOSAL   
 (IF "GAS", PRODUCTION  STORAGE  DEEP  SHALLOW   
 LOCATION: ELEVATION 1,325' WATER SHED SCOTTS RUN  
 DISTRICT BATTELLE COUNTY MONONGALIA  
 QUADRANGLE WADESTOWN 7 1/2' Marionton EC  
 SURFACE OWNER JOSEPH S. & JACK B. CORROTHERS ACREAGE 171.25  
 OIL & GAS ROYALTY OWNER SOUTH PENN OIL CO. LEASE ACREAGE \_\_\_\_\_  
 LEASE NO. \_\_\_\_\_  
 PROPOSED WORK: DRILL  CONVERT  DRILL DEEPER  REDRILL  FRACTURE OR STIMULATE  PLUS OFF OLD FORMATION  PERFORATE NEW FORMATION  OTHER PHYSICAL CHANGE IN WELL (SPECIFY) \_\_\_\_\_  
 PLUS AND ABANDON  CLEAN OUT AND REPLUG   
 TARGET FORMATION FIFTY FOOT SAND ESTIMATED DEPTH 3.605' MAR 30 1987  
 WELL OPERATOR EASTERN ASSOC. COAL CORP. DESIGNATED AGENT JOHN A. VEITCH  
 ADDRESS ROUTE 1 BOX 144 ADDRESS SAME  
FAIRVIEW W. VA. 26570

**RECEIVED**  
NOV 23 1987

FORM WR-38  
(Affidavit of Plugging)

STATE OF WEST VIRGINIA  
DEPARTMENT OF ENERGY  
OIL AND GAS WELLS DIVISION

DIVISION OF OIL & GAS  
DEPARTMENT OF ENERGY

**AFFIDAVIT OF PLUGGING AND FILLING WELL**

AFFIDAVIT SHOULD BE MADE IN TRIPLICATE, one copy mailed to the Division, one copy to be retained by the Well Operator and the third copy (and extra copies if required) should be mailed to each coal operator at their respective addresses.

Eastern Associated Coal Corp.  
Coal Operator or Owner  
Rt. 1, Box 144, Fairview, WV 26570  
Address

Coal Operator or Owner  
Address

Joseph S. Corrothers  
Lease or Property Owner  
1428 Cov. Road, Oregon, Ohio  
Address

Eastern Associated Coal Corp.  
Name of Well Operator  
Rt. 1, Box 144, Fairview, WV 26570  
Complete Address

April 21, 19 87  
WELL AND LOCATION  
Battelle District

Monongalia County

WELL NO. F2-395-EACC

A. J. Corrothers M.V.T. Co. No. 1 Farm

STATE INSPECTOR SUPERVISING PLUGGING Don Ellis

**AFFIDAVIT**

STATE OF WEST VIRGINIA,  
County of Monongalia

ss:

Mark Moore and Jim Gump

being first duly sworn according to law depose and say that they are experienced in the work of plugging and filling oil and gas wells and were employed by Chisler Brothers, well operator, and participated in the work of plugging and filling the above well, that said work was commenced on the 18 day of March, 19 87, and that the well was plugged and filled in the following manner:

Sand or Zone Record Formation	Filling Material	Plugs Used Size & Kind	Casing	
			CSG PULLED	CSG LEFT IN
1) Cleaned out to a depth of 1452'		4 1/2" Pipe		1179'
2) Run logs Gamma Ray, Neutron & 3 Arm Caliper				
3) Run 4 1/2" pipe to 1452' gelled hole with 11 sacks gell and got circulation				
4) Pulled 1172' of 8" pipe used to clean out to total depth				
5) Regelled hole with 8 sack of gell & 2 bags paper mulch & got circulation				
6) Recirculated hole with 3 sack gell & 1 bag paper mulch				
7) Run 150 sack chem comp cement, pulled 4 1/2" pipe to 1179'				
Run 825 sack portland & 150 sacks chem comp cement and got circulation				
8) Pumped Latch Down Plug to 1159'				
9) Bailed water out inside 4 1/2" pipe				
Coal Seams			Description of Monument	
(Name) Pittsburgh Coal 1045 - 1052			4 1/2"x2" Swedge with a 2" stop at the surface. 2" pipe with a metal plate monument welded to the 2" pipe.	
(Name)				
(Name)				
(Name)				

*[Signature]* 11/30/87

and that the work of plugging and filling said well was completed on the 15 day of April, 19 87.

And further deponents saith not.

Sworn to and subscribed before me this 23<sup>rd</sup> day of April, 19 87.

Mark Moore  
Jim Gump  
James Moore  
Notary Public DEC 7 1987

My commission expires:  
2.17.1995

Permit No. 47-061-0835-P