



Donnie 6/23/88

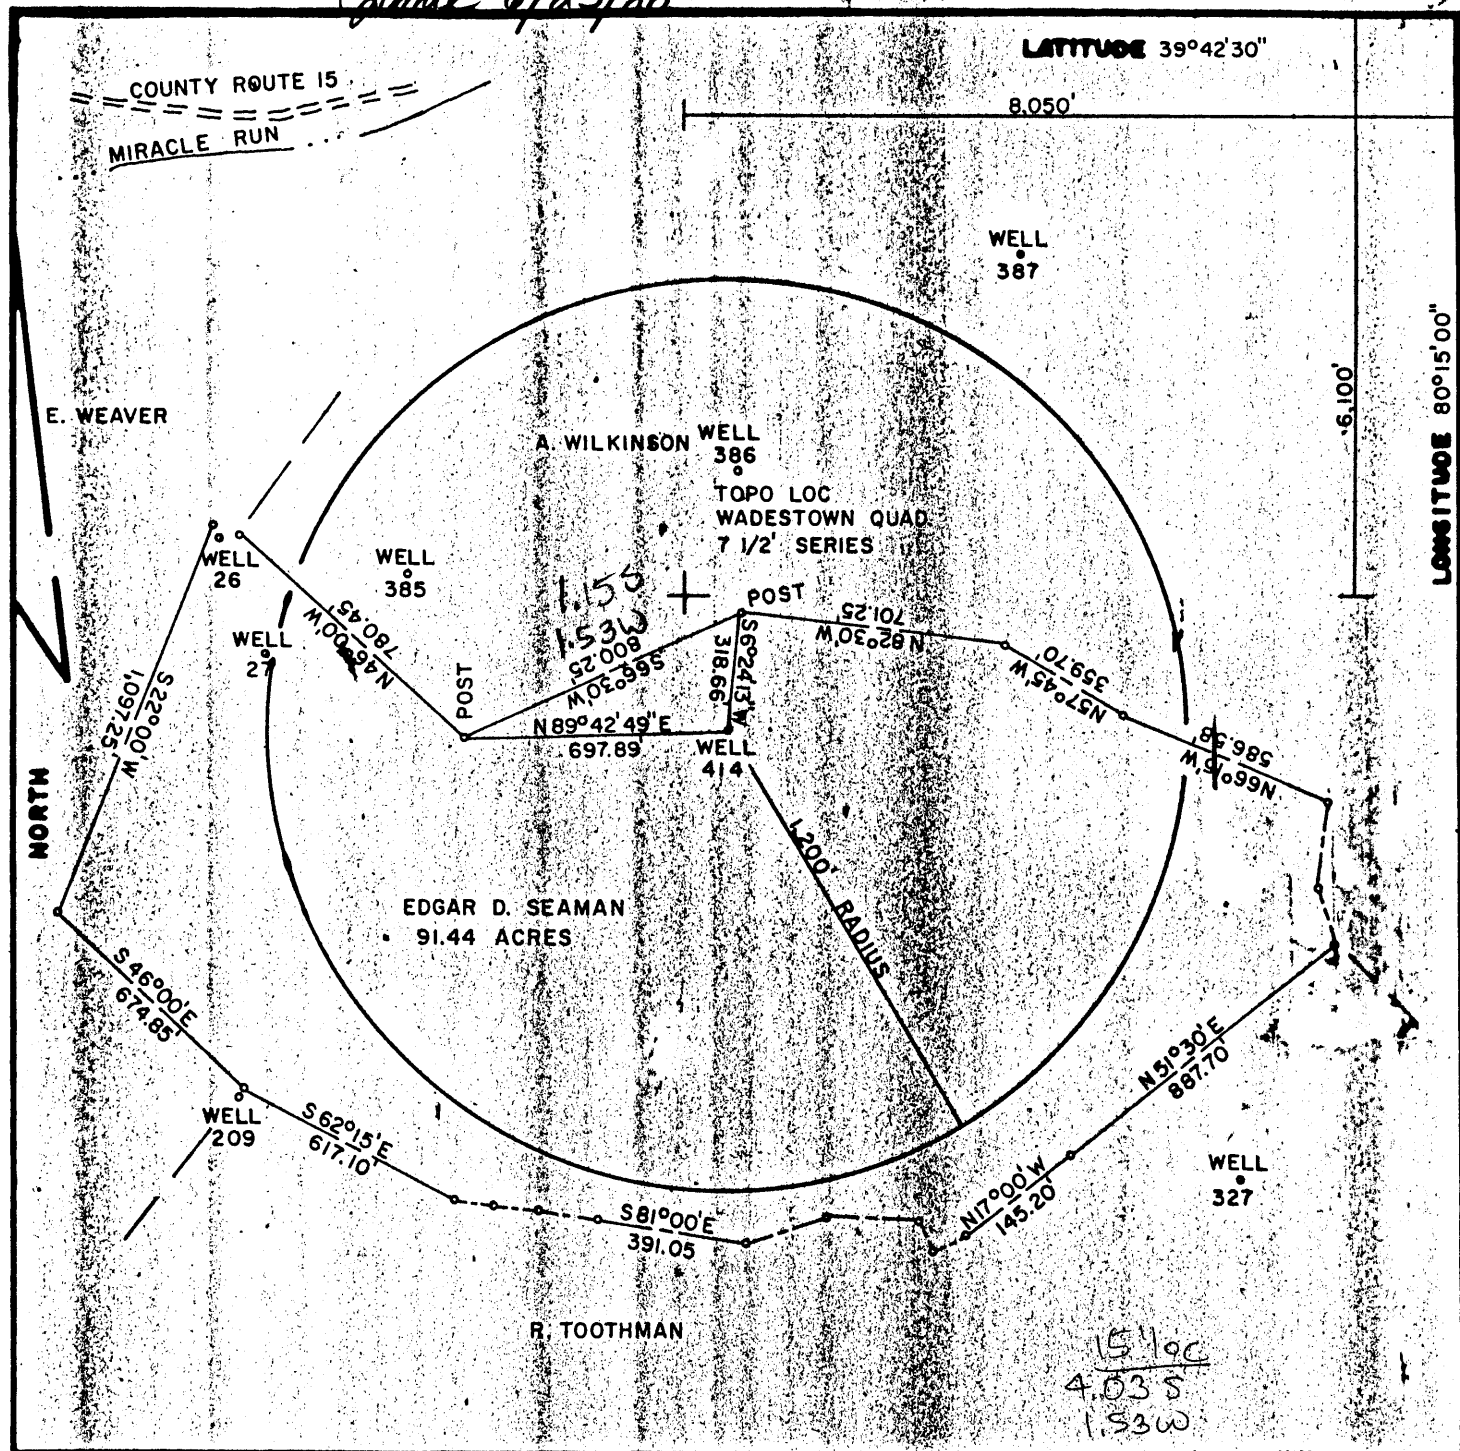

*1510c
4.03 S
1.53W*

FILE NO. F2-1-165
 DRAWING NO. F2-2-176
 SCALE 1"=500'
 MINIMUM DEGREE OF ACCURACY 1/2500
 PROVEN SOURCE OF ELEVATION USGS BM 1902 GRAFTON

I THE UNDERSIGNED, HEREBY CERTIFY THAT THIS PLAT IS CORRECT TO THE BEST OF MY KNOWLEDGE AND BELIEF AND SHOWS ALL THE INFORMATION REQUIRED BY LAW AND THE REGULATIONS ISSUED AND PRESCRIBED BY THE DEPARTMENT OF MINES.
 (SIGNED) *Frank Peduti 18 June 1988*
 R.P.E. 9240 L.L.S. _____

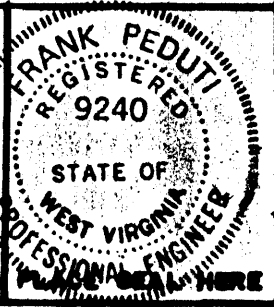

(+) DENOTES LOCATION OF WELL ON UNITED STATES TOPOGRAPHIC MAPS
 FORM IV-6 (6-78)



DATE JUNE 17, 1988
 OPERATOR'S WELL NO F2-414
 AM WELL NO. 47-061
 STATE WEST VIRGINIA COUNTY MONONGALIA PERMIT 6871-P

STATE OF WEST VIRGINIA
 DEPARTMENT OF MINES
 OIL AND GAS DIVISION

WELL TYPE: OIL ___ GAS X LIQUID INJECTION ___ WASTE DISPOSAL ___
 (IF "GAS", PRODUCTION ___ STORAGE ___ DEEP ___ SHALLOW X)
 LOCATION: ELEVATION 1290' WATER SHED MIRACLE RUN
 DISTRICT BATTELLE COUNTY MONONGALIA
 QUADRANGLE WADESTOWN 7 1/2' SERIES Manhattan NE
 SURFACE OWNER EDGAR D. SEAMAN ACREAGE 91.14
 OIL & GAS ROYALTY OWNER FORMERLY SOUTH PENN OIL CO. LEASE ACREAGE 103
 LEASE NO. _____
 PROPOSED WORK: DRILL ___ CONVERT ___ DRILL DEEPER ___ REDRILL X FRACTURE OR STIMULATE ___ PLUG OFF OLD FORMATION ___ PERFORATE NEW FORMATION ___ OTHER PHYSICAL CHANGE IN WELL (SPECIFY) _____
 PLUG AND ABANDON X CLEAN OUT AND REPLUG ___
 TARGET FORMATION GORDON ESTIMATED DEPTH 3238' **JUL 1 1988**
 WELL OPERATOR EASTERN ASSOC. COAL CORP. DESIGNATED AGENT JOHN A. VEITCH
 ADDRESS ROUTE 1 BOX 144 FAIRVIEW W. VA. 26570 ADDRESS ROUTE 1 BOX 144 FAIRVIEW W. VA. 26570

RECEIVED
JUL 22 1988

FORM WR-38
(Affidavit of Plugging)

STATE OF WEST VIRGINIA
DEPARTMENT OF ENERGY
OIL AND GAS WELLS DIVISION

DIVISION OF OIL & GAS
DEPARTMENT OF ENERGY

AFFIDAVIT OF PLUGGING AND FILLING WELL

AFFIDAVIT SHOULD BE MADE IN TRIPPLICATE, one copy mailed to the Division, one copy to be retained by the Well Operator and the third copy (and extra copies if required) should be mailed to each coal operator at their respective addresses.

<u>Eastern Associated Coal Corporation</u> Coal Operator or Owner	<u>Eastern Associated Coal Corporation</u> Name of Well Operator
<u>Route 1, Box 144 Fairview, WV. 26570</u> Address	<u>Route 1, Box 144 Fairview, WV 26570</u> Complete Address
_____	July 18, _____ 19 88
Coal Operator or Owner	WELL AND LOCATION
_____	Battelle District
Address	_____
Edgar D. Seaman	Monongalia County
Lease or Property Owner	_____
<u>Route 1 Fairview WV. 26570</u> Address	WELL NO. F2-414 EACC
_____	<u>Luverna Parks No. 1 91.14 Acres</u> Farm

STATE INSPECTOR SUPERVISING PLUGGING Don Ellis

AFFIDAVIT

STATE OF WEST VIRGINIA,
County of Monongalia

ss: Jim McKenzie and Fred Chisler
being first duly sworn according to law depose and say that they are experienced in the work of plugging and filling oil and gas wells and were employed by Chisler Brothers, well operator, and participated in the work of plugging and filling the above well, that said work was commenced on the 30 day of June, 19 88, and that the well was plugged and filled in the following manner:

Sand or Zone Record	Filling Material	Plugs Used	Casing
Formation		Size & Kind	CSO CSB
1) cleaned out to a depth of 1523'		4 1/2" Pipe	1,113
2) run Gamma Ray, Neutron and 3 Arm Caliper Logs			
3) run 1523' of 4 1/2" Pipe gelled hole with 21 Sack gell 4 Bags paper mulch and got Circulation.			
4) Run 300 Sacks of Chem Comp Cement, pulled 4 1/2" pipe to 1113, Run 800 Sack Portland and 150 Chem Comp.			
5) Pumped Latch down Plug to 1093			
6) Run 2 3/8" Tubing down tagged cement at 263' down. Run 310 sack portland & got circulation pulled			
pulled 2 3/8" Tubing			
7) Balled water out inside 4 1/2" Pipe.			
Coal Seams		Description of Monument	
(Name) <u>Pittsburgh Coal 986' to 994'</u>		4 1/2" x 2" Swedge with Metal	
(Name)		Plate welded to 2" Pipe.	
(Name)		Date Plugged and A.P.I. No.	
(Name)		on Plate.	

and that the work of plugging and filling said well was completed on the 18 day of July, 19 88.
And further deponents saith not.

Sworn to and subscribed before me this 18th day of July, 19 88
James D. McKenzie
Frederick P. Chisler
William J. Tuttle
Notary Public

My commission expires:
June 17, 1997

Permit No. 47-261-0871-P

RECEIVED
JAN 27 1989

DIVISION OF OIL & GAS
DEPARTMENT OF ENERGY

Wadevtown le