


*Jamie 5/1/89*

LATITUDE 39° 42' 30"

9,400'

4,675'

LONGITUDE 80° 15' 00"

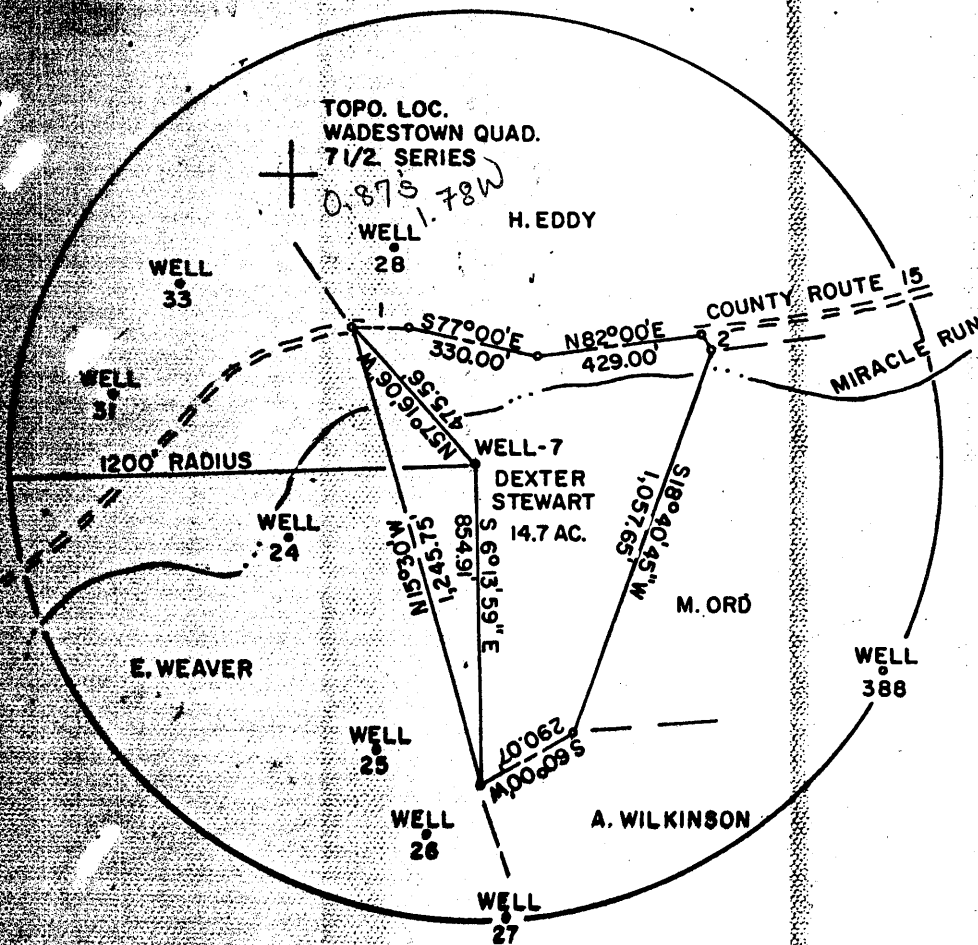

NORTH

TOPO. LOC. WADESTOWN QUAD. 7 1/2' SERIES


*0.878 78W*

1- N89°30' E 148.50'  
2- S34°00' E 49.50'

*Calc 15' loc  
3.755  
1.78W*

FILE NO. F2-1-174  
DRAWING NO. F2-2-188  
SCALE 1"=500'  
MINIMUM DEGREE OF ACCURACY 1/2500  
PROVEN SOURCE OF ELEVATION USGS BM 1902 GRAFTON

I THE UNDERSIGNED, HEREBY CERTIFY THAT THIS PLAT IS CORRECT TO THE BEST OF MY KNOWLEDGE AND BELIEF AND SHOWS ALL THE INFORMATION REQUIRED BY LAW AND THE REGULATIONS ISSUED AND PRESCRIBED BY THE DEPARTMENT OF MINES.  
(SIGNED) Gary W. Halstead  
R.P.E. 9235 L.L.S. \_\_\_\_\_

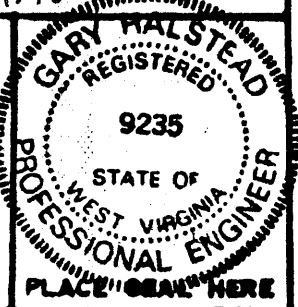

(\*) DENOTES LOCATION OF WELL ON UNITED STATES TOPOGRAPHIC MAPS  
FORM IV-6 (8-78)



DATE MAY 6, 1989  
OPERATOR'S WELL NO. F2-7  
API WELL NO. 47  
STATE 061 COUNTY 0916P PERMIT

STATE OF WEST VIRGINIA  
DEPARTMENT OF MINES  
OIL AND GAS DIVISION

WELL TYPE: OIL  GAS  LIQUID INJECTION  WASTE DISPOSAL   
(IF "GAS", PRODUCTION  STORAGE  DEEP  SHALLOW   
LOCATION: ELEVATION 1030' WATER SHED RIGHT BRANCH MIRACLE RUN  
DISTRICT BATTELLE COUNTY MONONGALIA  
QUADRANGLE WADESTOWN 7 1/2' Manington 78  
SURFACE OWNER DEXTER M. STEWART ACREAGE 14.7  
OIL & GAS ROYALTY OWNER FORMERLY SOUTH PENN OIL COMPANY LEASE ACREAGE \_\_\_\_\_  
LEASE NO. \_\_\_\_\_  
PROPOSED WORK: DRILL  CONVERT  DRILL DEEPER  REDRILL  FRACTURE OR STIMULATE  PLUS OFF OLD FORMATION  PERFORATE NEW FORMATION  OTHER PHYSICAL CHANGE IN WELL (SPECIFY) \_\_\_\_\_  
PLUG AND ABANDON  CLEAN OUT AND REPLUG \_\_\_\_\_  
TARGET FORMATION GORDON ESTIMATED DEPTH 2976' MAY 21 1989  
WELL OPERATOR EASTERN ASSOC. COAL CORP. DESIGNATED AGENT TERRY O. HENDERSHOT  
ADDRESS ROUTE 1 BOX 144 FAIRVIEW W. VA. 26570 ADDRESS ROUTE 1 BOX 144 FAIRVIEW W. VA. 26570

89

RECEIVED  
SEP 19 1991  
DEPT. OF ENERGY

STATE OF WEST VIRGINIA  
DEPARTMENT OF ENERGY  
DIVISION OF OIL AND GAS

REC'D  
Department of Energy  
JUN 14 89  
Office of

AFFIDAVIT OF PLUGGING AND FILLING WELL

AFFIDAVITE SHOULD BE IN TRIPPLICATE, one copy mailed to the Division, one copy to be retained by the Well Operator and the third copy (and extra copies if required) should be mailed to each coal operator at their respective addresses.

Farm name: STEWART, DEXTER Operator Well No.: EAAC - F2-7

LOCATION: Elevation: 1030.00 Quadrangle: WADESTOWN  
District: BATTELLE County: MONONGALIA  
Latitude: 4675 Feet South of 39 Deg. 42 Min. 30 Sec.  
Longitude 9400 Feet West of 80 Deg. 15 Min. 0 Sec.

Well Type: OIL   X   GAS       

Company: South Penn Oil Company Coal Operator Eastern Associated Coal C.  
P.O. Drawer 1588 or Owner Rt.1 Box 144  
Parkersburg, WV 26102 Fairview, WV 26570

Agent: Terry O. Hendershot Coal Operator Eastern Associated Coal C.  
Inspector: Don Ellis or Owner Rt.1 Box 144  
Permit Issued: 05/12/89 Fairview, WV 26570

AFFIDAVIT

STATE OF WEST VIRGINIA,  
County of Monongalia ss:

Jim Gump and Mark Moore being first duly sworn according to law depose and say that they are experienced in the work of plugging and filling oil and gas wells and were employed by Chisler Brothers, well operator, and participated in the work of plugging and filling the above well, that said work was commenced on the 19 day of May, 1989, and that the well was plugged and filled in the following manner:

TYPE	FROM	TO	PIPE REMOVED	LEFT
Cleaned out to 1300'. Run logs, Gamma Ray, Neutron & 3 Arm Caliper.				
Put stone bridge in from	1300' to 1253'.			
Run 4 1/2" pipe to 1253'. Gelled hole with 30 sack gell & got circulation.				
Run 200 sack Portland, 200 sack Chem Comp & pulled 4 1/2" pipe to 838'.				
Run 600 sack Portland, 100 sack Chem Comp & got circulation.				
Pumped latch down plug to 818'.				
Bailed water out inside	4 1/2" pipe - checked plug.			
		New	4 1/2" pipe	838'

Description of monument 4 1/2" x 2" Swedge metal plate welded to 2" pipe  
with date plugged and API No. on plate.

and that the work of plugging and filling said well was completed on the 10 day of June, 1989.

And furthur deponents saith not.

SEP 16 1991  
Jim Gump  
Mark Moore  
William J. Little  
Notary Public

Sworn and subscribe before me this 12<sup>th</sup> day of June, 1989  
My commission expires: June 17, 1997