


*Opine 7/3/89*

LATITUDE 38°42'30"

5700


LONGITUDE 80°15'00"

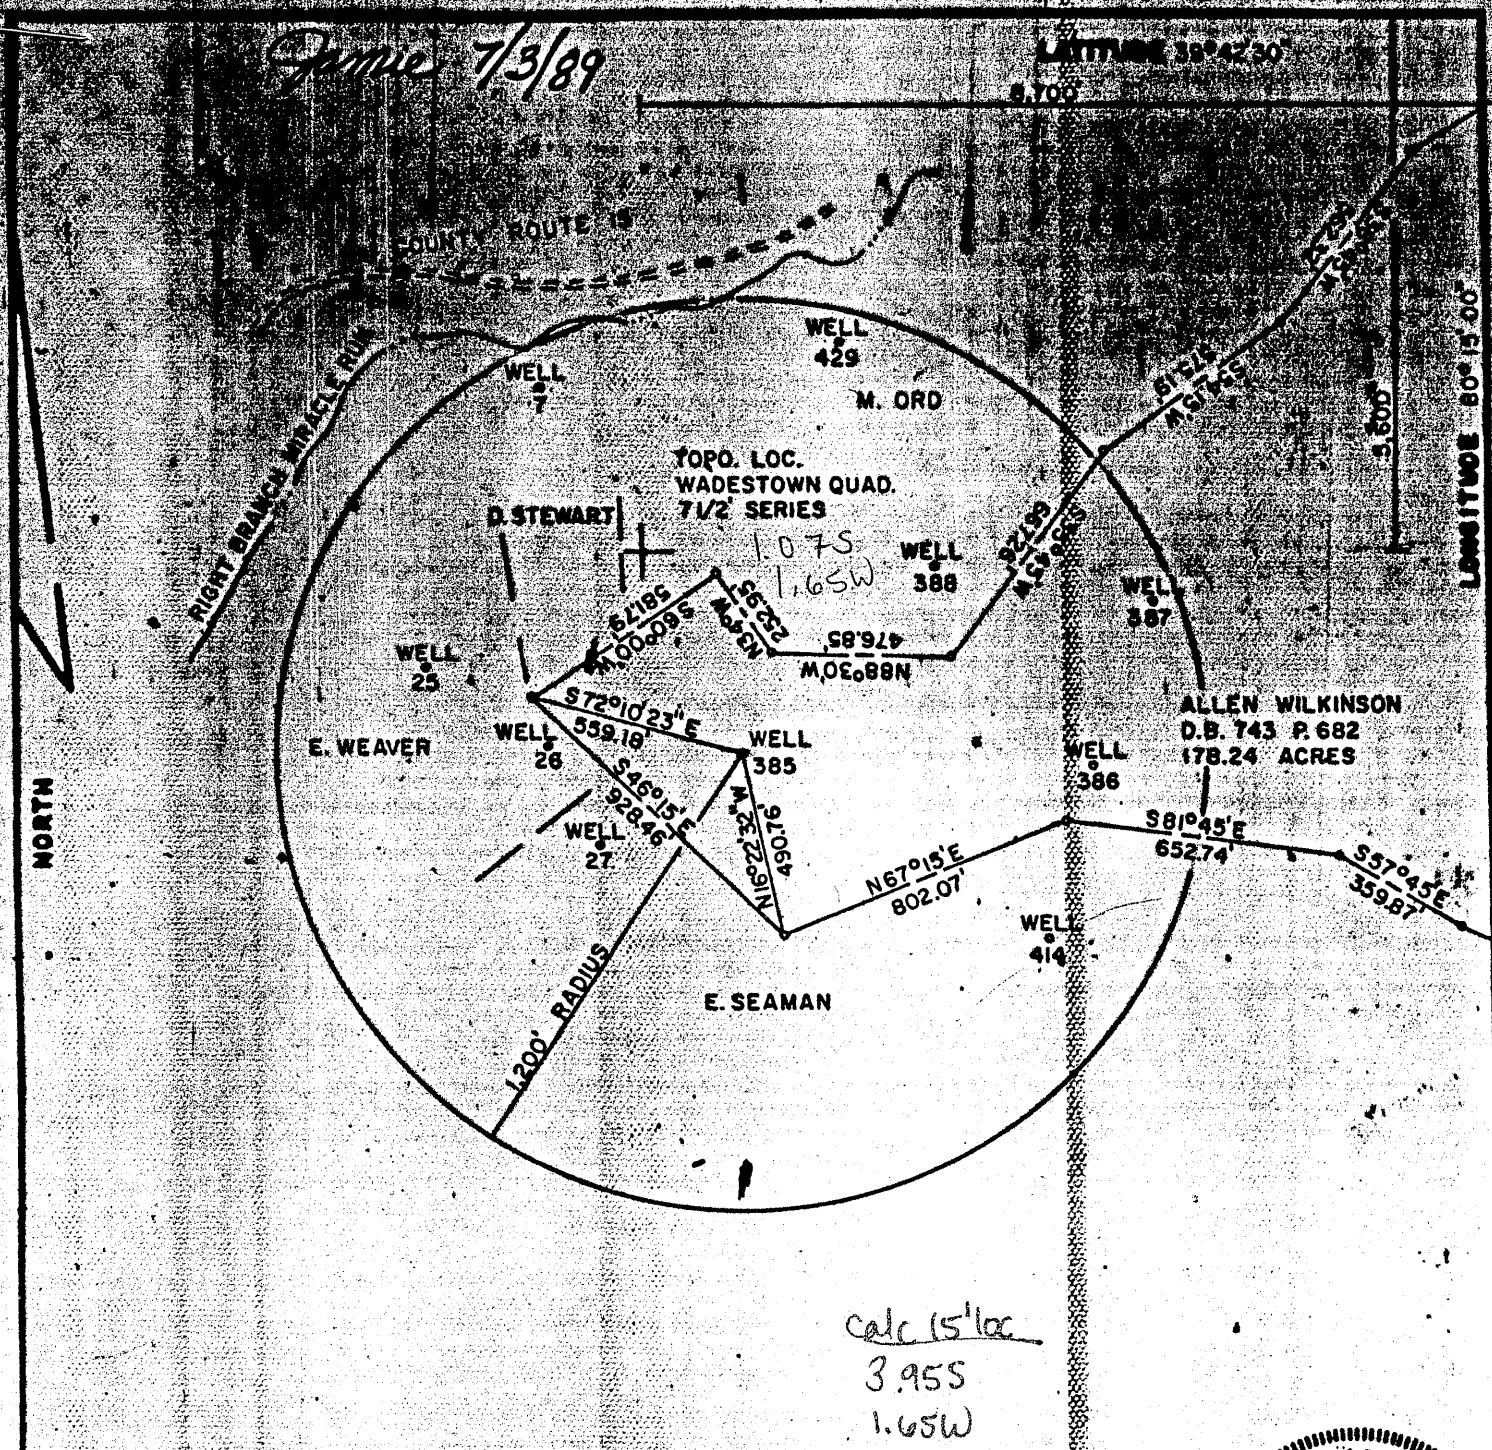

*calc 15' loc  
3.955  
1.65W*

FILE NO. F2-2-173  
DRAWING NO. F2-2-193  
SCALE 1" = 500'  
MINIMUM DEGREE OF ACCURACY 1/2500  
PROVEN SOURCE OF ELEVATION USGS BM

I, THE UNDERSIGNED, HEREBY CERTIFY THAT THIS PLAT IS CORRECT TO THE BEST OF MY KNOWLEDGE AND BELIEF AND SHOWS ALL THE INFORMATION REQUIRED BY LAW AND THE REGULATIONS ISSUED AND PRESCRIBED BY THE DEPARTMENT OF MINES.  
(SIGNED) Gary Halstead  
R.P.E. 19235 L.L.S. \_\_\_\_\_

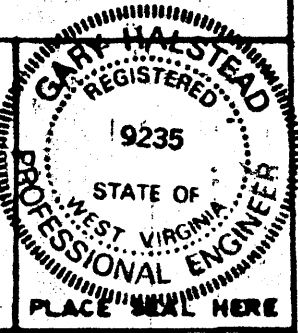

(+) DENOTES LOCATION OF WELL ON UNITED STATES TOPOGRAPHIC MAPS  
FORM IV-6  
(8-78)

DATE JULY 1, 19 89  
OPERATOR'S WELL NO F2-385  
API WELL NO. 47 061  
STATE WEST VIRGINIA COUNTY MONONGALIA PERMIT 0921-P

STATE OF WEST VIRGINIA  
DEPARTMENT OF MINES  
OIL AND GAS DIVISION

WELL TYPE: OIL  GAS  LIQUID INJECTION  WASTE DISPOSAL   
(IF "GAS", PRODUCTION  STORAGE  DEEP  SHALLOW   
LOCATION: ELEVATION 1320 WATER SHED RIGHT BRANCH MIRACLE RUN  
DISTRICT BATTELLE COUNTY MONONGALIA  
QUADRANGLE WADESTOWN 7 1/2' SERIES Mannington ne  
SURFACE OWNER ALLEN WILKINSON ACREAGE 178.24  
OIL & GAS ROYALTY OWNER FORMERLY SOUTH PENN OIL COMPANY LEASE ACREAGE \_\_\_\_\_  
LEASE NO. \_\_\_\_\_  
PROPOSED WORK: DRILL  CONVERT  DRILL DEEPER  REDRILL  FRACTURE OR STIMULATE  PLUS OFF OLD FORMATION  PERFORATE NEW FORMATION  OTHER PHYSICAL CHANGE IN WELL (SPECIFY) \_\_\_\_\_

PLUG AND ABANDON  CLEAN OUT AND REPLUG \_\_\_\_\_  
TARGET FORMATION GORDON SAND ESTIMATED DEPTH 3264' JUL 7 1989  
WELL OPERATOR EASTERN ASSOC. COAL CORP. DESIGNATED AGENT TERRY O. HENDERSHOT  
ADDRESS ROUTE 1 BOX 144 FAIRVIEW W. VA. 26570 ADDRESS ROUTE 1 BOX 144 FAIRVIEW W. VA. 26570

STATE OF WEST VIRGINIA  
DEPARTMENT OF ENERGY  
DIVISION OF OIL AND GAS

AFFIDAVIT OF PLUGGING AND FILLING WELL

AFFIDAVITE SHOULD BE IN TRIPLICATE, one copy mailed to the Division, one copy to be retained by the Well Operator and the third copy (and extra copies if required) should be mailed to each coal operator at their respective addresses.

Farm name: WILKINSON, ALLEN & LYDIA Operator Well No.: F2-385

LOCATION: Elevation: 1320.00 Quadrangle: WADESTOWN  
District: BATTELLE County: MONONGALIA  
Latitude: 5600 Feet South of 39 Deg. 42 Min. 30 Sec.  
Longitude 8700 Feet West of 80 Deg. 15 Min. 0 Sec.

Well Type: OIL X GAS

Company: Pennzoil Company  
PO Drawer 1588  
Parkersburg, WV

Coal Operator Eastern Assoc. Coal Co  
or Owner Route 1 Box 144  
Fairview, WV 26570

Agent: Terry O. Hendershot  
Inspector: Don Ellis  
Permit Issued: 07/05/89

Coal Operator  
or Owner

AFFIDAVIT

STATE OF WEST VIRGINIA,  
County of Monongalia ss;

Jim Gump and Ray Smith being first duly sworn according to law depose and say that they are experienced in the work of plugging and filling oil and gas wells and were employed by Chisler Brothers, well operator, and participated in the work of plugging and filling the above well, that said work was commenced on the 7 day of August, 1989, and that the well was plugged and filled in the following manner:

TYPE	FROM	TO	PIPE REMOVED	LEFT
Cleaned out to 1389'	Run logs Gamma Ray,	Neutron	& 3 Arm Caliper	
Run 4 1/2" pipe to	1379' Gelled	hole with 20	sack gell - 2	bags paper mulc
Run 300 sacks Portland	& 200 sack	chem comp		
Pulled 4 1/2" pipe to	1147'			
Run 800 sack of Portland	& 100 chem	comp cement		
Pumped plug to 1107'				
Bailed water out inside	4 1/2" pipe	and checked	plug ok	
<u>Pittsburgh Coal 1027</u>	<u>to 1034</u>			

Description of monument:

and that the work of plugging and filling said well was completed on the 29 day of August, 1989.

And furthur deponents saith not.

Sworn and subscribe before me this 12<sup>th</sup> day of September, 1989

My commission expires: June 17, 1997

Jim Gump  
Ray Smith  
William F. Tuttle  
Notary Public

MAY 22 1990