


Jamie 7/24/89

LATITUDE 39° 40' 00"

7,870

LONGITUDE 80° 10' 00"

9,380

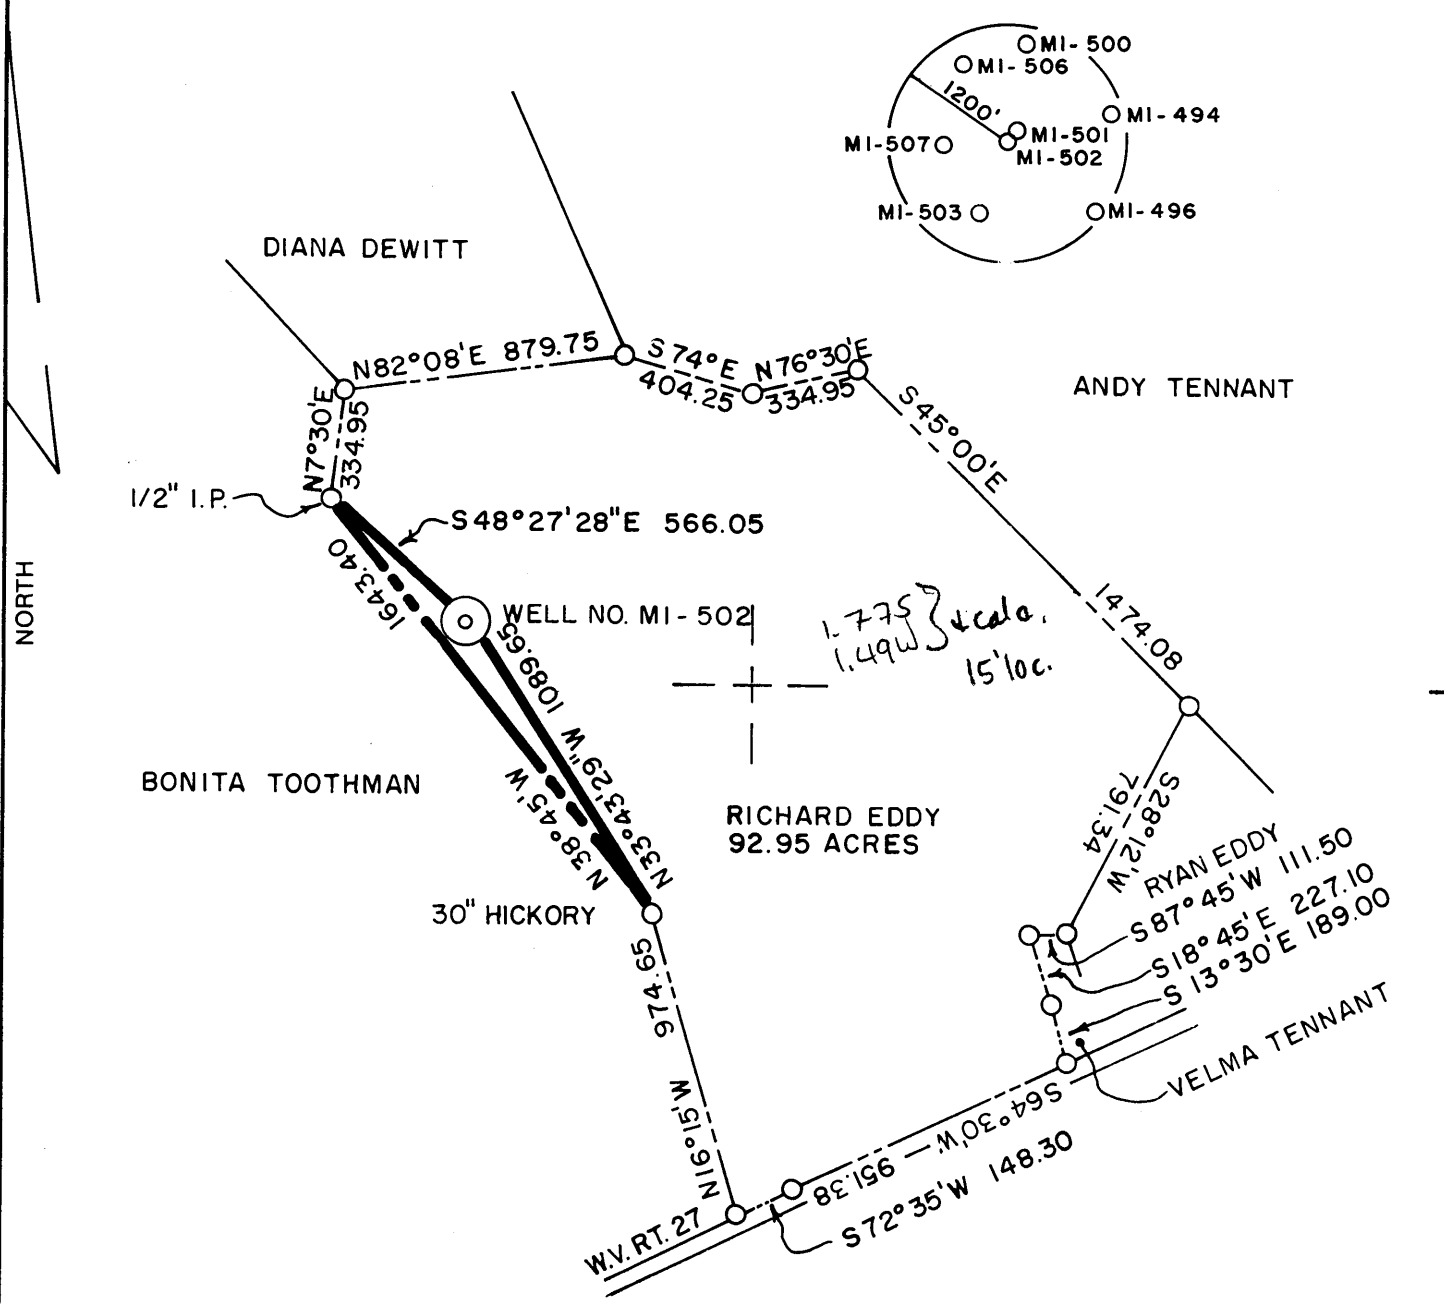

(+) DENOTES LOCATION OF WELL ON UNITED STATES TOPOGRAPHIC MAPS

FILE NO. _____
 DRAWING NO. _____
 SCALE 1" = 600'
 MINIMUM DEGREE OF ACCURACY 1 IN 5000
 PROVEN SOURCE OF ELEVATION COMPANY SURVEY
 TIED INTO U.S.G.S NETWORK

I THE UNDERSIGNED, HEREBY CERTIFY THAT THIS PLAT IS CORRECT TO THE BEST OF MY KNOWLEDGE AND BELIEF AND SHOWS ALL THE INFORMATION REQUIRED BY LAW AND THE REGULATIONS ISSUED AND PRESCRIBED BY THE DEPARTMENT OF ENERGY.

(SIGNED) Carl Morris
 R.P.E. _____ L.L.S. 460



STATE OF WEST VIRGINIA
DEPARTMENT OF ENERGY
OIL AND GAS DIVISION



DATE JANUARY 6, 19 89
 OPERATOR'S WELL NO. MI-502
 API WELL NO. _____

WELL TYPE: OIL ___ GAS ___ LIQUID INJECTION ___ WASTE DISPOSAL ___
 (IF "GAS,") PRODUCTION ___ STORAGE ___ DEEP ___ SHALLOW X ABANDONED X

LOCATION: ELEVATION 1444.63 WATERSHED JAKES RUN
 DISTRICT CLAY COUNTY MONONGALIA
 QUADRANGLE BLACKSVILLE W.V. - PA. 7.5 + 15' WC

SURFACE OWNER RICHARD EDDY ACREAGE 92.95
 OIL & GAS ROYALTY OWNER _____ LEASE ACREAGE _____

PROPOSED WORK: DRILL ___ CONVERT ___ DRILL DEEPER ___ REDRILL ___ FRACTURE OR STIMULATE ___ PLUG OFF OLD FORMATION ___ PERFORATE NEW FORMATION ___ OTHER PHYSICAL CHANGE IN WELL (SPECIFY) _____

PLUG AND ABANDON CLEAN OUT AND REPLUG X
 TARGET FORMATION NONE ESTIMATED DEPTH _____
 WELL OPERATOR CONSOLIDATION COAL COMPANY DESIGNATED AGENT ROGER E. DUCKWORTH
 ADDRESS P.O. BOX 1314 MORGANTOWN W.V. 26505 ADDRESS P.O. BOX 1314 MORGANTOWN W.V. 26505

JUL 28 1989

FORM WW-6
 H.T. HALL 48673

COUNTY NAME
 PERMIT

AFFIDAVIT OF PLUGGING AND FILLING WELL

AFFIDAVIT SHOULD BE MADE IN TRIPLICATE, one copy mailed to the Division, one copy to be retained by the Well Operator and the third copy (and extra copies if required) should be mailed to each coal operator at their respective addresses.

Consolidation Coal Co.
Coal Operator or Owner
P.O. Box 1314 Morgantown, W.Va. 26505
Address

Consolidation Coal Co.
Coal Operator or Owner
P.O. Box 1314 Morgantown, W.Va. 26505
Address

Richard Eddy
Lease or Property Owner
Rt. 2 Fairview, W.Va.
Address

Consolidation Coal Co.
Name of Well Operator
P.O. Box 1314 Morgantown, W.Va.
Complete Address

Sept. 14 19 89
WELL AND LOCATION


Clay District
Monongalia County

WELL NO. M1-502

STATE INSPECTOR SUPERVISING PLUGGING

DOn Ellis

AFFIDAVIT

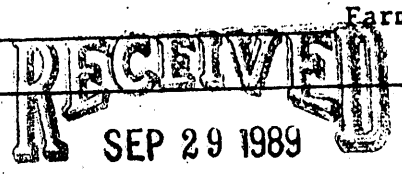

STATE OF WEST VIRGINIA,
County of Monongalia

ss:

DIVISION OF OIL & GAS
DEPARTMENT OF ENERGY

Larry L. Yost and Dennis L. Yost

being first duly sworn according to law depose and say that they are experienced in the work of plugging and filling oil and gas wells and were employed by Consolidation Coal Co., well operator, and participated in the work of plugging and filling the above well, that said work was commenced on the 17th day of August, 19 89, and that the well was plugged and filled in the following manner:

Sand or Zone Record Formation	Filling Material	Plugs Used Size & Kind	Casing	
			CSG PULLED	CSG LEFT IN
	Clean wellbore to 1310 ft.			
	Pulled 364 ft. of 8 1/2" casing. Pulled 506 ft. of 10" casing. Recleaned wellbore. Ran coal protection string as follows: 1100 ft. of 4 1/2" casing; 190 ft. of 2 3/8" tubing; Latchdown plug at 1077 ft.; Float valve at 1100 ft.; Swedge at 1100 ft. Circulated cement to surface as follows: 1,055 sacks of Poz Mix; 175 sacks of expanding type cement; 1,000 gal. of mud flush. Let set, bailed dry, set monument.	8 1/2" 10" 8 1/2"	364' 506'	TOP BOTTOM ?
Coal Seams		Description of Monument		
(Name) Pittsburgh - 930 ft.		6 ft. of 4 1/2" casing with plaque stating Consol		
(Name)		M1-502		
(Name)		47-61-0931		

and that the work of plugging and filling said well was completed on the 13th day of September, 19 89.

And further deponents saith not.

Sworn to and subscribed before me this 13th day of September, 19 89.

Larry L. Yost
Dennis L. Yost
Kella D. Wilson
Notary Public

My commission expires:

March 15, 1993

OCT 6 1989

Permit No. 47-61-0931