



Jamie 5/17/90

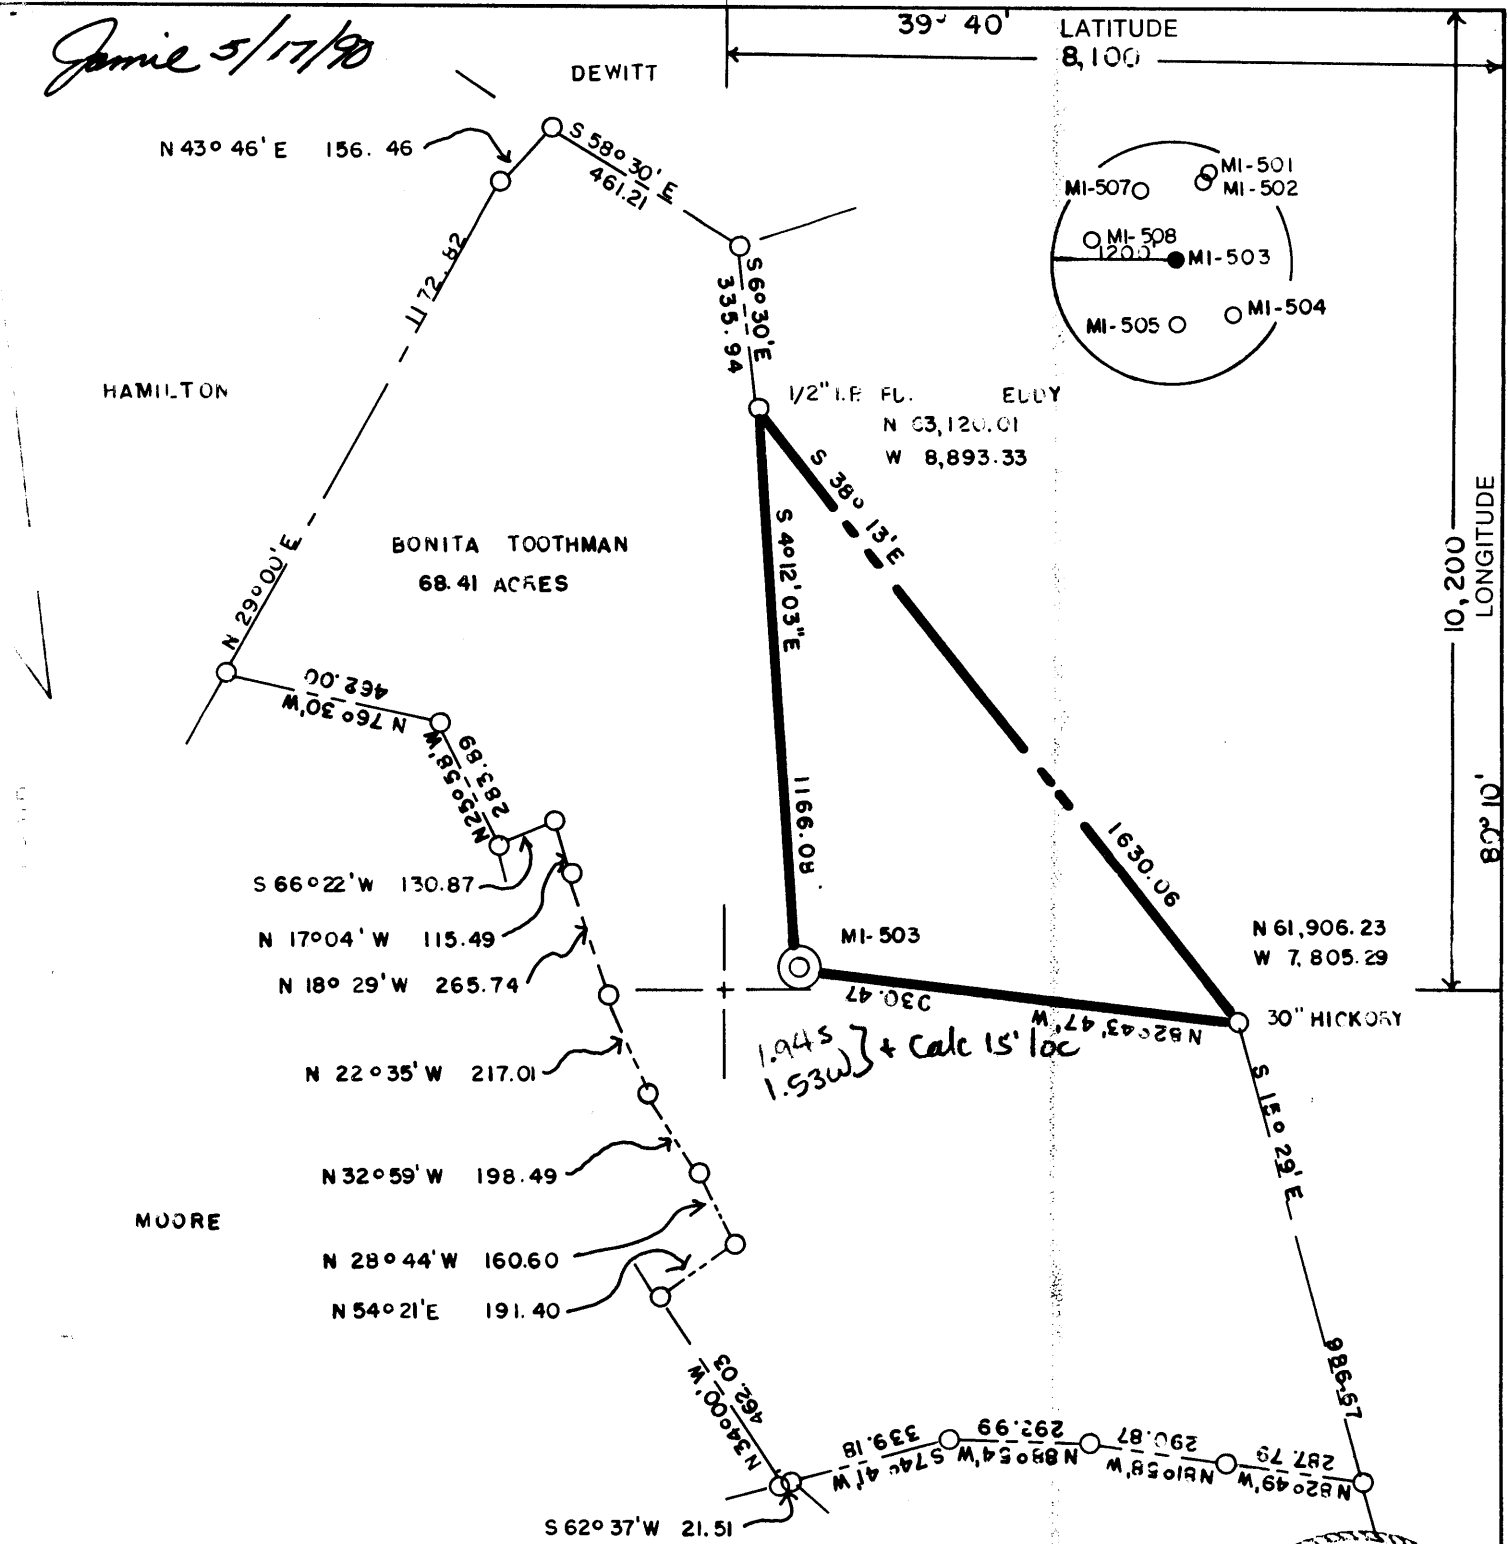

(+) DENOTES LOCATION OF WELL ON UNITED STATES TOPOGRAPHIC MAPS

FILE NO. _____
 DRAWING NO. _____
 SCALE 1" = 400'
 MINIMUM DEGREE OF ACCURACY 1 IN 5000
 PROVEN SOURCE OF ELEVATION COMPANY SURVEY TIED INTO U.S.G.S. NETWORK

I THE UNDERSIGNED, HEREBY CERTIFY THAT THIS PLAT IS CORRECT TO THE BEST OF MY KNOWLEDGE AND BELIEF AND SHOWS ALL THE INFORMATION REQUIRED BY LAW AND THE REGULATIONS ISSUED AND PRESCRIBED BY THE DEPARTMENT OF ENERGY.
 (SIGNED) Carl Morris
 R.P.E. _____ L.L.S. 460

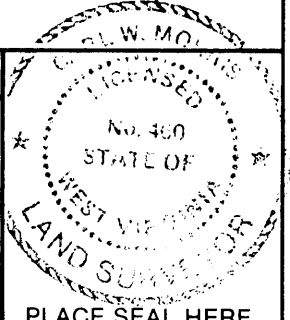

STATE OF WEST VIRGINIA
 DEPARTMENT OF ENERGY
 OIL AND GAS DIVISION

DATE 12-12, 19 88
 OPERATOR'S WELL NO. MI-503
 API WELL NO. 47-61-905-P

WELL TYPE: OIL GAS LIQUID INJECTION WASTE DISPOSAL
 (IF "GAS,") PRODUCTION STORAGE DEEP SHALLOW ABANDONED

LOCATION: ELEVATION 1293.07 WATERSHED JAKES RUN
 DISTRICT CLAY COUNTY MONONGALIA
 QUADRANGLE BLACKSVILLE W.V., PA. ± 15' WC

SURFACE OWNER BONITA TOOTHMAN ACREAGE 68.41
 OIL & GAS ROYALTY OWNER _____ LEASE ACREAGE _____
 LEASE NO. _____

PROPOSED WORK: DRILL CONVERT DRILL DEEPER REDRILL FRACTURE OR STIMULATE PLUG OFF OLD FORMATION PERFORATE NEW FORMATION OTHER PHYSICAL CHANGE IN WELL (SPECIFY) _____

PLUG AND ABANDON CLEAN OUT AND REPLUG
 TARGET FORMATION NONE ESTIMATED DEPTH _____
 WELL OPERATOR CONSOLIDATION COAL CO. DESIGNATED AGENT ROGER E. DUCKWORTH
 ADDRESS P.O. BOX 1314 MORGANTOWN W.V. 26505 ADDRESS P.O. BOX 1314 MORGANTOWN W.V. 26505

MAY 29 1990

COUNTY NAME
 PERMIT

MAR 06 91

Permitting
Oil and Gas Section

AFFIDAVIT OF PLUGGING AND FILLING WELL

AFFIDAVIT SHOULD BE MADE IN TRIPLICATE, one copy mailed to the Division, one copy to be retained by the Well Operator and the third copy (and extra copies if required) should be mailed to each coal operator at their respective addresses.

Consolidation Coal Co.
Coal Operator or Owner
P.O. Box 1314 Morgantown, W.Va. 26507-1314
Address

Consolidation Coal Co.
Coal Operator or Owner
P.O. Box 1314 Morgantown, W.Va. 26507-1314
Address

Bonita Toothman
Lease or Property Owner
Address

Consolidation Coal Co.
Name of Well Operator
P.O. Box 1314 Morgantown, W.Va. 26507-1314
Complete Address

February 11 19 91

WELL AND LOCATION

Clay District

Monongalia County

WELL NO. M1-503

Bonita Toothman Farm

STATE INSPECTOR SUPERVISING PLUGGING Don Ellis

AFFIDAVIT

STATE OF WEST VIRGINIA,
County of Monongalia
Larry L. Yost

ss:

and David D. Yost

being first duly sworn according to law depose and say that they are experienced in the work of plugging and filling oil and gas wells and were employed by Consolidation Coal Co., well operator, and participated in the work of plugging and filling the above well, that said work was commenced on the 24th day of January, 19 91, and that the well was plugged and filled in the following manner:

Sand or Zone Record Formation	Filling Material	Plugs Used Size & Kind	Casing	
			CSG PULLED	CSG LEFT IN
	Pulled 1400 ft. of 6 5/8" casing; Pulled 300 ft. of 8 1/4" casing. Cleaned wellbore to 1456 ft.	6 5/8"	1400 ft.	
	Ran coal protection string as follows; 930 ft. of 4 1/2" casing; 487 ft. of 2 3/8" tubing; Latch down plug at 909 ft.; Float valve at 930 ft.; Swedge at 931 ft.	BOTTOM-? 8 1/4"	300 ft.	
	Circulated cement to surface as follows: 550 sacks of Poz Mix; 400 sacks of expanding type cement; 1,000 gal. of mud flush.	TOP - 1400 ft. BOTTOM - ?		
	Let set, bailed dry, set monument.			
Coal Seams		Description of Monument		
(Name) Pittsburgh -752'-762'		6 ft. of 4 1/2" casing with plaque stating Consol		
(Name)		M1-503.		
(Name)		47-61-965-P		

and that the work of plugging and filling said well was completed on the 7th day of Feb., 19 91.

And further deponents saith not.

Sworn to and subscribed before me this 12th day of February, 19 91

Larry L. Yost
David D. Yost

Kelli D. Wilson
Notary Public

My commission expires:
March 15 1993

MAR 18 1991
Permit No. 47-61-965-P

