

Jan 5/31/90

39° 37' 30"


LATITUDE

1,800

3,900

LONGITUDE

80° 17' 30"

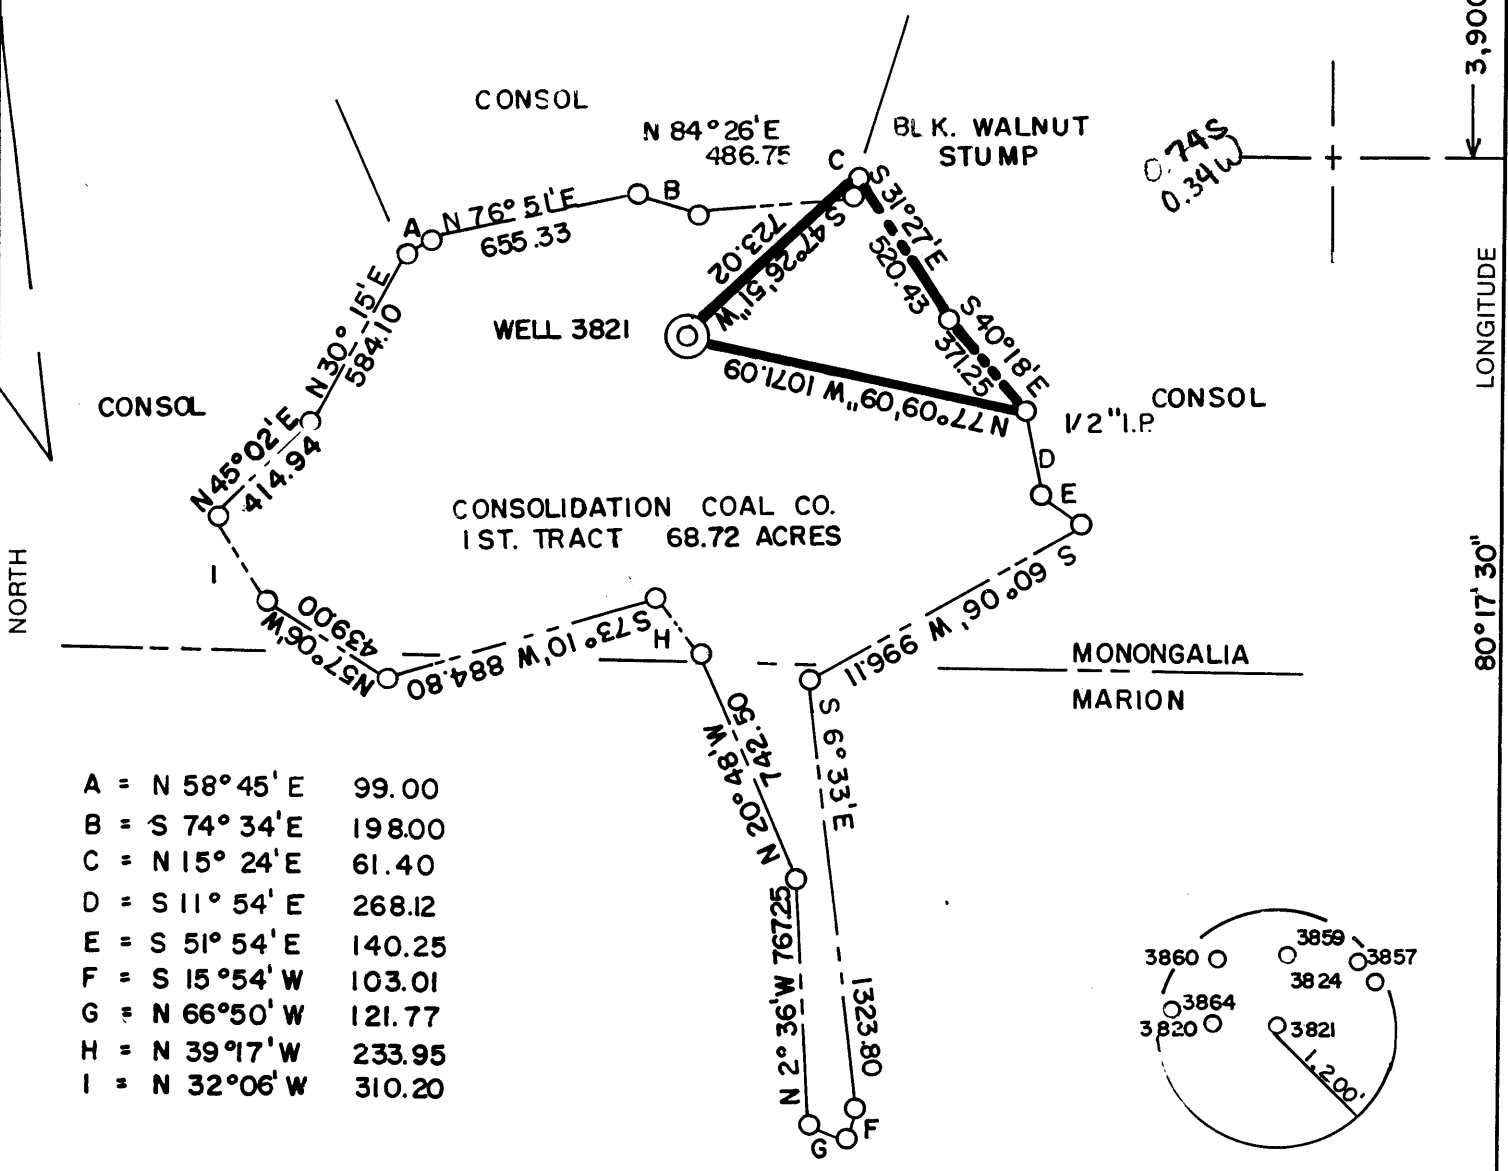

A = N 58° 45' E	99.00
B = S 74° 34' E	198.00
C = N 15° 24' E	61.40
D = S 11° 54' E	268.12
E = S 51° 54' E	140.25
F = S 15° 54' W	103.01
G = N 66° 50' W	121.77
H = N 39° 17' W	233.95
I = N 32° 06' W	310.20

Calc 15' loc
3.625
2.560

(+) DENOTES LOCATION OF WELL ON UNITED STATES TOPOGRAPHIC MAPS

FILE NO. _____
DRAWING NO. _____
SCALE 1" = 600'
MINIMUM DEGREE OF ACCURACY 1" IN 5000
PROVEN SOURCE OF ELEVATION COMPANY SURVEY TIED INTO U.S.G.S. NETWORK

I THE UNDERSIGNED, HEREBY CERTIFY THAT THIS PLAT IS CORRECT TO THE BEST OF MY KNOWLEDGE AND BELIEF AND SHOWS ALL THE INFORMATION REQUIRED BY LAW AND THE REGULATIONS ISSUED AND PRESCRIBED BY THE DEPARTMENT OF ENERGY.
(SIGNED) Paul D. Harbert
R.P.E. _____ L.L.S. 862

PLACE SEAL HERE

STATE OF WEST VIRGINIA
DEPARTMENT OF ENERGY
OIL AND GAS DIVISION

DATE 2-16, 19 89
OPERATOR'S WELL NO. 3821
API WELL NO. 47-61-0969-P

WELL TYPE: OIL GAS LIQUID INJECTION WASTE DISPOSAL
(IF "GAS,") PRODUCTION STORAGE DEEP SHALLOW ABANDONED

LOCATION: ELEVATION 1443.50 WATER SHED PAW PAW CREEK
DISTRICT BATTELLE COUNTY MONONGALIA
QUADRANGLE MANNINGTON W.V. & 15' C

SURFACE OWNER CONSOLIDATION COAL CO. ACREAGE 68.72
OIL & GAS ROYALTY OWNER _____ LEASE ACREAGE _____
LEASE NO. _____

PROPOSED WORK: DRILL CONVERT DRILL DEEPER REDRILL FRACTURE OR STIMULATE PLUG OFF OLD FORMATION PERFORATE NEW FORMATION OTHER PHYSICAL CHANGE IN WELL (SPECIFY) _____

PLUG AND ABANDON CLEAN OUT AND REPLUG

TARGET FORMATION NONE ESTIMATED DEPTH _____

WELL OPERATOR CONSOLIDATION COAL COMPANY DESIGNATED AGENT ROGER E. DUCKWORTH
ADDRESS P.O. BOX 1314 MORGANTOWN, W.V. 26505 ADDRESS P.O. BOX 1314 MORGANTOWN, W.V. 26505

JUN 11 1990

FORM WW-6
H.T. HALL 48673

COUNTY NAME

PERMIT

061-0969

AFFIDAVIT OF PLUGGING AND FILLING WELL

AFFIDAVIT SHOULD BE MADE IN TRIPLICATE, one copy mailed to the Division, one copy to be retained by the Well Operator and the third copy (and extra copies if required) should be mailed to each coal operator at their respective addresses.

Consolidation Coal Company
Coal Operator or Owner
P.O. Box 1314, Morgantown, WV 26507-1314
Address

Coal Operator or Owner
Address
Consolidation Coal Company
Lease or Property Owner
P. O. Box 1314, Morgantown, WV 26507-1314
Address

Consolidation Coal Company
Name of Well Operator
P. O. Box 1314, Morgantown, WV 26507-1314
Complete Address
August 11, 1990
WELL AND LOCATION
Battelle District
Monongalia County
WELL NO. #3821
Consolidation Coal Company Farm

STATE INSPECTOR SUPERVISING PLUGGING Don Ellis, Fairmont, WV 26554

AFFIDAVIT

STATE OF WEST VIRGINIA,
County of Harrison ss:

Calvin C. Lofton and George R. Gore

being first duly sworn according to law depose and say that they are experienced in the work of plugging and filling oil and gas wells and were employed by Consolidation Coal Company, well operator, and participated in the work of plugging and filling the above well, that said work was commenced on the 22nd day of JULY 19 90, and that the well was plugged and filled in the following manner:

Sand or Zone Record Formation	Filling Material	Plugs Used Size & Kind	Casing	
			CSG PULLED	CSG LEFT IN
Cleaned 9 7/8" hole to 1,370'. Reduced hole to 7 7/8"				
Cleaned 7 7/8" hole 1,370' - 1,538'. Reduced hole to 6 1/2".				
Cleaned 6 1/2" hole from 1,538' to 1,629'. Cleaned 9 7/8" hole thru Pittsburgh Coal from 1,136' to 1,144'. Ran mine protection string as follows: 260.07' of 2 3/8" tubing followed by 1,340.15' of 4 1/2" casing. Latch down plug at 1,306.16'. Flat valve at 1,340.15'. Swedge at 1,341.15'. Circulated cement to surface as follows: Pumped 1,000 sacks of poz mix followed by 295 sacks of thixotropic cement. Used 1,000 gallons of mud flush. Displaced cement to 1,306.16' with water. Let set and bailed dry. Cemented hole from 1,600' back to surface.				
TOTAL DEPTH: 1,600.22 feet				
Coal Seams			Description of Monument	
(Name) Pittsburgh	1,136 feet to 1,144 feet	5 feet of 4 1/2" casing with plaque stating:		
(Name)		Consol WV #3821		
(Name)		#47-061-0969-P		
(Name)				


and that the work of plugging and filling said well was completed on the 30th day of July, 19 90.

And further deponents saith not.

Sworn to and subscribed before me this 11th day of August 19 90

My commission expires:

June 29, 1999



 Charlotte Heater
 Notary Public
 State of West Virginia
 Mt. I, Box 664
 #47-061-0969-P
 expires June 27, 1999

DEC 14 1990