


*Final*  
8/17/90

LATITUDE 39°42'30"

11,200'

LONGITUDE 80°12'30"

7,000'

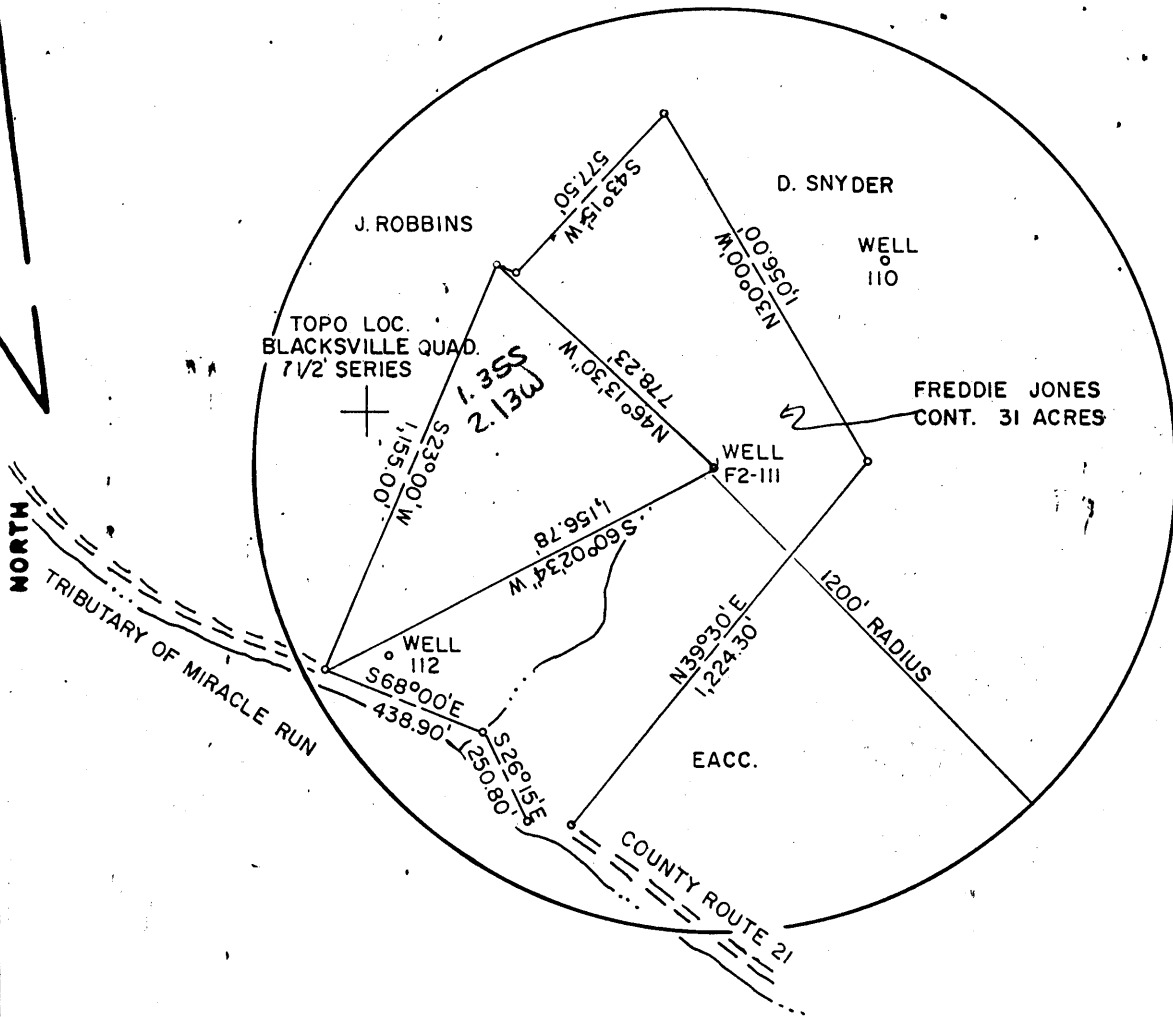


*Calc 15' loc*  
4.235  
4.35w

FILE NO. F2-1-178  
DRAWING NO. F2-2-205  
SCALE 1"=500'  
MINIMUM DEGREE OF ACCURACY 1/2500'  
PROVEN SOURCE OF ELEVATION USGS BM.

I THE UNDERSIGNED, HEREBY CERTIFY THAT THIS PLAT IS CORRECT TO THE BEST OF MY KNOWLEDGE AND BELIEF AND SHOWS ALL THE INFORMATION REQUIRED BY LAW AND THE REGULATIONS ISSUED AND PRESCRIBED BY THE DEPARTMENT OF MINES.

(SIGNED) Gary Halstead  
R.P.E. 9235 L.L.S.

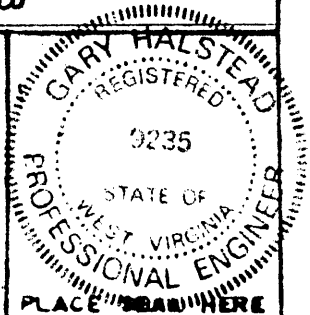

(+) DENOTES LOCATION OF WELL ON UNITED STATES TOPOGRAPHIC MAPS  
FORM IV-6  
(8-78)



DATE JULY 9, 1990  
OPERATOR'S WELL NO F2-III  
API WELL NO 47 061  
STATE COUNTY 0976-P PERMIT

STATE OF WEST VIRGINIA  
DEPARTMENT OF MINES  
OIL AND GAS DIVISION

WELL TYPE: OIL  GAS  LIQUID INJECTION \_\_\_\_\_ WASTE DISPOSAL \_\_\_\_\_  
( IF "GAS", PRODUCTION \_\_\_\_\_ STORAGE \_\_\_\_\_ DEEP \_\_\_\_\_ SHALLOW  )  
LOCATION: ELEVATION 1,215' WATER SHED MIRACLE RUN  
DISTRICT BATTELLE COUNTY MONONGALIA  
QUADRANGLE BLACKSVILLE 7 1/2' 4 (S'NW)  
SURFACE OWNER FREDDIE LEE JONES ACREAGE 31  
OIL & GAS ROYALTY OWNER FORMERLY EQUITABLE GAS CO. LEASE ACREAGE \_\_\_\_\_  
LEASE NO. \_\_\_\_\_  
PROPOSED WORK: DRILL \_\_\_\_\_ CONVERT \_\_\_\_\_ DRILL DEEPER \_\_\_\_\_ REDRILL  FRACTURE OR STIMULATE \_\_\_\_\_ PLUS OFF OLD FORMATION \_\_\_\_\_ PERFORATE NEW FORMATION \_\_\_\_\_ OTHER PHYSICAL CHANGE IN WELL (SPECIFY) \_\_\_\_\_  
PLUS AND ABANDON  CLEAN' OUT AND REPLUS \_\_\_\_\_  
TARGET FORMATION \_\_\_\_\_ ESTIMATED DEPTH \_\_\_\_\_ AUG 10 1990  
WELL OPERATOR EASTERN ASSOC. COAL CORP. DESIGNATED AGENT TERRY O. HENDERSHOT  
ADDRESS ROUTE 1 BOX 144 FAIRVIEW W. VA. 26570 ADDRESS ROUTE 1 BOX 144 FAIRVIEW W. VA. 26570

DEPT of Energy  
SEPT 10 00  
Permitting  
Oil and Gas

STATE OF WEST VIRGINIA  
DEPARTMENT OF ENERGY  
DIVISION OF OIL AND GAS

EACC - F2-111

AFFIDAVIT OF PLUGGING AND FILLING WELL

AFFIDAVITE SHOULD BE IN TRIPLICATE, one copy mailed to the Division, one copy to be retained by the Well Operator and the third copy (and extra copies if required) should be mailed to each coal operator at their respective addresses.

Farm name: JONES, FREDDIE Operator Well No.: F2-111 ,(5061)#

LOCATION: Elevation: 1215.00 Quadrangle: BLACKSVILLE  
District: BATTELLE County: MONONGALIA  
Latitude: 7000 Feet South of 39 Deg. 42 Min. 30 Sec.  
Longitude 11200 Feet West of 80 Deg. 12 Min. 30 Sec.

Well Type: OIL   X   GAS   X  

Company: Eastern Associated Coal Corp.  
Route 1 Box 144  
Fairview, WV 26570

Coal Operator Eastern Associated Coal Corp.  
or Owner Route 1 Box 144  
Fairview, WV 26570

Agent: Terry O. Hendershot  
Inspector: Donald Ellis  
Permit Issued: 08/08/90

Coal Operator \_\_\_\_\_  
or Owner \_\_\_\_\_

AFFIDAVIT

STATE OF WEST VIRGINIA,  
County of Monongalia ss:

Melvin Eddy and Roy Smith being first duly sworn according to law depose and say that they are experienced in the work of plugging and filling oil and gas wells and were employed by Chisler Brothers, well operator, and participated in the work of plugging and filling the above well, that said work was commenced on the 22 day of August, 1990, and that the well was plugged and filled in the following manner:

TYPE	FROM	TO	PIPE REMOVED	LEFT
Cleaned out to total depth of	1350'			
Pulled 1 joint of old 8"	pipe had been	shot top of old 8"	610'	
logged well gamma ray neutron & 3 arm caliper				
Run 4 1/2" pipe to 1254	gelled hole with	35 sack gell		
Pulled 4 1/2" pipe to	1020 Run 460 sacks	Portland &	150 sack chem comp	& got
circulation, pumped latch down plug to	1000'			
Bailed water out inside	4 1/2" & checked	plug		
Pittsburgh Coal 907 to 916				

Description of monument: 4 1/2" x 2" swedge 2" pipe with Metal Plate  
Date plugged, API No. & Well No.

and that the work of plugging and filling said well was completed on the 6 day of September, 1990.

And furthur deponents saith not.

Sworn and subscribe before me this 10th day of September, 1990  
My commission expires June 17, 1997

Melvin Eddy  
Roy Smith  
William J. Kettle  
Notary Public  
OCT 1 1990