


INSTRUCTIONS

LATITUDE 39° 40' 00"

- 1) Attach a photo copy of the location of the well on a 7.5 minute Quadrangle with the corresponding Longitude and Latitude.
- 2) Designate the location of the well with the symbol(+).

LONGITUDE 80° 07' 30"

8390'

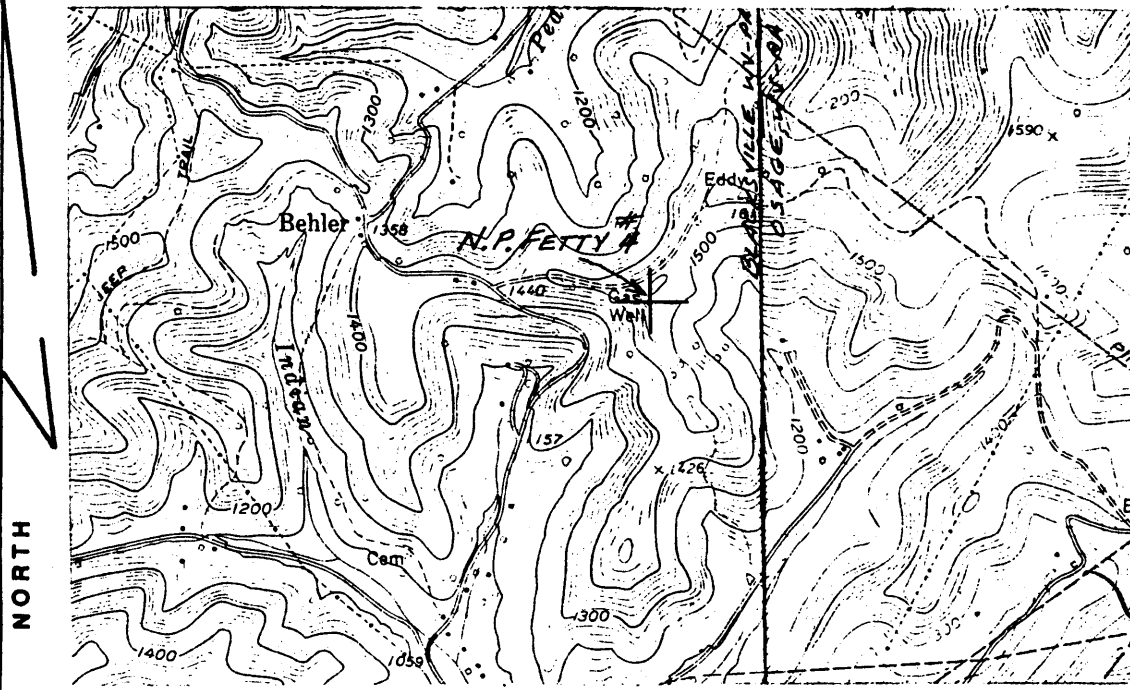

I, the undersigned, hereby certify that this plat is correct to the best of my knowledge and belief.

SIGNED Harry Eddy

TITLE Harry Eddy

DATE NOVEMBER 6, 1989

OPERATORS WELL NO. N.P. FETTY #4

API WELL NO. 061-0998

STATE OF WEST VIRGINIA  
DEPARTMENT OF ENERGY  
OIL AND GAS DIVISION

WELL TYPE: OIL      GAS X LIQUID INJECTION      WASTE DISPOSAL       
(IF "GAS" PRODUCTION X STORAGE      DEEP      SHALLOW X)

LOCATION: ELEVATION 1585 WATER SHED MONONGAHELA RIVER  
DISTRICT CLAY 3 COUNTY MONONGALIA  
QUADRANGLE BLACKSVILLE, WV-PA

SURFACE OWNER MARK & HARRY EDDY ACREAGE 48.37 AC.

OIL & GAS ROYALTY OWNER MARK & HARRY EDDY LEASE ACREAGE 48.37 AC.  
LEASE NO.     

PRODUCING FORMATION BIG INJUN TOTAL DEPTH 1800-2400'

WELL OPERATOR MARK & HARRY EDDY DESIGNATED AGENT     

ADDRESS ROUTE 1, BOX 43 ADDRESS       
CORE, WV 26529

11790