


Calc 15' loc
3.755
1.64W

FILE NO. F2-1-176
DRAWING NO. F2-2-211
SCALE 1"=500'
MINIMUM DEGREE OF ACCURACY 1/2500'
PROVEN SOURCE OF ELEVATION USGS BM

I THE UNDERSIGNED, HEREBY CERTIFY THAT THIS PLAT IS CORRECT TO THE BEST OF MY KNOWLEDGE AND BELIEF AND SHOWS ALL THE INFORMATION REQUIRED BY LAW AND THE REGULATIONS ISSUED AND PRESCRIBED BY THE DEPARTMENT OF MINES.
(SIGNED) Gary Halstead
R.P.E. 9235 L.L.S.

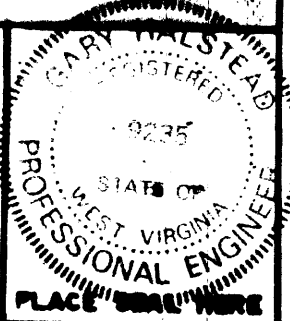

(+) DENOTES LOCATION OF WELL ON UNITED STATES TOPOGRAPHIC MAPS
FORM IV-6
(8-78)



DATE JANUARY 8, 1921
OPERATOR'S WELL NO. F2-429
API WELL NO. 47-001
STATE WV COUNTY MONONGALIA PERMIT 1004-P

STATE OF WEST VIRGINIA
DEPARTMENT OF MINES
OIL AND GAS DIVISION

WELL TYPE: OIL X GAS _____ LIQUID INJECTION _____ WASTE DISPOSAL _____
(IF "GAS", PRODUCTION _____ STORAGE _____ DEEP _____ SHALLOW X)
LOCATION: ELEVATION 1031' WATER SHED RT. BRANCH MIRACLE RUN
DISTRICT BATTELLE COUNTY MONONGALIA
QUADRANGLE WADESTOWN Mannington N4
SURFACE OWNER MODIE ORD ACREAGE 49.30
OIL & GAS ROYALTY OWNER FORMERLY SOUTH PENN OIL LEASE ACREAGE 50
LEASE NO. _____
PROPOSED WORK: DRILL _____ CONVERT _____ DRILL DEEPER _____ REDRILL X FRACTURE OR STIMULATE _____ PLUS OFF OLD FORMATION _____ PERFORATE NEW FORMATION _____ OTHER PHYSICAL CHANGE IN WELL (SPECIFY) _____
PLUG AND ABANDON X CLEAN OUT _____ AND REPLUG _____
TARGET FORMATION GORDON SAND ESTIMATED DEPTH 2984'
WELL OPERATOR EASTERN ASSOC. COAL CORP. DESIGNATED AGENT TERRY O. HENDERSHOT
ADDRESS ROUTE 1 BOX 144 ADDRESS ROUTE 1 BOX 144
FAIRVIEW W. VA. 26570 FAIRVIEW W. VA 26570

RUFUS BELL NO. 2 WELL.

No. 6 O.P. - Monongalia.
No. 68 MMT Rept., p....

Battelle District, Monongalia County, W. Va.
By South Penn Oil Co.
Elevation, 1030' B.

NO. 68 MMT REPT. (100)

	Top.	Bottom.
Pittsburgh Coal	742	
Big Injun Sand	1991	- 2230
50-Ft. Sand	2667	- 2755
Campbells Run Sand (?)	2877	- 2901
Gordon (pay, 2980')		
Total depth		3001

STATE OF WEST VIRGINIA
DEPARTMENT OF ENERGY
DIVISION OF OIL AND GAS

AFFIDAVIT OF PLUGGING AND FILLING WELL

AFFIDAVIT SHOULD BE IN TRIPLICATE, one copy mailed to the Division, one copy to be retained by the Well Operator and the third copy (and extra copies if required) should be mailed to each coal operator at their respective addresses.

Farm name: ORD, MAUDIE Operator Well No.: F2-429 (2)

LOCATION: Elevation: 1031.00 Quadrangle: WADESTOWN
District: BATTELLE County: MONONGALIA
Latitude: 4600 Feet South of 39 Deg. 42 Min. 30 Sec.
Longitude 8625 Feet West of 80 Deg. 15 Min. 0 Sec.

Well Type: OIL X GAS _____

Company: Eastern Associated Coal Corp. Coal Operator Eastern Associated Coal Co
Route 1 Box 144 or Owner Route 1, Box 144
Fairview, WV 26570 Fairview, WV 26570

Agent: Terry O. Hendershot Coal Operator _____
Inspector: Donald Ellis or Owner _____
Permit Issued: 02/06/91

AFFIDAVIT

STATE OF WEST VIRGINIA,
County of Monongalia ss:

Melvin Eddy and Danny Stoneking being first duly sworn according to law depose and say that they are experienced in the work of plugging and filling oil and gas wells and were employed by Chisler Brothers, well operator, and participated in the work of plugging and filling the above well, that said work was commenced on the 18 day of February, 1991, and that the well was plugged and filled in the following manner:

TYPE	FROM	TO	PIPE REMOVED	LEFT
Cleaned out to depth of	1258			
Run logged Gamma Ray,	Neutron & 3 arm	Caliper		
Run 4 1/2" pipe to 1258'	Circulated hole			
Run 220 sacks Portland	& 150 sacks	Chem Comp.		
Pulled 4 1/2" pipe to 858'	Run 330 sacks	Portland & 120	sacks Chem. Comp.	
Dumped Latch down plug	to 837'			
Cement Circulated				
		Old 8" pipe	756 to 1227	
Pittsburgh Coal 733-740		New 4 1/2" pipe	from surface to 858'	

Description of monument: 4 1/2" x 2" Swedge, 2" pipe with metal plate date plugged and A.P.I. No.

and that the work of plugging and filling said well was completed on the 8 day of March, 1991.

And furthur deponents saith not.

Sworn and subscribe before me this 11th day of March, 1991

My commission expires: June 17, 1997

Melvin Eddy
Danny Stoneking
William J. Tuttle
Notary Public

MAR 20 1991