


INSTRUCTIONS

RECEIVED
DIVISION OF ENERGY

JUN 24 91

Permitting
Oil and Gas Section

1) Attach a photo copy of the location of the well on a 7.5 minute Quadrangle with the corresponding Longitude and Latitude.
2) Designate the location of the well with a black dot.

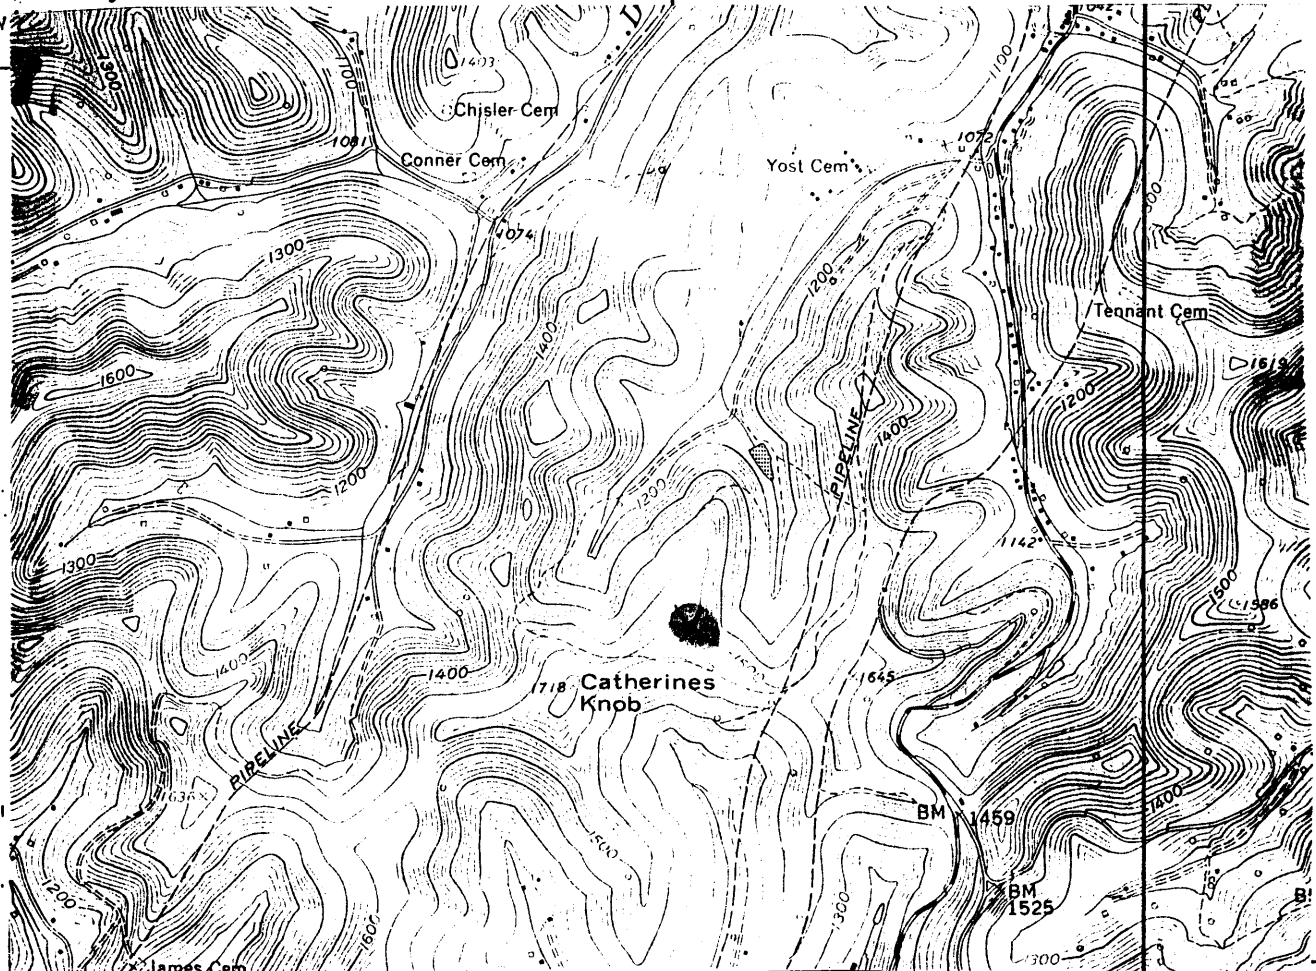

1500
80° 12' 30"

I, the undersigned, hereby certify that this plat is correct to the best of my knowledge and belief.

SIGNED Larry L. Yost
TITLE Pres.

DATE June 20, 1991
OPERATORS WELL NO. 8
API WELL NO. 061-1047

STATE OF WEST VIRGINIA
DEPARTMENT OF ENERGY
OIL AND GAS DIVISION

WELL TYPE: OIL X GAS _____ LIQUID INJECTION _____ WASTE DISPOSAL _____
(i.e. "GAS" PRODUCTION _____ STORAGE _____ DEEP _____ SHALLOW _____)

LOCATION: ELEVATION 1540 WATER SHED TRIBUTARY TO DAYS RUN
DISTRICT CLAY COUNTY MONROVIA
QUADRANGLE BLACKSVILLE

SURFACE OWNER Daybrook Development Co. ACREAGE 75

OIL & GAS ROYALTY OWNER L.S. Yost Heirs LEASE ACREAGE 10
LEASE NO. 12879

PRODUCING FORMATION Fifth Sand TOTAL DEPTH 3592 ft.

WELL OPERATOR Daybrook Development Co. DESIGNATED AGENT Larry L. Yost

ADDRESS Rt.2 Box 193 Fairview, W.Va. 26570 ADDRESS Same

Blacksville 7