


Jamie  
3/6/92

39° 40' 00" LATITUDE

11,350

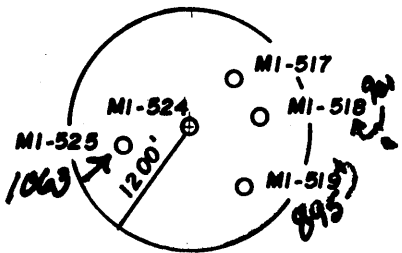


IVAN WILSON

1.80 S  
2.17 W

NORTH

9700 LONGITUDE

80° 10'

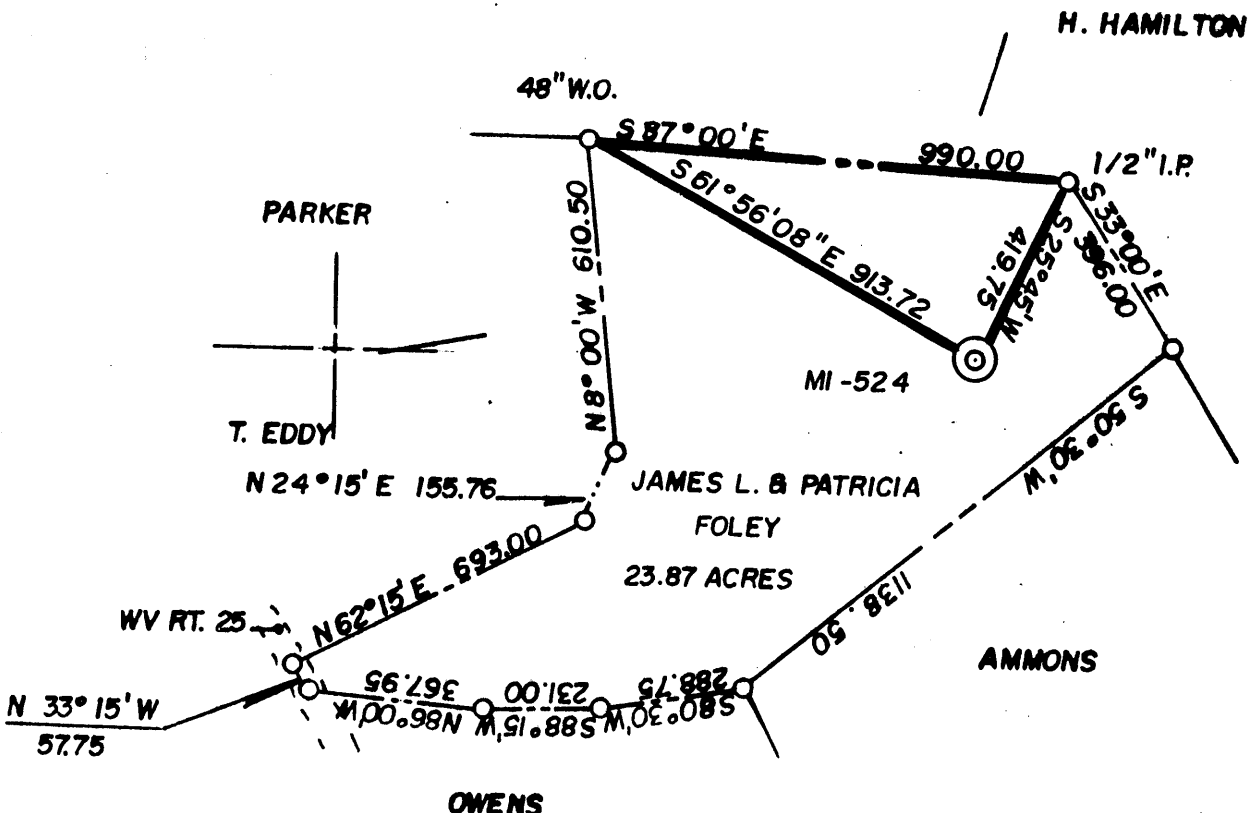

(+) DENOTES LOCATION OF WELL ON UNITED STATES TOPOGRAPHIC MAPS

FILE NO. \_\_\_\_\_  
DRAWING NO. \_\_\_\_\_  
SCALE 1" = 400'  
MINIMUM DEGREE OF ACCURACY 1 IN 5000  
PROVEN SOURCE OF ELEVATION COMPANY SURVEY TIED INTO U.S.G.S. NETWORK

I THE UNDERSIGNED, HEREBY CERTIFY THAT THIS PLAT IS CORRECT TO THE BEST OF MY KNOWLEDGE AND BELIEF AND SHOWS ALL THE INFORMATION REQUIRED BY LAW AND THE REGULATIONS ISSUED AND PRESCRIBED BY THE DEPARTMENT OF ENERGY.

(SIGNED) Paul D. Harbert

R.P.E. \_\_\_\_\_ L.L.S. 862

PLACE SEAL HERE

STATE OF WEST VIRGINIA  
DEPARTMENT OF ENERGY  
OIL AND GAS DIVISION



DATE 2-7, 19 92  
OPERATOR'S WELL NO. MI-524  
API WELL NO. \_\_\_\_\_

WELL TYPE: OIL \_\_\_ GAS \_\_\_ LIQUID INJECTION \_\_\_ WASTE DISPOSAL \_\_\_  
(IF "GAS,") PRODUCTION \_\_\_ STORAGE \_\_\_ DEEP \_\_\_ SHALLOW X ABANDONED X  
LOCATION: ELEVATION 1416.01 WATERSHED JAKES RUN STATE 47 COUNTY 61 PERMIT 1062-P

DISTRICT CLAY COUNTY MONONGALIA  
QUADRANGLE BLACKSVILLE WV, PA

SURFACE OWNER JAMES L. & PATRICIA D. FOLEY ACREAGE 23.87  
OIL & GAS ROYALTY OWNER \_\_\_\_\_ LEASE ACREAGE \_\_\_\_\_

LEASE NO. \_\_\_\_\_  
PROPOSED WORK: DRILL \_\_\_ CONVERT \_\_\_ DRILL DEEPER \_\_\_ REDRILL \_\_\_ FRACTURE OR STIMULATE \_\_\_ PLUG OFF OLD FORMATION \_\_\_ PERFORATE NEW FORMATION \_\_\_ OTHER PHYSICAL CHANGE IN WELL (SPECIFY) \_\_\_\_\_

PLUG AND ABANDON \_\_\_ CLEAN OUT AND REPLUG X  
TARGET FORMATION NONE ESTIMATED DEPTH \_\_\_\_\_

WELL OPERATOR CONSOLIDATION COAL CO. DESIGNATED AGENT ROGER E. DUCKWORTH  
ADDRESS P.O. BOX 1314 MORGANTOWN W.V. 26505 ADDRESS P.O. BOX 1314 MORGANTOWN W.V. 26505

COUNTY NAME

PERMIT

FORM WW-6

STATE OF WEST VIRGINIA  
DEPARTMENT OF ENERGY  
OIL AND GAS WELLS DIVISION

RECEIVED  
WV Dept. of Energy  
Environmental Protection  
MAY 26 94  
Permitting  
Office of the

AFFIDAVIT OF PLUGGING AND FILLING WELL

AFFIDAVIT SHOULD BE MADE IN TRIPPLICATE, one copy mailed to the Division, one copy to be retained by the Well Operator and the third copy (and extra copies if required) should be mailed to each coal operator at their respective addresses.

Consolidation Coal Co.  
Coal Operator or Owner  
P.O. Box 1314 Morgantown, W.Va. 26507  
Address  
Consolidation Coal Co.  
Coal Operator or Owner  
P.O. Box 1314 Morgantown, W.Va. 26507  
Address  
James L. & Patricia D. Foley  
Lease or Property Owner  
Rt. 2 Fairview, W.Va. 26570  
Address

Consolidation Coal Co.  
Name of Well Operator  
P.O. Box 1314 Morgantown, W.Va. 26507  
Complete Address  
April 16 19 92  
WELL AND LOCATION  
Clay District  
Monongalia County  
WELL NO. M1-524

James L. & Patricia D. Foley Farm

STATE INSPECTOR SUPERVISING PLUGGING Randall Mick

AFFIDAVIT

STATE OF WEST VIRGINIA,  
County of Monongalia

ss:

Larry L. Yost and Dennis L. Yost

being first duly sworn according to law depose and say that they are experienced in the work of plugging and filling oil and gas wells and were employed by Consolidation Coal Co., well operator, and participated in the work of plugging and filling the above well, that said work was commenced on the 30th day of March, 19 92, and that the well was plugged and filled in the following manner:

Sand or Zone Record Formation	Filling Material	Plugs Used Size & Kind	Casing	
			CSG PULLED	CSG LEFT IN
	Pulled 135 ft. of 7" pipe,	7"-	135ft.	
	Pulled 100 ft. of 8 1/4" pipe.	TOP -1225'		
	Pulled 190 ft. of 10" pipe.	8 1/4" 100ft.		
	Shot off 60 shots from 933 ft. to 953 ft.	TOP- 1080'		
	Cleaned wellbore to 1407 ft.	10"- 190ft.		
	Ran coal protection string as follows; 1106 ft. of 4 1/2" casing; 260 ft. of 2 3/8" tubing; Latch down plug at 1085 ft.; Float valve at 1106 ft.; Swedge at 1107 ft. Circulated cement to surface as follows; 590 sacks of Poz Mix; 345 sacks of expanding type cement; 1,000 gal. of	Description of Monument		
(Name) Pittsburgh-938'-	mud flush. Let set, bailed	6 ft. of 4 1/2" casing		
(Name) 946'	dry, set monument.	with plaque stating		
(Name)		Consol M1-524		
(Name)		47-061-1062-P		

and that the work of plugging and filling said well was completed on the 10th day of April, 19 92.

And further deponents saith not.



OFFICIAL SEAL  
Notary Public, State of West Virginia  
and CHARLES A. SKINNER before me this 20th day of April, 19 92.  
RT. 2, BOX 184  
FAIRVIEW, WV 26570

My Commission Expires March 12, 2002  
My commission expires:

March 12, 2002

Larry L. Yost  
Dennis L. Yost  
Charles A. Skinner  
Notary Public

MAY 27 1994

Permit No. 47-061-1062-P