


*Janie*  
1/11/93

39° 40' LATITUDE

1,740

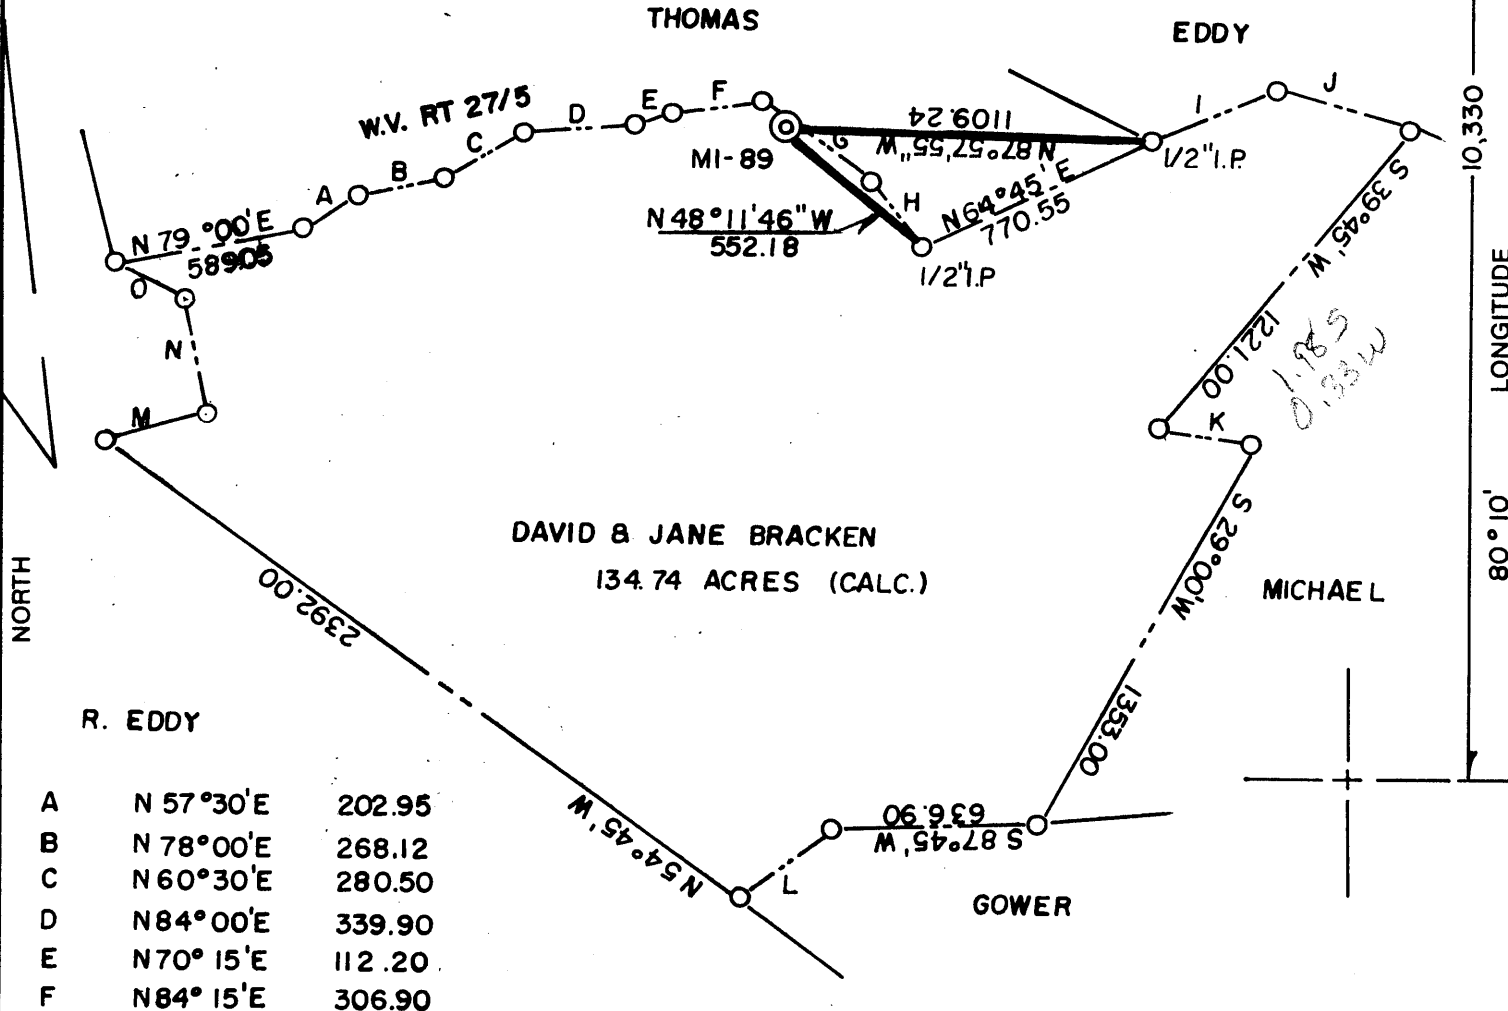


NORTH

10,330  
LONGITUDE  
80° 10'

R. EDDY

A	N 57°30'E	202.95
B	N 78°00'E	268.12
C	N 60°30'E	280.50
D	N 84°00'E	339.90
E	N 70°15'E	112.20
F	N 84°15'E	306.90
G	S 54°00'E	397.65
H	S 35°15'E	254.10
I	N 66°30'E	394.35
J	S 73°15'E	440.55
K	S 82°30'E	297.00
L	S 52°30'W	353.10

M	N 71°45'E	321.75
N	N 11°00'W	364.25
O	N 54°57'48"W	216.12

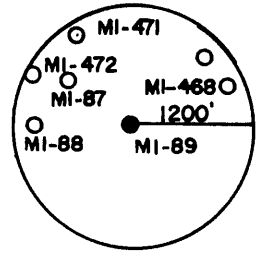

(+) DENOTES LOCATION OF WELL ON UNITED STATES TOPOGRAPHIC MAPS

FILE NO. \_\_\_\_\_  
DRAWING NO. \_\_\_\_\_  
SCALE 1" = 600'  
MINIMUM DEGREE OF ACCURACY 1 IN 5000  
PROVEN SOURCE OF ELEVATION COMPANY SURVEY  
TIED INTO USGS NETWORK

I THE UNDERSIGNED, HEREBY CERTIFY THAT THIS PLAT IS CORRECT TO THE BEST OF MY KNOWLEDGE AND BELIEF AND SHOWS ALL THE INFORMATION REQUIRED BY LAW AND THE REGULATIONS ISSUED AND PRESCRIBED BY THE DEPARTMENT OF ENERGY.  
(SIGNED) Paul D. Halbert  
R.P.E. \_\_\_\_\_ L.L.S. 862

PLACE SEAL HERE

**STATE OF WEST VIRGINIA**  
**DEPARTMENT OF ENERGY**  
**OIL AND GAS DIVISION**



DATE 12-15, 19 92  
OPERATOR'S WELL NO. MI-89  
API WELL NO. 47-000-1089-P

WELL TYPE: OIL \_\_\_ GAS \_\_\_ LIQUID INJECTION \_\_\_ WASTE DISPOSAL \_\_\_ STATE COUNTY PERMIT  
(IF "GAS,") PRODUCTION \_\_\_ STORAGE \_\_\_ DEEP \_\_\_ SHALLOW X ABANDONED X

LOCATION: ELEVATION 1390.00 WATERSHED JAKES RUN  
DISTRICT CLAY COUNTY MONONGALIA

QUADRANGLE BLACKSVILLE  
SURFACE OWNER DAVID & JANE BRACKEN ACREAGE 134.74

OIL & GAS ROYALTY OWNER \_\_\_\_\_ LEASE ACREAGE \_\_\_\_\_  
LEASE NO. \_\_\_\_\_

PROPOSED WORK: DRILL \_\_\_ CONVERT \_\_\_ DRILL DEEPER \_\_\_ REDRILL \_\_\_ FRACTURE OR  
STIMULATE \_\_\_ PLUG OFF OLD FORMATION \_\_\_ PERFORATE NEW  
FORMATION \_\_\_ OTHER PHYSICAL CHANGE IN WELL (SPECIFY) \_\_\_\_\_

PLUG AND ABANDON X CLEAN OUT AND REPLUG \_\_\_\_\_

TARGET FORMATION \_\_\_\_\_ ESTIMATED DEPTH \_\_\_\_\_  
WELL OPERATOR CONSOLIDATION COAL CO. DESIGNATED AGENT ROGER DUCKWORTH  
ADDRESS P.O. BOX 1314 MORGANTOWN, WV 26505 ADDRESS P.O. BOX 1314 MORGANTOWN, WV 26505

FORM WW-6  
HALLS INC. 068065

COUNTY NAME  
PERMIT

FORM WR-38  
(Affidavit of Plugging)

STATE OF WEST VIRGINIA  
DEPARTMENT OF ENERGY  
OIL AND GAS WELLS DIVISION

61-1089  
RECEIVED  
DEC 1 1993

AFFIDAVIT OF PLUGGING AND FILLING WELL

AFFIDAVIT SHOULD BE MADE IN TRIPPLICATE, one copy mailed to the Division, one copy to be retained by the Well Operator and the third copy (and extra copies if required) should be mailed to each coal operator at their respective addresses.

<u>Consolidation Coal Co.</u> Coal Operator or Owner P.O. Box 1314 Morgantown, W.Va. 26507 Address	<u>Consolidation Coal Co.</u> Name of Well Operator P.O. Box 1314 Morgantown, W.Va. 26507 Complete Address
<u>Consolidation Coal Co.</u> Coal Operator or Owner P.O. Box 1314 Morgantown, W.Va. Address	July 15 19 93 WELL AND LOCATION
<u>David &amp; Jane Bracken</u> Lease or Property Owner Rt. 2 Box 68 Fairview, W.Va. 26570 Address	Clay District Monongalia County WELL NO. M1-89
	David & Jane Bracken Farm

STATE INSPECTOR SUPERVISING PLUGGING

AFFIDAVIT

STATE OF WEST VIRGINIA,  
County of Monongalia

ss:

Larry L. Yost and Dennis L. Yost

being first duly sworn according to law depose and say that they are experienced in the work of plugging and filling oil and gas wells and were employed by Consolidation Coal Co., well operator, and participated in the work of plugging and filling the above well, that said work was commenced on the 30th day of June 19 93, and that the well was plugged and filled in the following manner:

Sand or Zone Record Formation	Filling Material	Plugs Used Size & Kind	Casing	
			CSG PULLED	CSG LEFT IN
	Cleaned wellbore to 1302 ft.	8 1/2"	427'	
	Pulled 427' of 8 1/2" casing.			
	Ran coal protection string as follows; 962 ft. of 4 1/2" casing; 280 ft. of 2 3/8" tubing; Latchdown plug at 940 ft.; Float valve at 962 ft.; Swedge at 962 ft.	TOP - 1192' BOTTOM - ?		
	Circulated cement to surface as follows: 550 sacks of Poz Mix; 380 sacks of expanding type cement; 1,000 gal. of mud flush. Let set, bailed dry, set monument.			
Coal Seams	Description of Monument			
(Name) Pittsburgh -814'-824'	6 ft. of 4 1/2" casing with plaque stating Conso			
(Name)	M1-89.			
(Name)	47-061-1089-B			

and that the work of plugging and filling said well was completed on the 15th day of July 19 93.

And further deponents saith not.

Sworn to and subscribed before me this 15th day of July 19 93.

Larry L. Yost  
Dennis L. Yost  
Cheryl A. Skinner  
Notary Public

My commission expires:  
MARCH 12 2002



OFFICIAL SEAL  
Notary Public, State of West Virginia  
CHEL A. SKINNER  
RT. 2, BOX 184  
FAIRVIEW, WV 26530

Permit No. 47-061-1089-P  
DEC 0 1993