
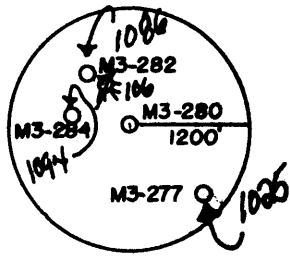


39°42'30" LATITUDE 1,700

*Janice 8/30/93*

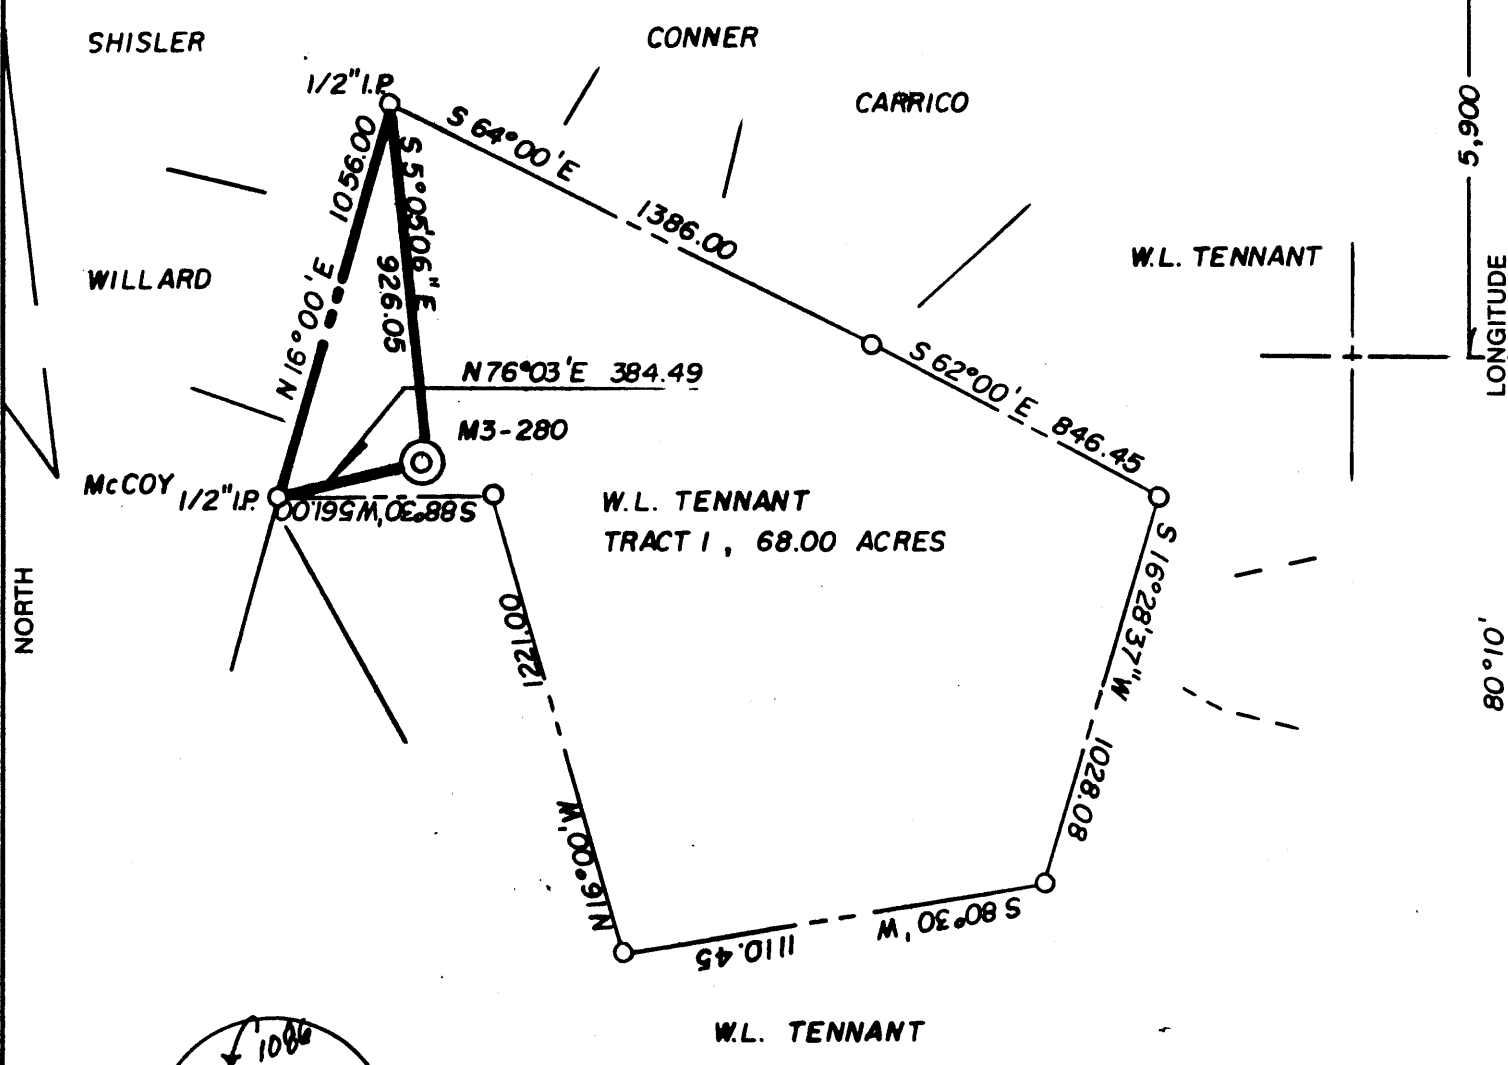

*6950*

(+) DENOTES LOCATION OF WELL ON UNITED STATES TOPOGRAPHIC MAPS

FILE NO. \_\_\_\_\_  
 DRAWING NO. \_\_\_\_\_  
 SCALE 1" = 500'  
 MINIMUM DEGREE OF ACCURACY 1/5000  
 PROVEN SOURCE OF ELEVATION COMPANY SURVEY  
 TIED INTO U.S.G.S. NETWORK

I THE UNDERSIGNED, HEREBY CERTIFY THAT THIS PLAT IS CORRECT TO THE BEST OF MY KNOWLEDGE AND BELIEF AND SHOWS ALL THE INFORMATION REQUIRED BY LAW AND THE REGULATIONS ISSUED AND PRESCRIBED BY THE DEPARTMENT OF ENERGY.  
 (SIGNED) *Paul D. Harbert*  
 R.P.E. \_\_\_\_\_ L.L.S. 862

PLACE SEAL HERE

STATE OF WEST VIRGINIA  
 DEPARTMENT OF ENERGY  
 OIL AND GAS DIVISION



DATE 1-26, 1993  
 OPERATOR'S WELL NO. M3-280  
 API WELL NO. 47-061-011207  
 STATE COUNTY PERMIT

WELL TYPE: OIL \_\_\_ GAS \_\_\_ LIQUID INJECTION \_\_\_ WASTE DISPOSAL \_\_\_  
 (IF "GAS,") PRODUCTION \_\_\_ STORAGE \_\_\_ DEEP \_\_\_ SHALLOW X

LOCATION: ELEVATION 1306.39 WATERSHED DAYS RUN  
 DISTRICT CLAY COUNTY MONONGALIA  
 QUADRANGLE BLACKSVILLE WV, PA

SURFACE OWNER W.L. TENNANT ACREAGE 68.00  
 OIL & GAS ROYALTY OWNER \_\_\_\_\_ LEASE ACREAGE \_\_\_\_\_

LEASE NO. \_\_\_\_\_  
 PROPOSED WORK: DRILL \_\_\_ CONVERT \_\_\_ DRILL DEEPER \_\_\_ REDRILL \_\_\_ FRACTURE OR STIMULATE \_\_\_ PLUG OFF OLD FORMATION \_\_\_ PERFORATE NEW FORMATION \_\_\_ OTHER PHYSICAL CHANGE IN WELL (SPECIFY) \_\_\_\_\_

PLUG AND ABANDON \_\_\_ CLEAN OUT AND REPLUG X  
 TARGET FORMATION NONE ESTIMATED DEPTH \_\_\_\_\_  
 WELL OPERATOR CONSOLIDATION COAL CO. DESIGNATED AGENT ROGER E. DUCKWORTH  
 ADDRESS P.O. BOX 1314 MORGANTOWN WV 26505 ADDRESS P.O. BOX 1314 MORGANTOWN WV 26505

SEP 3 1993

FORM WW-6 HALLS INC. 068065

COUNTY NAME PERMIT

JAN 18 1996

Permitting Office of Oil & Gas

AFFIDAVIT OF PLUGGING AND FILLING WELL

AFFIDAVIT SHOULD BE MADE IN TRIPPLICATE, one copy mailed to the Division, one copy to be retained by the Well Operator and the third copy (and extra copies if required) should be mailed to each coal operator at their respective addresses.

Consolidation Coal Co.  
Coal Operator or Owner  
P.O. Box 1314 Morgantown, W. Va. 26507  
Address  
Consolidation Coal Co.  
Coal Operator or Owner  
P.O. Box 1314 Morgantown, W. Va. 26507  
Address  
J.B. Eddy  
Lease or Property Owner  
Daysrun Road  
Address

Consolidation Coal Co.  
Name of Well Operator  
P.O. Box 1314 Morgantown, W. Va. 26507  
Complete Address  
January 2 1994  
WELL AND LOCATION  
Clay District  
Monongalia County  
WELL NO. M3-280

STATE INSPECTOR SUPERVISING PLUGGING Kenneth Mick (Signature) Farm  
AFFIDAVIT

STATE OF WEST VIRGINIA,  
County of Monongalia ss:

Larry L. Yost and Dennis L. Yost  
being first duly sworn according to law depose and say that they are experienced in the work of plugging and filling oil and gas wells and were employed by Consolidation Coal Co., well operator, and participated in the work of plugging and filling the above well, that said work was commenced on the 9th day of November, 1993, and that the well was plugged and filled in the following manner:

Sand or Zone Record Formation	Filling Material	Plugs Used Size & Kind	Casing	
			CSG PULLED	CSG LEFT IN
	Cleaned wellbore to 1280 ft. Ran coal protection string as follows: 1029 ft. of 4 1/2" casing; 188 ft. of 2 3/8" tubing; Latch down plug at 1009 ft.; Float valve at 1029 ft.; Swedge at 1030'. Circulated cement to surface as follows; 670 sacks of Poz Mix; 265 sacks of expanding type cement; 1,000 gal. of mud flush. Let set, bailed dry, set monument.			
Coal Seams		Description of Monument		
(Name) Pittsburgh - 890' - 897'		6 ft. of 4 1/2" casing with plaque stating Consol M3-280.		
(Name)		47-061-1120-P		

and that the work of plugging and filling said well was completed on the 30th day of December, 1993.

And further deponents saith not.

Sworn to and subscribed before me this 2nd day of January, 1994

My commission expires: March 12, 2002

OFFICIAL SEAL  
Notary Public, State of West Virginia  
CHERAL A. SKINNER  
RT. 2, BOX 184  
FAIRVIEW, WV 25970  
Commission Expires March 12, 2002

Notary Public Cheral A. Skinner  
Permit No. 47-061-1120-