

39° 42' 30"

Latitude ✓

80° 20' 00"

Longitude

Topo Location

7.5' Loc.	<u>1.125</u>	15' Loc.	<u>4.005</u>
	<u>1.09W</u>	(calc.)	<u>1.09W</u>

Company A.V. Company, Inc #2505

Farm E Haines

15' Quad Tharlington (NC)
(sec.)

7.5' Quad Wadestown

District Pattell

WELL LOCATION PLAT

County 061 Permit 1145N

39° 42' 30"

INSTRUCTIONS

1) Attach a photo copy of the location of the well on a 7.5 minute Quadrangle with the corresponding Longitude and Latitude.
 2) Designate the location of the well with the symbol (+).

Lat. 39 deg, 40 min
 Long. 80 deg, 21 min

80° 20' 00"

SEP 30 93

WV Division of Environmental Protection

18037

+ 7.5 Topo Tick

I, the undersigned, hereby certify that this plat is correct to the best of my knowledge and belief.

A V Company, Inc.

SIGNED Albert B. Yost

TITLE President

DATE September 7, 19 93

OPERATORS WELL NO. 2505

API WELL NO. 061-1145-1

STATE OF WEST VIRGINIA
 DEPARTMENT OF ENERGY
 OIL AND GAS DIVISION

WELL TYPE: OIL GAS LIQUID INJECTION WASTE DISPOSAL
 (IE "GAS" PRODUCTION STORAGE DEEP SHALLOW

LOCATION: ELEVATION 1275 WATER SHED Browns Run
 DISTRICT Battelle COUNTY Monongalia
 QUADRANGLE Wadestown 452

SURFACE OWNER _____ ACREAGE _____

OIL & GAS ROYALTY OWNER See Attached LEASE ACREAGE 70
 LEASE NO. 6337 E. Haines


PRODUCING FORMATION Fifth Sand TOTAL DEPTH 3471

WELL OPERATOR A V Company, Inc. DESIGNATED AGENT Albert B. Yost

ADDRESS Box 27, Burton ADDRESS Box 27, Burton

West Virginia 26575 West Virginia, 26575

WADESTOWN QUADRANGLE
WEST VIRGINIA-PENNSYLVANIA
7.5 MINUTE SERIES (TOPOGRAPHIC)
NE/4 MANNINGTON 15' QUADRANGLE

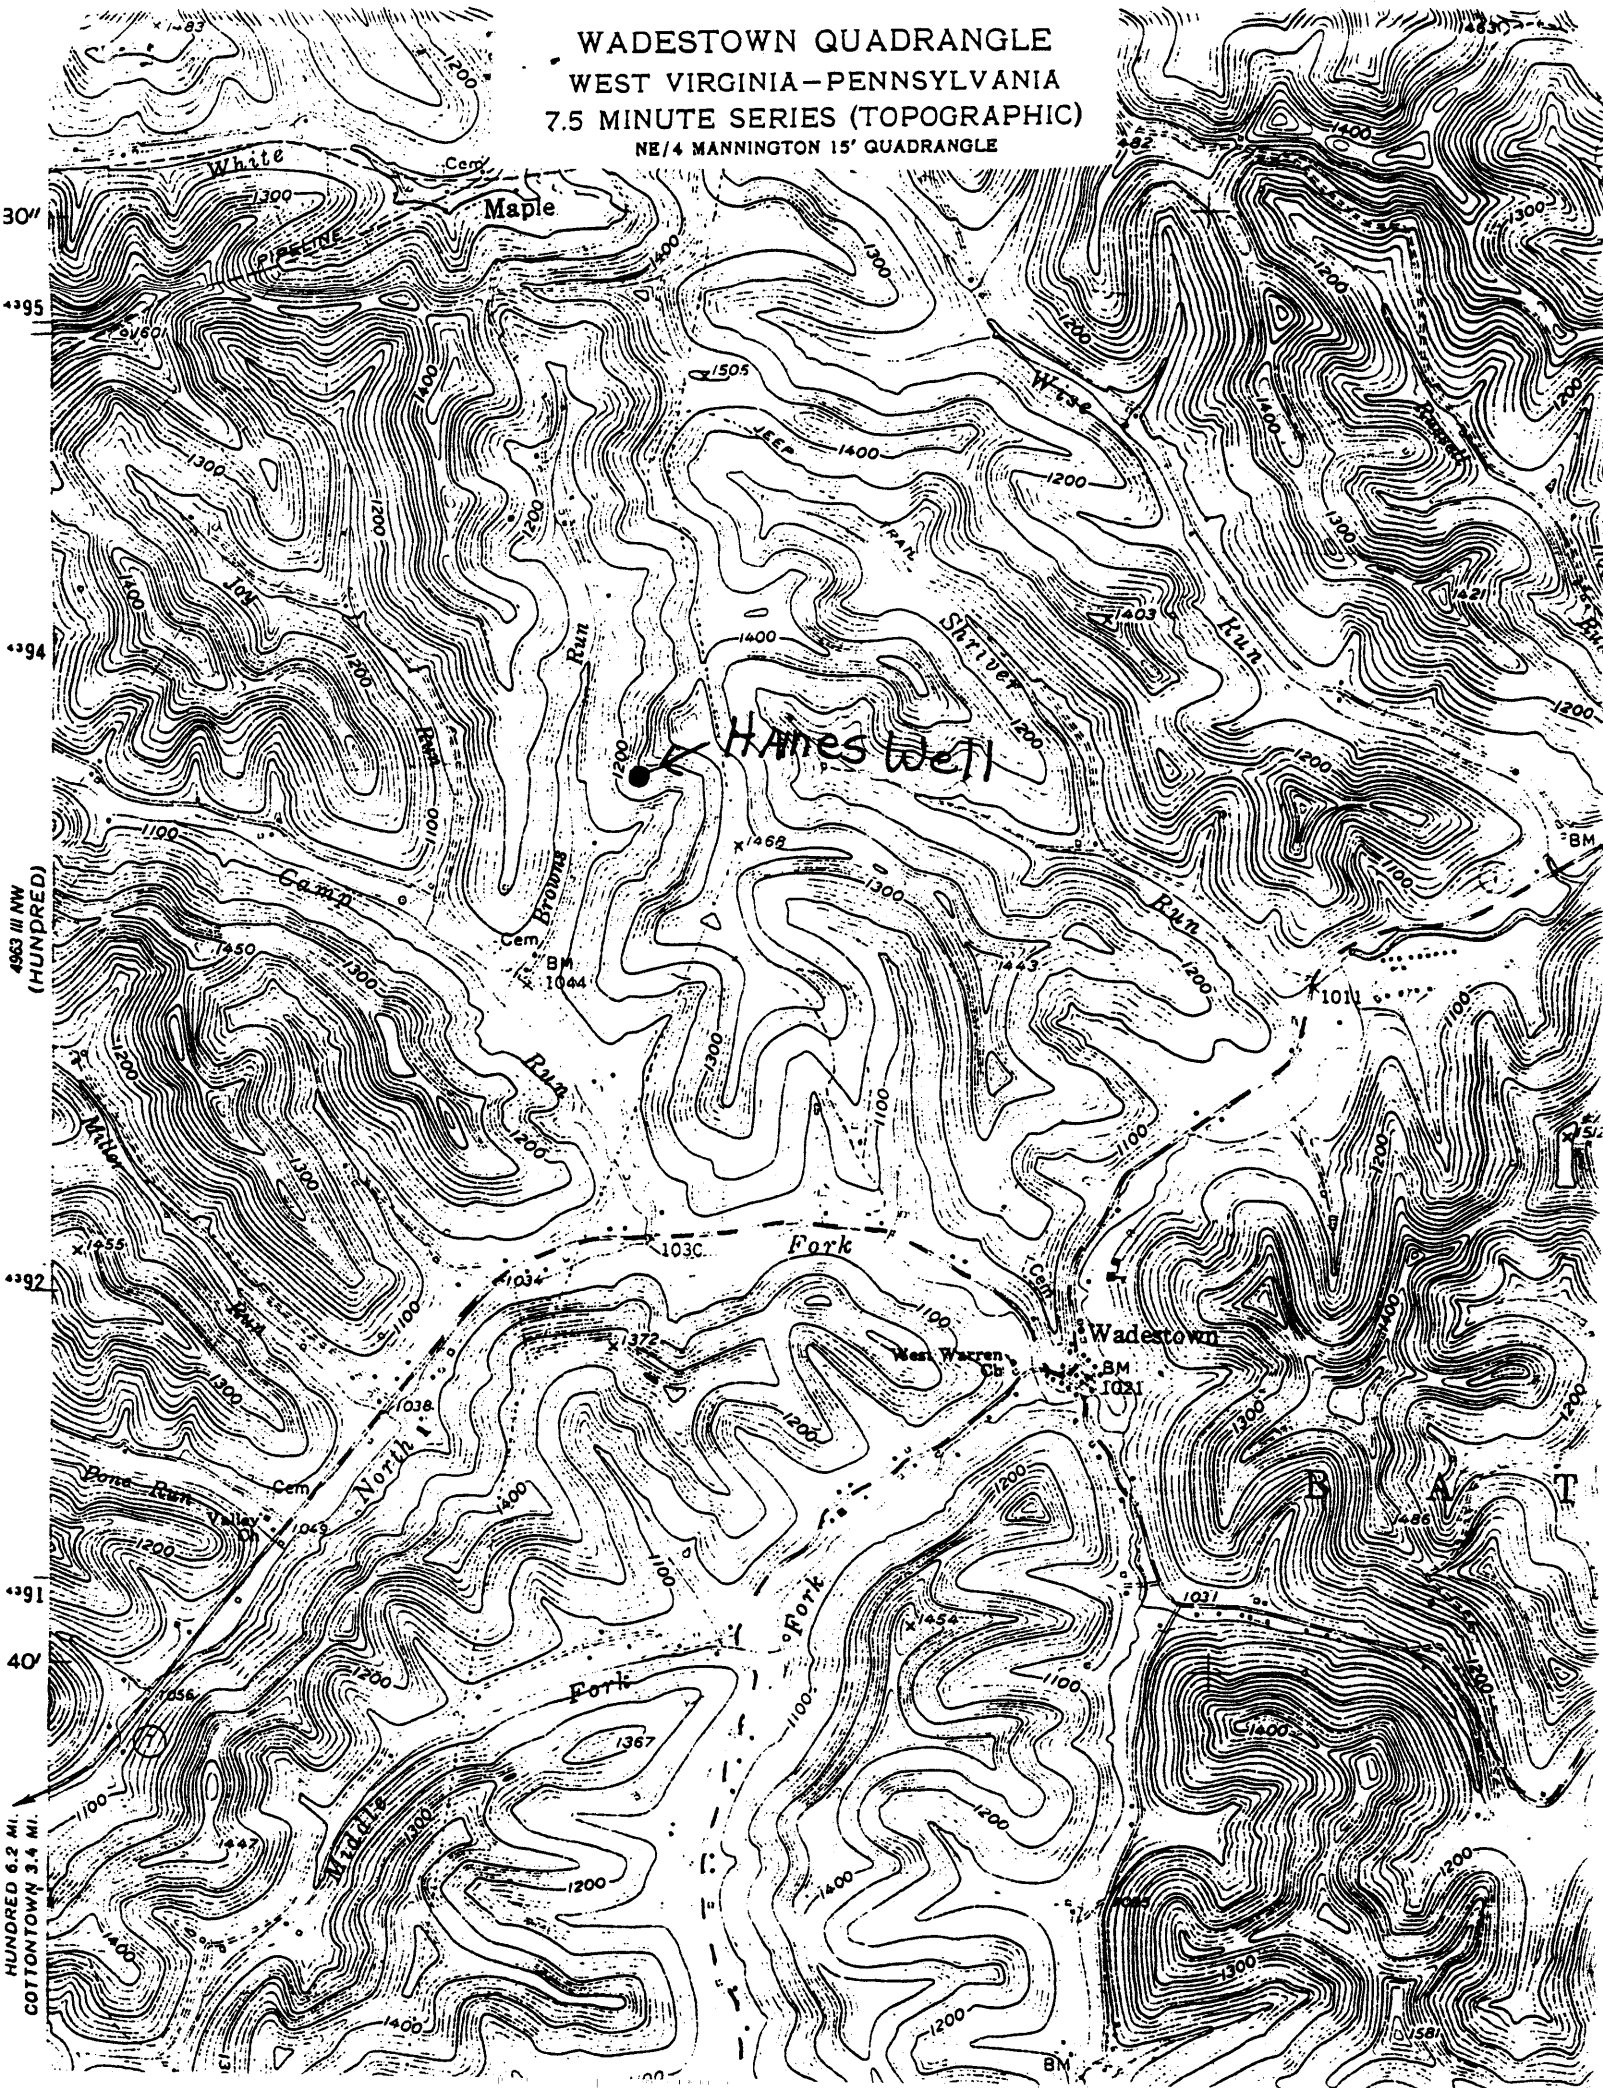

STATE OF WEST VIRGINIA
DIVISION OF ENVIRONMENTAL PROTECTION
SECTION OF OIL AND GAS

WELL REGISTER ASSIGNMENT

This API Number 47- 61-01145, issued to A. V. COMPANY is evidence of permission to operate the well that is referenced at the location described on the attached plat, subject to the provisions of Chapters 22 and 22B of the West Virginia Code of 1931, as amended, and all rules and regulations promulgated thereunder. The name and telephone number of the Oil and Gas Inspector for this well is RANDAL MICK -
304-986-3324.

Spills or emergency discharges must be reported to 1-800-654-3312.

Failure to abide by all statutory and regulatory provisions governing all duties and operations hereunder may result in suspension or revocation of your permits and in addition may result in civil and/or criminal penalties.

The enclosed WR-35 must be completed by you and returned to this office. In addition annual production reports must be submitted on this well and failure to do so may require you to plug the well.

Theodore M. Streit
Chief

By: 

Title: _____

Operator's Well No: 2505

Farm Name: HAINES, E.

API Well Number : 47- 61-01145 N

Date Issued : 03/10/94