

39° 40' 00"

Latitude



80° 17' 30"

Longitude

70226

Topo Location

7.5' Loc.	<u>1.945</u>	15' Loc.	<u>1.945</u>
	<u>0.38W</u>	(calc.)	<u>2.60W</u>

Company A.V. Company, Inc. # 2686

Farm A. & L. J. Pyles

15' Quad Mannington (EC)
(sec.)

7.5' Quad Wadestown

District Battelle

WELL LOCATION PLAT

County 061 Permit 1146 N

39° 40' 00"

INSTRUCTIONS

- 1) Attach a photo copy of the location of the well on a 7.5 minute Quadrangle with the corresponding Longitude and Latitude.
- 2) Designate the location of the well with the symbol (+).

Lat. 39 deg, 38 min 2100'
 Long. 80 deg, 18 min

10300'
 80° 17' 30"

RECEIVED
 OFFICE
 SEP 30 1993
 WV Division of
 Environmental Protection

18038

7.5' Tick
 ↓

I, the undersigned, hereby certify that this plat is correct to the best of my knowledge and belief.

A V Company, Inc.

SIGNED Albert B. Yost
 TITLE President

DATE September 7, 19 93

OPERATORS WELL NO. 2686

API WELL NO. 061-1146-N

STATE OF WEST VIRGINIA
 DEPARTMENT OF ENERGY
 OIL AND GAS DIVISION

WELL TYPE: OIL GAS X LIQUID INJECTION WASTE DISPOSAL
 (i.e. "GAS" PRODUCTION STORAGE DEEP SHALLOW X)

LOCATION: ELEVATION WATER SHED Right Branch Miracle Run
 DISTRICT Battelle COUNTY Monongalia
 QUADRANGLE Wadestown

SURFACE OWNER ACREAGE

OIL & GAS ROYALTY OWNER See Attached LEASE ACREAGE 35
 LEASE NO. 5265 A & I J. Pyles


PRODUCING FORMATION Fourth Sand TOTAL DEPTH 3336

WELL OPERATOR A V Company, Inc. DESIGNATED AGENT Albert B. Yost

ADDRESS Box 27, Burton ADDRESS Box 27, Burton

West Virginia 26575 West Virginia 26575

WEST VIRGINIA - PENNSYLVANIA
7.5 MINUTE SERIES (TOPOGRAPHIC)
NE/4 MANNINGTON 15' QUADRANGLE

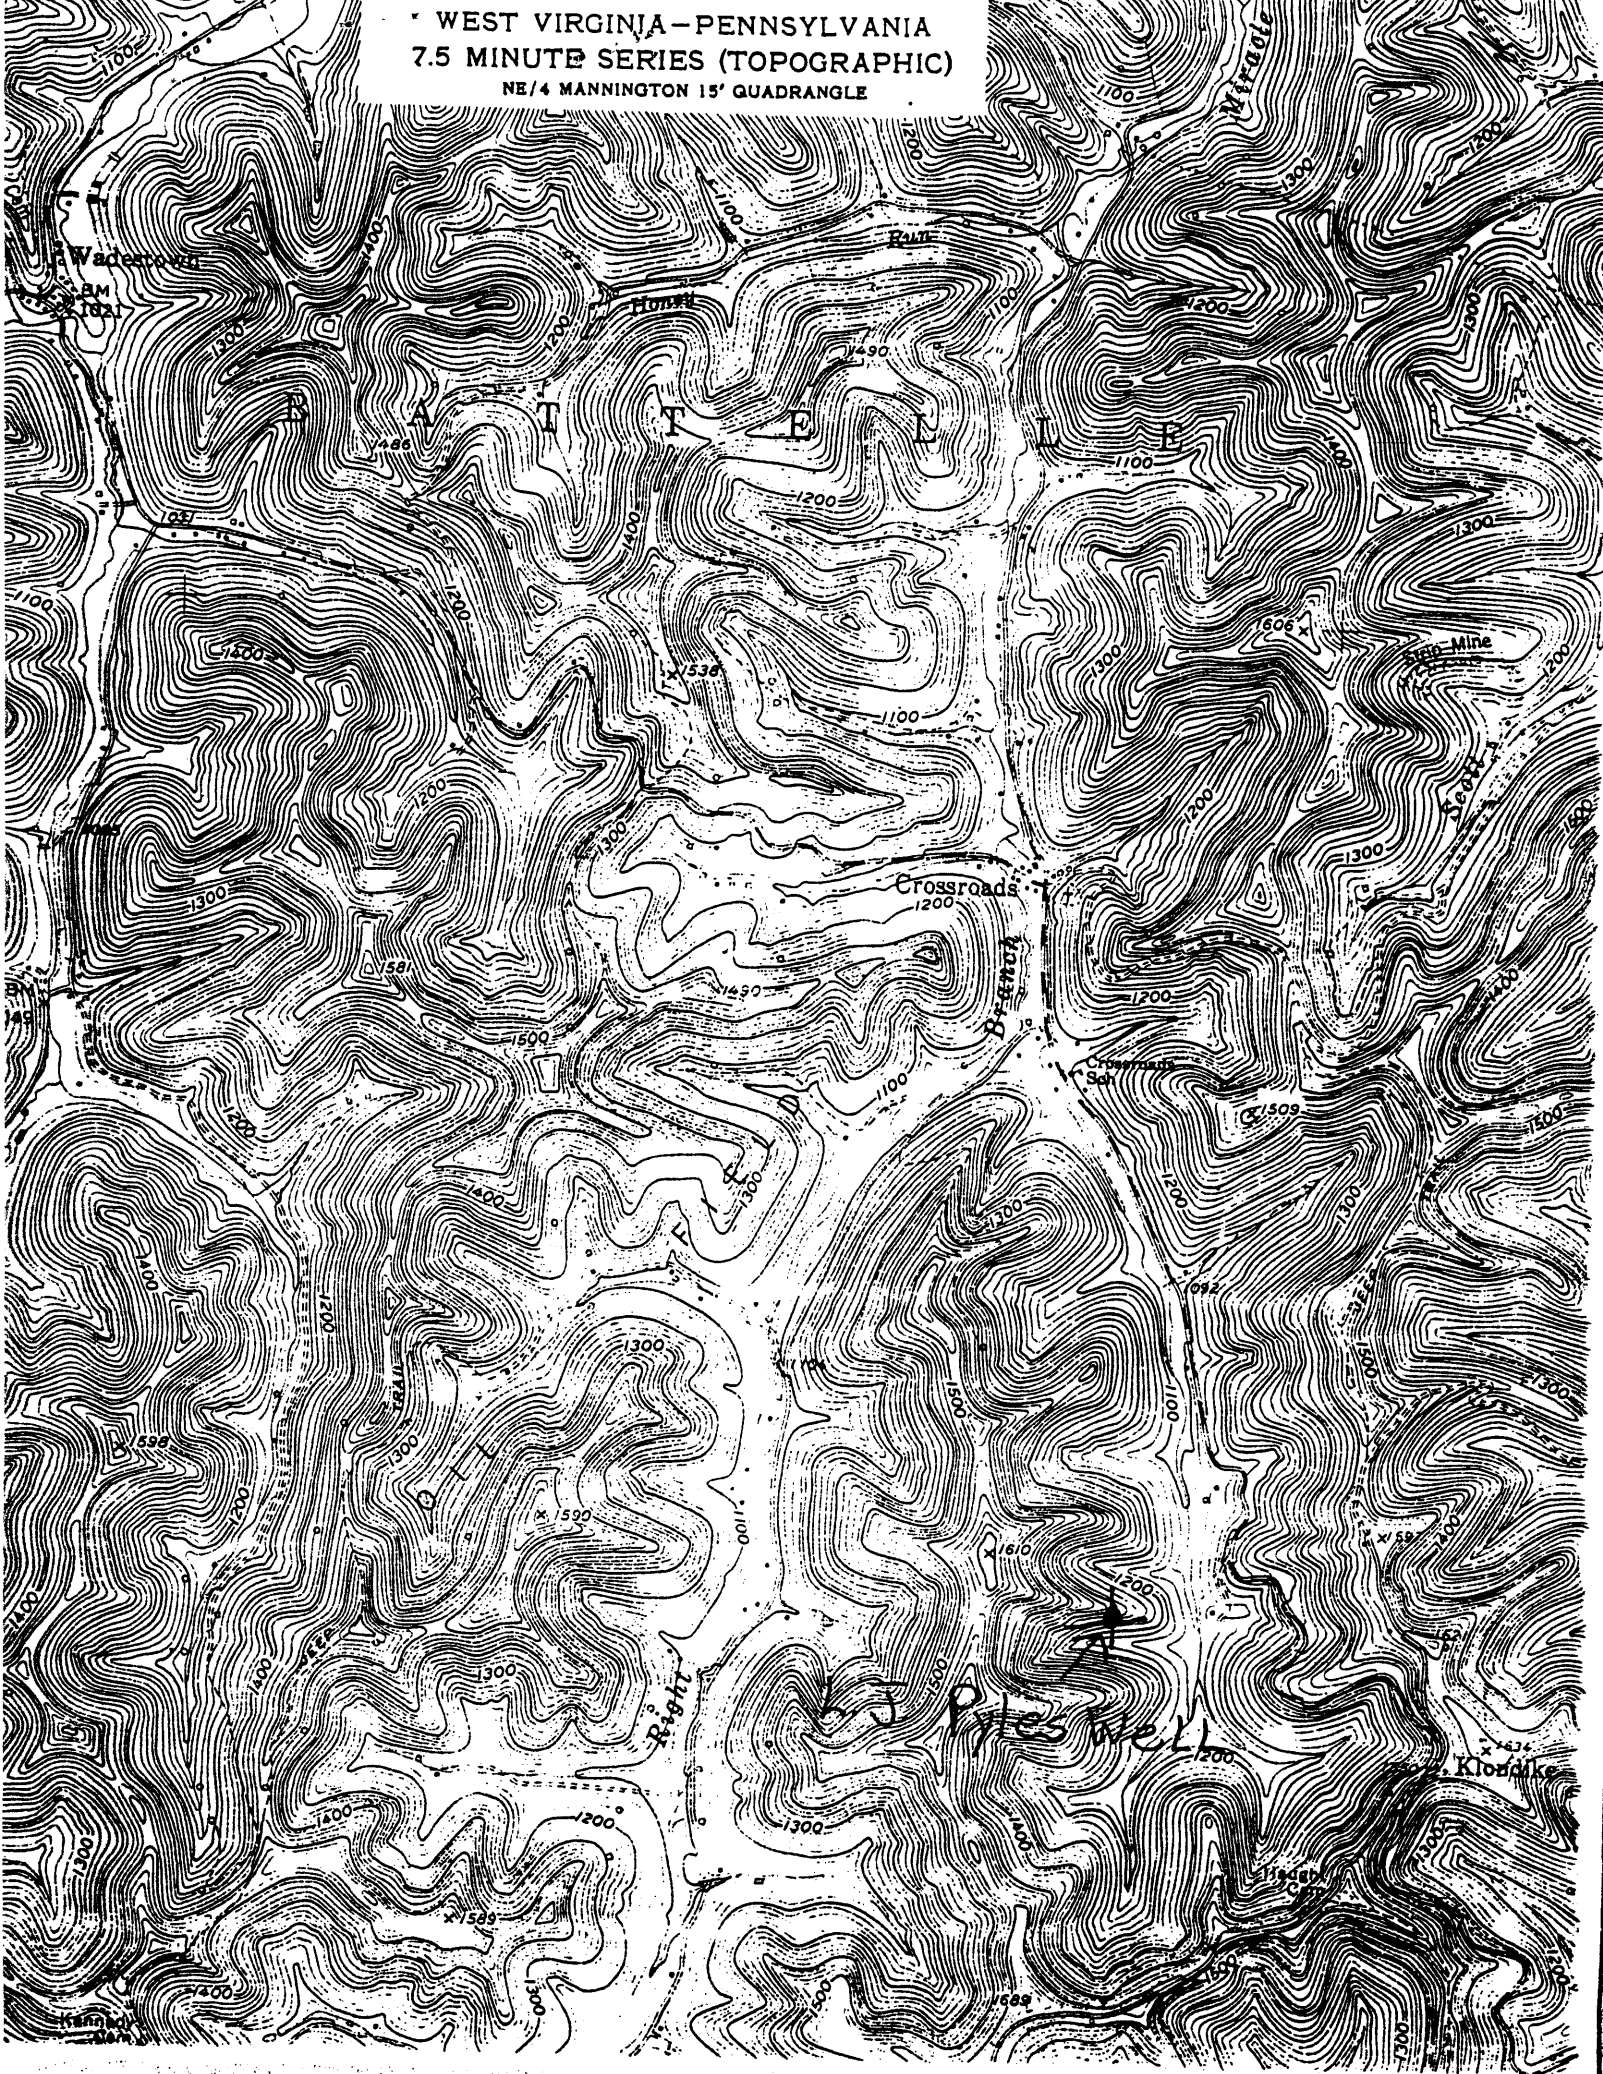

STATE OF WEST VIRGINIA
DIVISION OF ENVIRONMENTAL PROTECTION
SECTION OF OIL AND GAS

WELL REGISTER ASSIGNMENT

This API Number 47- 61-01146, issued to A. V. COMPANY is evidence of permission to operate the well that is referenced at the location described on the attached plat, subject to the provisions of Chapters 22 and 22B of the West Virginia Code of 1931, as amended, and all rules and regulations promulgated thereunder. The name and telephone number of the Oil and Gas Inspector for this well is RANDAL MICK -
304-986-3324.

Spills or emergency discharges must be reported to 1-800-654-3312.

Failure to abide by all statutory and regulatory provisions governing all duties and operations hereunder may result in suspension or revocation of your permits and in addition may result in civil and/or criminal penalties.

The enclosed WR-35 must be completed by you and returned to this office. In addition annual production reports must be submitted on this well and failure to do so may require you to plug the well.

Theodore M. Streit
Chief

By: 

Title: _____

Operator's Well No: 2686

Farm Name: PYLES, A. & L. J.

API Well Number : 47- 61-01146 N

Date Issued : 03/10/94