

39° 40' 00"

Latitude ✓

well spot

80° 17' 30"

Longitude

70042, 70194,
70205, 70206

Topo Location

7.5' Loc. 0.00s 15' Loc. 0.00s
2.03 (calc.) 4.25W

Company A.V. Company, Inc.
Farm Garrison Heirs #2797
15' Quad Mannington (EC)
(sec.)
7.5' Quad Wadeston
District Battelle

WELL LOCATION PLAT

County 061 Permit 1147N

INSTRUCTIONS

1) Attach a photo copy of the location of the well on a 7.5 minute Quadrangle with the corresponding Longitude and Latitude.

2) Designate the location of the well with the symbol(+).

10800'

Lat. 39 deg, 40 min
Long. 80 deg, 20 min

SEP 30 83

WV Division of
Environmental Protection

18039

80° 17' 30"

I, the undersigned, hereby certify that this plat is correct to the best of my knowledge and belief.

A V Company, Inc.

SIGNED Albert B. Yost

TITLE President

DATE September 7, 19 93

OPERATORS WELL NO. 2797

API WELL NO. 041-1147-N

STATE OF WEST VIRGINIA
DEPARTMENT OF ENERGY
OIL AND GAS DIVISION

WELL TYPE: OIL GAS X LIQUID INJECTION WASTE DISPOSAL
(If "GAS" PRODUCTION STORAGE DEEP SHALLOW X)

LOCATION: ELEVATION 1200 WATER SHED
DISTRICT Barrelle COUNTY Monongalia
QUADRANGLE Wadestown

SURFACE OWNER ACREAGE

OIL & GAS ROYALTY OWNER See Attached LEASE ACREAGE 300
LEASE NO. 8702 Garrison Heirs


PRODUCING FORMATION Fourth Sand TOTAL DEPTH 3439

WELL OPERATOR A V Company, Inc. DESIGNATED AGENT Albert B. Yost

ADDRESS Box 27, Burton ADDRESS Box 27, Burton

West Virginia 26575 West Virginia 26575

WEST VIRGINIA-PENNSYLVANIA
7.5 MINUTE SERIES (TOPOGRAPHIC)
NE/4 MANNINGTON 15' QUADRANGLE

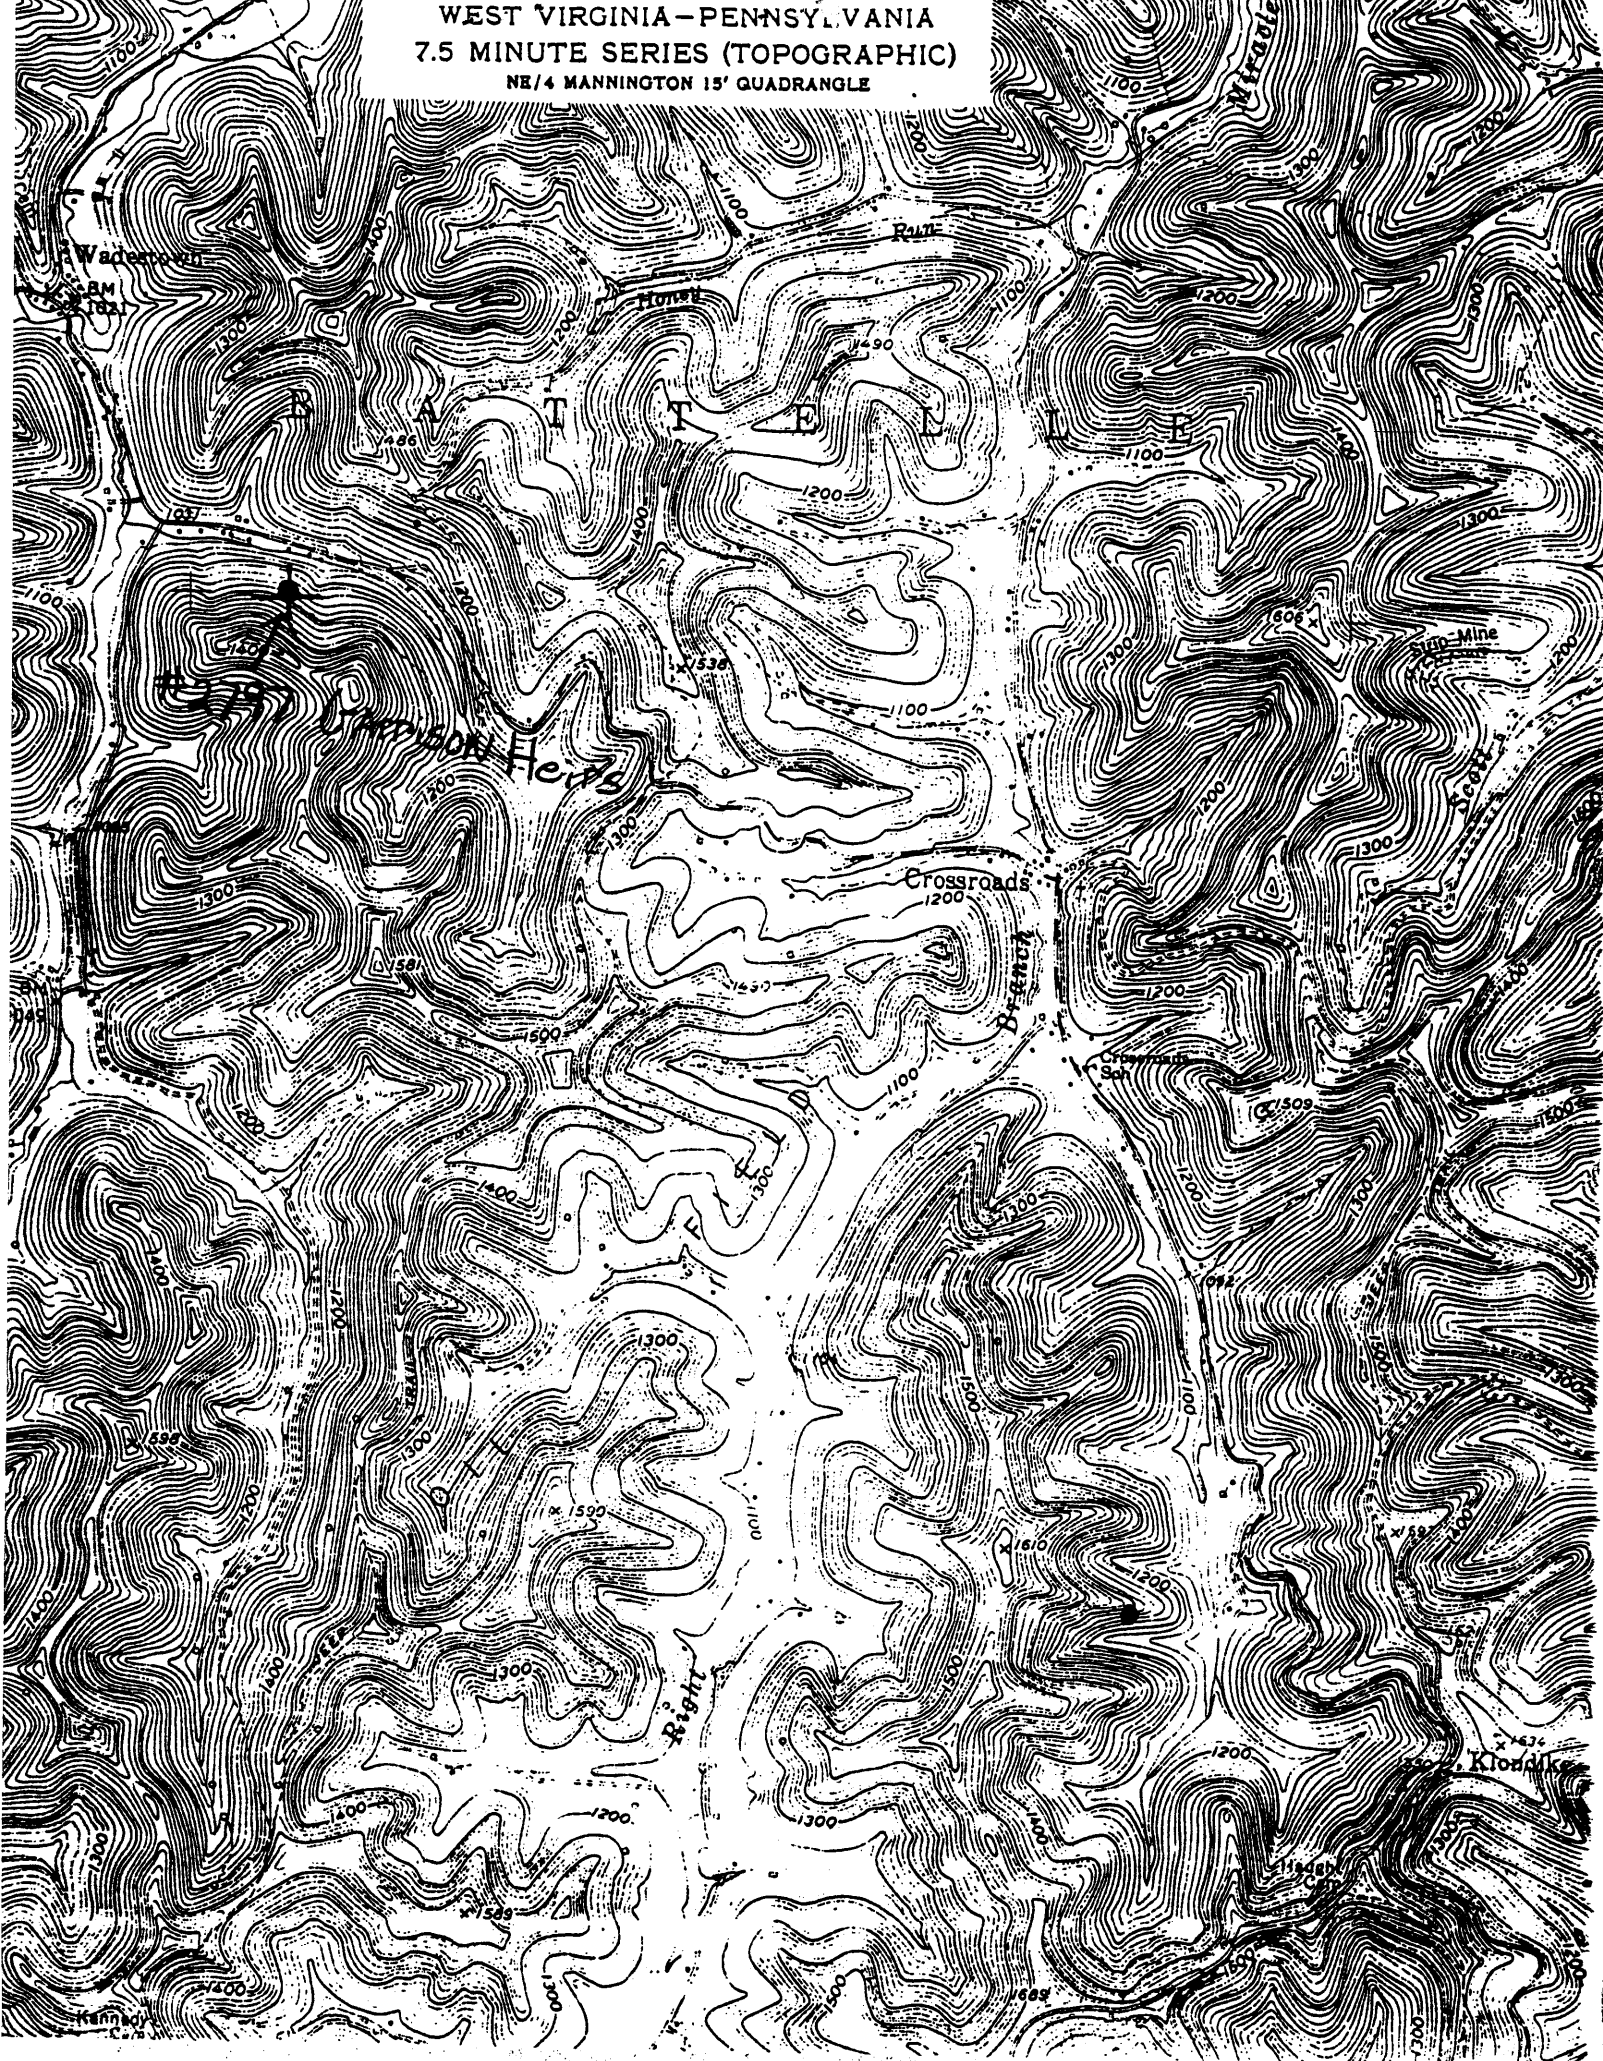

STATE OF WEST VIRGINIA
DIVISION OF ENVIRONMENTAL PROTECTION
SECTION OF OIL AND GAS

WELL REGISTER ASSIGNMENT

This API Number 47- 61-01147, issued to A. V. COMPANY is evidence of permission to operate the well that is referenced at the location described on the attached plat, subject to the provisions of Chapters 22 and 22B of the West Virginia Code of 1931, as amended, and all rules and regulations promulgated thereunder. The name and telephone number of the Oil and Gas Inspector for this well is RANDAL MICK -
304-986-3324.

Spills or emergency discharges must be reported to 1-800-654-3312.

Failure to abide by all statutory and regulatory provisions governing all duties and operations hereunder may result in suspension or revocation of your permits and in addition may result in civil and/or criminal penalties.

The enclosed WR-35 must be completed by you and returned to this office. In addition annual production reports must be submitted on this well and failure to do so may require you to plug the well.

Theodore M. Streit
Chief

By: 

Title: _____

Operator's Well No: 2797

Farm Name: GARRISON HEIRS

API Well Number : 47- 61-01147 N

Date Issued : 03/10/94