

39° 42' 30"

Latitude ✓

79° 57' 30"

Longitude

Topo Location

7.5' Loc. 0.035 15' Loc. 2.915
1.56W (calc.) 3.78W

Company Norman Corp.
Farm P. S. Lazzelle / Wm. Fennel #12
15' Quad Morgantown (NW)
(sec.)
7.5' Quad Morgantown North
District Cass

WELL LOCATION PLAT

County Del Permit 1148N


INSTRUCTIONS

39° 42' 30"

8300'


- 1) Attach a photo copy of the location of the well on a 7.5 minute Quadrangle with the corresponding longitude and latitude.
- 2) Designate the location of the well with the symbol (1).

7.5' Tick

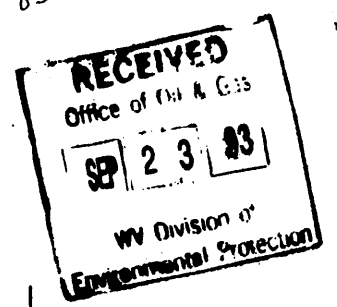

79° 57' 30"

18013

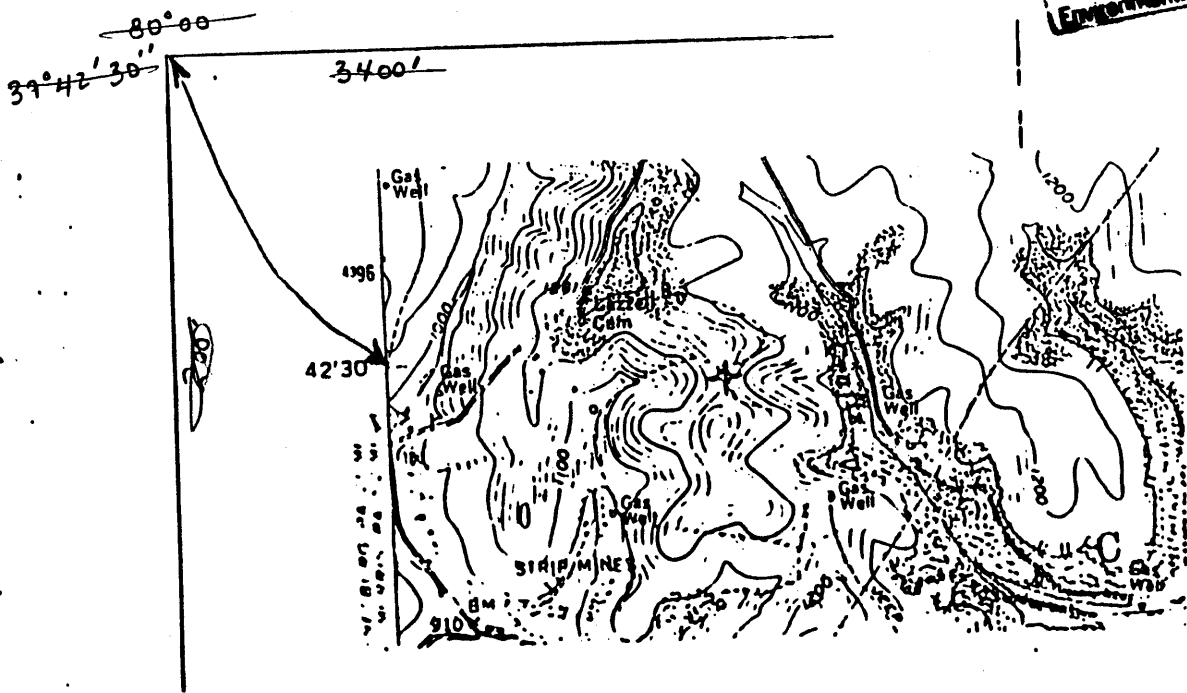

I, the undersigned, hereby certify that this plat is correct to the best of my knowledge and belief.

SIGNED _____

DATE March 2, 1993

OPERATORS WELL NO. 12

API WELL NO. 47-061-1148-N

STATE OF WEST VIRGINIA
DEPARTMENT OF ENERGY
OIL AND GAS DIVISION

WELL TYPE: OIL _____ GAS X LIQUID INJECTION _____ WASTE DISPOSAL _____
(IE "GAS" PRODUCTION) _____ STORAGE _____ DEEP _____ SHALLOW X

LOCATION: ELEVATION 1271 WATER SHED Craft Run
DISTRICT Cass COUNTY Monongalia
QUADRANGLE Morgantown North

SURFACE OWNER P.S. Lazzelle ACREAGE 108

OIL & GAS ROYALTY OWNER William P. Fennell LEASE ACREAGE 108
LEASE NO. 190-J

PRODUCING FORMATION INJUN TOTAL DEPTH 1759

WELL OPERATOR Noumenon Corporation DESIGNATED AGENT Stephen K. Shuman

ADDRESS P.O. Box 116 ADDRESS P.O. Box 116
Core, WV 26529 Core, WV 26529

Morgantown 4

STATE OF WEST VIRGINIA
DIVISION OF ENVIRONMENTAL PROTECTION
SECTION OF OIL AND GAS

WELL REGISTER ASSIGNMENT

This API Number 47- 61-01148, issued to NOUMENON CORPORATION, a W.VA. is evidence of permission to operate the well that is referenced at the location described on the attached plat, subject to the provisions of Chapters 22 and 22B of the West Virginia Code of 1931, as amended, and all rules and regulations promulgated thereunder. The name and telephone number of the Oil and Gas Inspector for this well is RANDAL MICK -
304-986-3324.

Spills or emergency discharges must be reported to 1-800-654-3312.

Failure to abide by all statutory and regulatory provisions governing all duties and operations hereunder may result in suspension or revocation of your permits and in addition may result in civil and/or criminal penalties.

The enclosed WR-35 must be completed by you and returned to this office. In addition annual production reports must be submitted on this well and failure to do so may require you to plug the well.

Theodore M. Streit
Chief

By: 

Title: _____

Operator's Well No: 12

Farm Name: LAZZELLE, P.S./WM. FENNEL

API Well Number : 47- 61-01148 N

Date Issued : 03/10/94