

LOT 3
ALBERT EDDY

LOT 1
ALBERT EDDY

LOT 2
ALBERT K. & MERLE J EDDY
TRACT 3 23.18 ACRES

JAMES THOMAS

DAVID BRACKEN

ALBERT EDDY

EQUIGNOT

0596

0108

1.845
015 W

NORTH

N 40° 30' E
1079.10

N 30° 30' E
165.00

S 66° 45' E
293.70

686.40

MI-469

285.82

N 23° 32' E
645.82

N 64° 30' W

POST

POST

MI-469

MI-469


MI-469

MI-469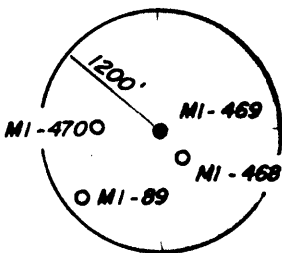

(+) DENOTES LOCATION OF WELL ON UNITED STATES TOPOGRAPHIC MAPS

FILE NO. _____
DRAWING NO. _____
SCALE 1" = 300'
MINIMUM DEGREE OF ACCURACY 1 IN 5000
PROVEN SOURCE OF ELEVATION COMPANY SURVEY TIED INTO U.S.G.S. NETWORK

I THE UNDERSIGNED, HEREBY CERTIFY THAT THIS PLAT IS CORRECT TO THE BEST OF MY KNOWLEDGE AND BELIEF AND SHOWS ALL THE INFORMATION REQUIRED BY LAW AND THE REGULATIONS ISSUED AND PRESCRIBED BY THE DEPARTMENT OF ENERGY.

(SIGNED) Paul D. Harbert
R.P.E. _____ L.L.S. 862

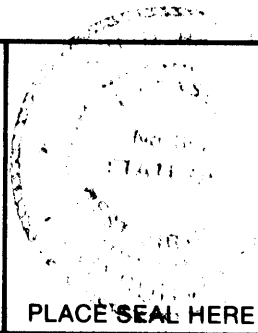

PLACE SEAL HERE

STATE OF WEST VIRGINIA
DEPARTMENT OF ENERGY
OIL AND GAS DIVISION



DATE 2-22, 19 94
OPERATOR'S WELL NO. MI-469
API WELL NO. _____

WELL TYPE: OIL ___ GAS ___ LIQUID INJECTION ___ WASTE DISPOSAL ___
(IF "GAS,") PRODUCTION ___ STORAGE ___ DEEP ___ SHALLOW X ABANDONED X

LOCATION: ELEVATION 1256.47 WATER SHED JAKES RUN

DISTRICT CLAY COUNTY MONONGALIA

QUADRANGLE BLACKSVILLE WV, PA. + 15' WC

SURFACE OWNER ALBERT K. & MERLE J. EDDY ACREAGE 23.18

OIL & GAS ROYALTY OWNER _____ LEASE ACREAGE _____

LEASE NO. _____

PROPOSED WORK: DRILL ___ CONVERT ___ DRILL DEEPER ___ REDRILL ___ FRACTURE OR STIMULATE ___ PLUG OFF OLD FORMATION ___ PERFORATE NEW FORMATION ___ OTHER PHYSICAL CHANGE IN WELL (SPECIFY) _____

PLUG AND ABANDON X CLEAN OUT AND REPLUG _____

TARGET FORMATION NONE ESTIMATED DEPTH _____

WELL OPERATOR CONSOLIDATION COAL COMPANY DESIGNATED AGENT ROGER E. DUCKWORTH

ADDRESS P.O. BOX 1314 MORGANTOWN WV. 26505 ADDRESS P.O. BOX 1314 MORGANTOWN WV 26505

COUNTY NAME
PERMIT

FORM WM-6
088055
HALLS, INC.

OFFICE OF
DEC 02 1994
WV Division of
Environmental Protection

AFFIDAVIT OF PLUGGING AND FILLING WELL

AFFIDAVIT SHOULD BE MADE IN TRIPLICATE, one copy mailed to the Division, one copy should be retained by the Well Operator and the third copy (and extra copies if required) should be mailed to each coal operator at their respective addresses.

Consolidation Coal Company
Coal Operator or Owner
P.O. Box 1314 Morgantown, WV 26507
Address
Consolidation Coal Company
Coal Operator or Owner
P.O. Box 1314 Morgantown, WV 26507
Address
Albert K & Merle J. Eddy
Lease or Property Owner
Rt. 2 Box 109 Fairview, WV 26570
Address

Consolidation Coal Company
Name of Well Operator
P.O. Box 1314 Morgantown, WV 26507
Complete Address
Sept. 2, 19 94
WELL AND LOCATION
Clay District
Monongalia County
WELL NO. M1-469

STATE INSPECTOR SUPERVISING PLUGGING Cheral Mick (Inspector)
AFFIDAVIT

STATE OF WEST VIRGINIA,
County of Monongalia
Larry L. Yost and David D. Yost

ss:

being first duly sworn according to law depose and say that they are experienced in the work of plugging and filling oil and gas wells and were employed by Consolidation Coal Co., well operator, and participated in the work of plugging and filling the above well, that said work was commenced on the 18th day of July, 19 94, and that the well was plugged and filled in the following manner:

| Sand or Zone Record Formation | Filling Material | Plugs Used Size & Kind | Casing | |
|----------------------------------|---|---------------------------|---------------|----------------|
| | | | CSG PULLED | CSG LEFT IN |
| | Pulled 2062' of 2 3/8" tubing. | 2 3/8" | 2062' | |
| | Pulled 2030 ft. of 5 1/2" casing. | 5 1/2" | 2030' | |
| | Pulled 1400 ft. of 7" casing. | 7" | 1400' | |
| | Cleaned wellbore to 2030. | 7" | 1400' | |
| | Cemented bottom hole plug from 2030'-1440' with 185 sacks. Pulled 240 ft. of 8 1/4" casing. Ran coal protection strings as follows; | 8 1/4" | 240' | 664' |
| | 853 ft. of 4 1/2" casing, 519 ft. of 2 3/8" tubing. Latchdown at 826' | | | |
| | Float valve at 853' Swedge at 854ft. | | | |
| | Circulated cement to surface as follows 600 sacks of Poz mix, 365 sacks of expanding type cement 1000 gal. of mud flush. Let set. | | | |
| | Bailed dry. Set monument. | | | |
| Coal Seams | Description of Monument | | | |
| (Name) Pittsburgh 685' - 695' | 6ft. of 4 1/2" casing with plaque stating | | | |
| (Name) | Consol M1-469 | | | |
| (Name) | 47-61-1157-P | | | |
| (Name) | | | | |

and that the work of plugging and filling said well was completed on the 4th day of August, 19 94.

And further deponents saith not.

Sworn to and subscribed before me this 2nd day of September, 19 94.

Larry L. Yost
David D. Yost
Cheral Skinner
Notary Public

My commission expires:

March 12, 2002



OFFICIAL SEAL
Notary Public, State of West Virginia
CHERAL A. SKINNER
RT. 2, BOX 184
FAIRVIEW, WV 26570

Permit No. 47-61-1157-P