


(+) DENOTES LOCATION OF WELL ON UNITED STATES TOPOGRAPHIC MAPS

FILE NO. _____
 DRAWING NO. _____
 SCALE 1" = 500'
 MINIMUM DEGREE OF ACCURACY 1 IN 5000
 PROVEN SOURCE OF ELEVATION COMPANY SURVEY
TIED INTO U.S.G.S. NETWORK

I THE UNDERSIGNED, HEREBY CERTIFY THAT THIS PLAT IS CORRECT TO THE BEST OF MY KNOWLEDGE AND BELIEF AND SHOWS ALL THE INFORMATION REQUIRED BY LAW AND THE REGULATIONS ISSUED AND PRESCRIBED BY THE DEPARTMENT OF ENERGY.
 (SIGNED) Paul D. Harbert
 R.P.E. _____ L.L.S. 862

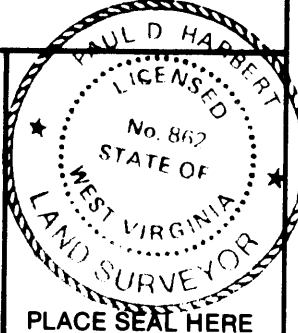

STATE OF WEST VIRGINIA
 DEPARTMENT OF ENERGY
 OIL AND GAS DIVISION

DATE 8-19, 1994
 OPERATOR'S WELL NO. 4152
 API WELL NO. 47-61-1175-P

WELL TYPE: OIL ___ GAS ___ LIQUID INJECTION ___ WASTE DISPOSAL ___
 (IF "GAS,") PRODUCTION ___ STORAGE ___ DEEP ___ SHALLOW X ABANDONED X
 LOCATION: ELEVATION 1237.73 WATERSHED RANGE RUN (was: 70945)
 DISTRICT BATTELLE COUNTY MONONGALIA
 QUADRANGLE WADESTOWN WV-PA Mannington EC

SURFACE OWNER RONNIE E. & JUDITH PRICE ACREAGE 41.67 CALC.
 OIL & GAS ROYALTY OWNER _____ LEASE ACREAGE _____
 LEASE NO. _____

PROPOSED WORK: DRILL ___ CONVERT ___ DRILL DEEPER ___ REDRILL ___ FRACTURE OR STIMULATE ___ PLUG OFF OLD FORMATION ___ PERFORATE NEW FORMATION ___ OTHER PHYSICAL CHANGE IN WELL (SPECIFY) Plugging of the 1929 well to mine through

PLUG AND ABANDON X CLEAN OUT AND REPLUG _____
 TARGET FORMATION NONE ESTIMATED DEPTH _____

WELL OPERATOR CONSOLIDATION COAL COMPANY DESIGNATED AGENT ROGER E. DUCKWORTH
 ADDRESS P.O. BOX 1314 MORGANTOWN, WV 26505 ADDRESS P.O. BOX 1314 MORGANTOWN, WV 26505

FORM WW-6
 HALLS INC. 088055

COUNTY NAME
 PERMIT

Environmental Protection
JAN 18 1996
Permitting
Office of Oil & Gas

AFFIDAVIT OF PLUGGING AND FILLING WELL

AFFIDAVIT SHOULD BE MADE IN TRIPLICATE, one copy mailed to the Division, one copy to be retained by the Well Operator and the third copy (and extra copies if required) should be mailed to each coal operator at their respective addresses.

Consolidation Coal Company
Coal Operator or Owner
P. O. Box 1314, Morgantown, WV 26507-1314
Address

Coal Operator or Owner
Address
Ronnie E. & Judith Price
Lease or Property Owner
Route 1, Box 81, Fairview, WV 26570
Address

Consolidation Coal Company
Name of Well Operator
P.O. Box 1314, Morgantown, WV 26507-1314
Complete Address
November 24, 19 94
WELL AND LOCATION
Battelle District
Monongalia County
WELL NO. 4152
Ronnie & Judith Price Farm

STATE INSPECTOR SUPERVISING PLUGGING

Randal Muck

AFFIDAVIT

STATE OF WEST VIRGINIA,

County of Harrison ss:
Glen Andrew Lang and Kevin Wright

being first duly sworn according to law depose and say that they are experienced in the work of plugging and filling oil and gas wells and were employed by Consolidation Coal Co., well operator, and participated in the work of plugging and filling the above well, that said work was commenced on the 3rd day of November, 19 94, and that the well was plugged and filled in the following manner:


Sand or Zone Record Formation	Filling Material	Plugs Used Size & Kind	Casing	
			CSG PULLED	CSG LEFT IN
Pulled 2,204' of 5½" casing. to 1600'. Pulled 1601.63' of 2204' to 2479'. 7" casing remaining in hole from 1601.63' to 2250'. Ran coal protection string as follows: 358.67' of 2 3/8" tubing followed by 1245.28' of 4½" casing. Cemented hole from 1600' back to surface using 1300 sacks of poz mix and 175 sacks of thixotropic cement. Latch down plug at 1223.22'. Float valve at 1245.28'. Swedge at 1246.28'. Sent cement plug from surface to 852' with poz mix. Sent cement plug from 852' to 1260' with thixotropic cement. Sent cement plug from 1260' to 1600' with poz mix. Cement did circulate. Used 1,000 gallons of mud flush. Displaced cement to 1223.22'-with water, let set and bailed dry.				
TOTAL DEPTH: 3,192.04 feet				
Coal Seams		Description of Monument		
(Name) Pittsburgh	1,052' to 1060'	5' of 4½" casing with plaque stating: Consolidation Coal Co. Well 4152 Permit 47-61-01175-P		

and that the work of plugging and filling said well was completed on the 18th day of November, 19 94.

And further deponents saith not.

Sworn to and subscribed before me this 24th day of November, 1994.

My commission expires June 29, 1999.

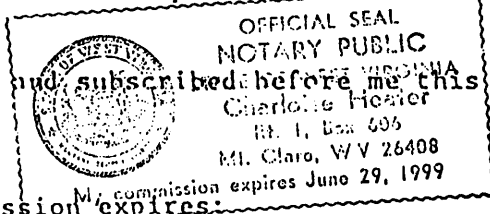

Glen Andrew Lang
Kevin J. Wright
Charlotte Heener
Notary Public