


GS 4/3/97

LATITUDE 39° 40' 00" 2,900'

LONGITUDE 80° 10' 00" 6,150'

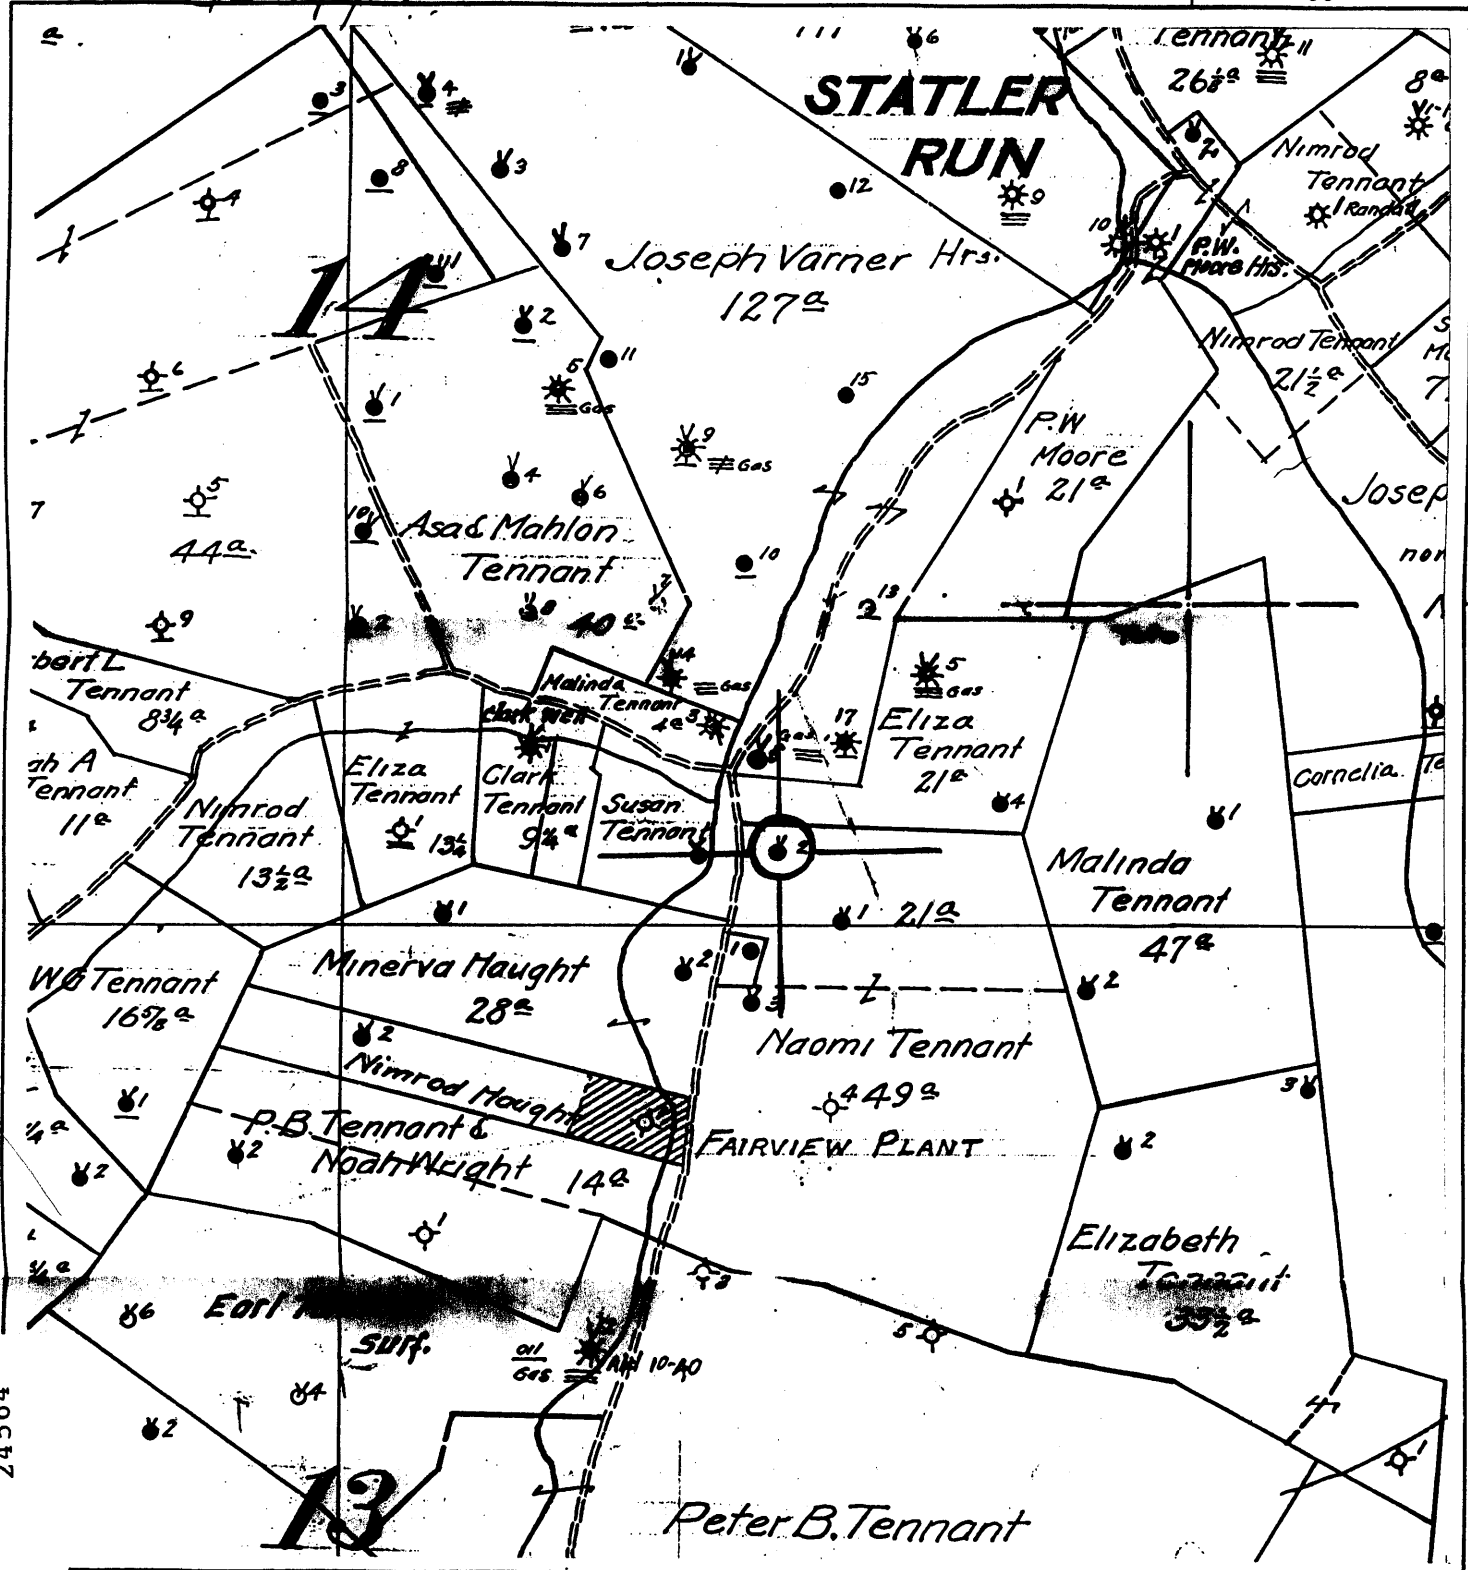

Scale 1" = 800'

THE UNDERSIGNED, HEREBY CERTIFY THAT THIS PLAT IS CORRECT TO THE BEST OF MY KNOWLEDGE AND BELIEF.

SIGNED *Philip S. Ondrusek*
 TITLE Supervisor, Surveying/Mapping

STATE OF WEST VIRGINIA
 DIVISION OF ENVIRONMENTAL PROTECTION
 OFFICE OF OIL AND GAS

DATE October 13, 19 97
 FARM Naomi Tennant NO. 2
 API WELL NO. 47-061-1288-D
 ASSIGNED # 061-71451

WELL TYPE: OIL GAS LIQUID INJECTION WASTE DISPOSAL P&A (Re-Set Monument)
 (IF "GAS") PRODUCTION STORAGE DEEP SHALLOW
 LOCATION: ELEVATION 1070' (Topo) WATERSHED Jakes Run
 DISTRICT Clay COUNTY Monongalia
 QUADRANGLE Blacksville 7.5' 256

SURFACE OWNER George Tennant ACREAGE 1
 OIL & GAS ROYALTY OWNER Unknown LEASE ACREAGE 1
 LEASE NO. _____
 PRODUCING FORMATION Big Injun TOTAL DEPTH 2068'
 WELL OPERATOR Pennzoil Products Company DESIGNATED AGENT Philip S. Ondrusek
 *ADDRESS P.O. Box 5519 ADDRESS P.O. Box 5519
Vienna, WV 26105 Vienna, WV 26105

(066)

SOUTH PENN OIL COMPANY—COMPLETION

RECEIVED
 Office of Oil & Gas
 UIC Section
 OCT 15 1997
 W. Va. Division of
 Environmental Protection

SERIAL NO. _____ FARM Tennant Naomi WELL No. 2
 ELEVATION _____ N. 13-14 S. _____ E. 25 W. _____
 LEASE No. _____ ACRES 70
 WATERS OF Jakes Run
 DISTRICT Clay COUNTY Monongalia STATE W. Va.
 DRILLING COMMENCED 6/10/96 COMPLETED 8/17/96 DEPTH 2068'

SANDS	TOP	BOTTOM	ELEV. TOP	CASING	Used
PGH. COAL #####	640			10"	653
Big Injun	1935			8 1/2"	1481
1st. Pay	2033			6 5/8"	1660
2nd. "	2043			5, 3/16"	281

INITIAL PROD. No Record SAND Injun DEPTH 2033-2043
 GAS TEST _____
 SHOT 5 Times QUARTS 5 to 60 qts.

REMARKS _____
 REPORTED BY [Signature] ABANDONED 12/27/19
F. O. 534-5M-10

661-1288-N

NOV 07 1997

STATE OF WEST VIRGINIA
DIVISION OF ENVIRONMENTAL PROTECTION
SECTION OF OIL AND GAS

WELL REGISTER ASSIGNMENT

This API Number 47- 61-01288, issued to PENNZOIL PRODUCTS COMPANY is evidence of permission to operate the well that is referenced at the location described on the attached plat, subject to the provisions of Chapters 22 and 22B of the West Virginia Code of 1931, as amended, and all rules and regulations promulgated thereunder. The name and telephone number of the Oil and Gas Inspector for this well is RANDAL MICK -
304-288-4600.

Spills or emergency discharges must be reported to 1-800-654-3312.

Failure to abide by all statutory and regulatory provisions governing all duties and operations hereunder may result in suspension or revocation of your permits and in addition may result in civil and/or criminal penalties.

The enclosed WR-35 must be completed by you and returned to this office. In addition annual production reports must be submitted on this well and failure to do so may require you to plug the well.

Theodore M. Streit
Chief

By: 

Title: _____

Operator's Well No: N. TENNANT #2

Farm Name: TENNANT, GEORGE

API Well Number : 47- 61-01288 N

Date Issued : 11/03/97

NOV 07 1997