


(+) DENOTES LOCATION OF WELL ON U.S.G.S. TOPOGRAPHIC MAP

N

CONSOLIDATION COAL CO.
150 AC.
967/68
27-20

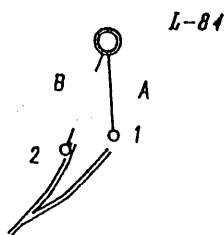

CONSOLIDATION COAL CO.
150 AC.
967/68
27-20

TIES

A - 175 10 36 243.42'
B - 200 39 49 301.52'

NOTE :

- 1) CONSOLIDATION COAL COMPANY ET.AL. OWN THE MINERAL ON THIS TRACT.
- 2) THIS WELL IS AN EXISTING VENTILATION BOREHOLE BEING CONVERTED TO A CBM GOB WELL.


- 1 - CONSOL WELL # 3864 (Plugged)
- 2 - 10" POWER POLE

FILE NO. 02-HH-37
 DRAWN BY: R.A. KITZMILLER
 SCALE: 1:500'
 MIN. DEGREE OF ACCURACY 1/200'
 PROVE'N SOURCE OF ELEVATION: _____

 SPOT ELEVATION _____

I THE UNDERSIGNED, HEREBY CERTIFY THAT THIS PLAT IS CORRECT TO THE BEST OF MY KNOWLEDGE AND BELIEF AND SHOWS ALL THE INFORMATION REQUIRED BY LAW AND THE REGULATIONS ISSUED AND PRESCRIBED BY THE DIVISION OF ENVIRONMENTAL PROTECTION.

(SIGNED) Robert A. Kitzmiller
 Professional Surveyor No. 635

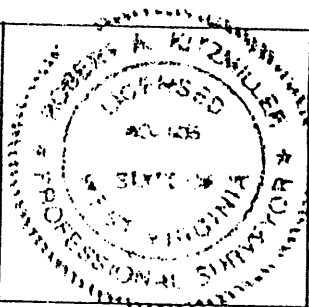

WV. DEPT. OF ENVIRONMENTAL PROTECTION
 OFFICE OF OIL AND GAS DIVISION
 1356 HANSFORD STREET
 CHARLESTON, WV. 25301



DATE OCTOBER 4, 2002
 OPERATOR'S WELL NO. L-84
 API WELL NO. _____
47-061-01466C
 STATE COUNTY PERMIT NO.

WELL TYPE: OIL GAS CBM LIQUID INJECTION WASTE DISPOSAL

IF "GAS", PRODUCTION STORAGE DEEP SHALLOW

LOCATION: ELEVATION 1354' WATERSHED PAW PAW CREEK

DISTRICT BATTELLE COUNTY MONONGALIA

QUADRANGLE MANNINGTON NEAREST TOWN KLONDIKE

SURFACE OWNER CONSOLIDATION COAL CO. ACREAGE 150 AC.

OIL & GAS ROYALTY OWNER * See Note LEASE ACREAGE _____

LEASE NO. _____

PROPOSED WORK: DRILL CONVERT DRILL DEEPER REDRILL FRACTURE OR STIMULATE
 PLUG OFF OLD FORMATION PERFORATE NEW FORMATION
 OTHER PHYSICAL CHANGE IN WELL (SPECIFY) EXISTING VENTILATION BOREHOLE BEING CONVERTED
 PLUG AND ABANDON CLEAN OUT AND REPLUG TO GOB WELL.

TARGET FORMATION PITTSBURGH ESTIMATED DEPTH 965'

WELL OPERATOR CNX GAS COMPANY LLC. (NORTH) DESIGNATED AGENT EDWIN L. MERRIFIELD JAN 24 2003

ADDRESS 1800 WASHINGTON ROAD ADDRESS 116 1/2 HUNSAKER STREET

PITTSBURGH, PA. 15421-1421 FAIRMONT, WV. 26554

(LOVERIDGE MINE (CBM 389) 6-6

State of West Virginia
 Department of Environmental Protection
 Office of Oil and Gas

Well Operator's Report of Well Work

Farm Name: Consolidation Coal Company Operator Well No.: L-84

LOCATION: Elevation: 1354 Quadrangle: Mannington

District: Battelle County: Monongalia
 Latitude: 3422.67 Feet South of 39 Deg. 37 Min. 30 Sec.
 Longitude: 2898.33 Feet West of 80 Deg. 17 Min. 30 Sec.

Company: CNX Gas Company LLC (North)

	Casing & Tubing	Used In Drilling	Left In Well	Cement Fill Up Cu. Ft.
Address: 1800 Washington Road Pittsburgh, PA 15241				
Agent: Edwin Merrifield				
Inspector: Steve Mossor				
Date Permit Issued: 1/21/2003				
Date Well Work Commenced: Existing Borehole				
Date Well Work Completed: Converted to well				
Verbal Plugging:				
Date Permission granted on:				
Rotary Cable Rig				
Total Depth (feet): 965				
Fresh Water Depth (ft.):				
Salt Water Depth (ft.):				
Is coal being mined in area (N/Y)? No				
Coal Depths (ft.): 950				

OPEN FLOW DATA

Producing formation	<u>Pittsburgh Coal Seam</u>	Pay zone depth (ft)	<u>950</u>
Gas: Initial open flow	<u>113</u> MCF/d	Oil: Initial open flow	<u>0</u> Bbl/d
Final open flow	<u>113</u> MCF/d	Final open flow	<u>0</u> Bbl/d
Time of open flow between initial and final tests	<u>0</u> Hours		
Static rock pressure	<u>1</u> psig (surface pressure) after	<u>-</u> Hours	
Second producing formation	<u>None</u>	Pay zone depth (ft)	
Gas: Initial open flow	<u></u> MCF/d	Oil: Initial open flow	<u></u> Bbl/d
Final open flow	<u></u> MCF/d	Final open flow	<u></u> Bbl/d
Time of open flow between initial and final tests	<u></u> Hours		
Static rock pressure	<u></u> psig (surface pressure) after	<u></u> Hours	

NOTE: ON BACK OF THIS FORM PUT THE FOLLOWING: 1). DETAILS OF PERFORATED INTERVALS, FRACTURING OR STIMULATING, PHYSICAL CHANGE, ETC. 2). THE WELL LOG WHICH IS A SYSTEMATIC DETAILED GEOLOGICAL RECORD OF ALL FORMATIONS INCLUDING COAL ENCOUNTERED BY THE WELLBORE.

Signed: Joseph P. Aman
 By: Joseph P. Aman
 Date: September 2, 2004

RECEIVED
 Office of Oil & Gas
 Office of Chief
 SEP 07 2004
 WV Department of
 Environmental Protection
 OCT 15 2004

MONO 1466