


(+) DENOTES LOCATION OF WELL ON U.S.G.S. TOPOGRAPHIC MAP

LATITUDE 39 37' 30"

LONGITUDE 80 17' 30"

4530.00'

N

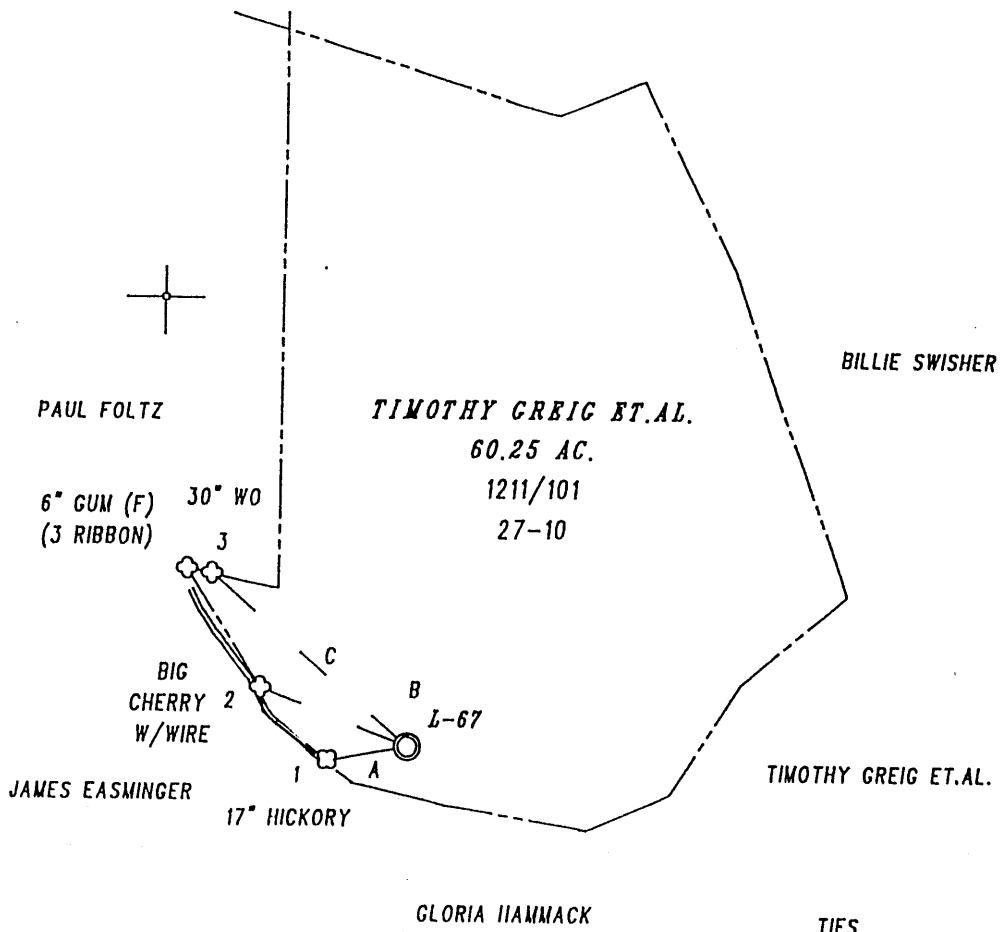

TIES
 A - 260 34 16 212.96'
 B - 291 26 52 417.60'
 C - 310 44 57 684.89'


NOTE :

- 1) CONSOLIDATION COAL COMPANY ET.AL. OWN THE MINERAL ON THIS TRACT.
 - 2) THIS WELL IS AN EXISTING VENTILATION BORE-HOLE BEING CONVERTED TO A CBM GOB WELL.
- 1 - 17" HICKORY TREE
 - 2 - BIG CHERRY TREE WITH OLD WIRE
 - 3 - 30" WHITE OAK TREE

DATE: 02-11-20
 DRAWN BY: R.A. KITZMILLER
 SCALE: 1:500'
 WELLS: 1 / 200'
 PROVEN SOURCE OF INFORMATION:
 SPOT ELEVATION

I THE UNDERSIGNED, HEREBY CERTIFY THAT THIS PLAT IS CORRECT TO THE BEST OF MY KNOWLEDGE AND BELIEF AND SHOWS ALL THE INFORMATION REQUIRED BY LAW AND THE REGULATIONS ISSUED AND PRESCRIBED BY THE DIVISION OF ENVIRONMENTAL PROTECTION.

(SIGNED) *Robert A. Kitzmiller*
 Professional Surveyor No. 835

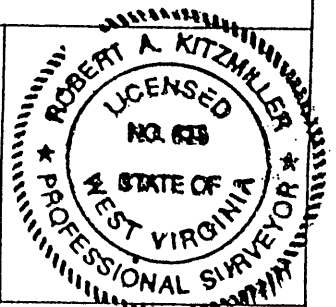

WV. DEPT. OF ENVIRONMENTAL PROTECTION
 OFFICE OF OIL AND GAS DIVISION
 1356 HANSFORD STREET
 CHARLESTON, WV. 25301



DATE: JULY 16, 20 02
 OPERATOR'S WELL NO. L-67
 API WELL NO.
 47 - 061 - 01470C
 STATE COUNTY PERMIT NO.

WELL TYPE: OIL GAS CBM LIQUID INJECTION WASTE DISPOSAL
 IF "GAS", PRODUCTION STORAGE DEEP SHALLOW
 LOCATION: ELEVATION 1546' WATERSHED RIGHT BRANCH OF MIRACLE RUN
 DISTRICT BATTLE COUNTY MONONGALIA
 QUADRANGLE MANNINGTON NEAREST TOWN ST. LEO
 SURFACE OWNER TIMOTHY GREIG ET.AL. ACREAGE 60.25 AC.
 OIL & GAS ROYALTY OWNER * See Note LEASE ACREAGE ---
 LEASE NO. ---

PROPOSED WORK: DRILL CONVERT DRILL DEEPER REDRILL FRACTURE OR STIMULATE
 PLUG OFF OLD FORMATION PERFORATE NEW FORMATION
 OTHER PHYSICAL CHANGE IN WELL (SPECIFY) EXISTING VENTILATION BOREHOLE BEING CONVERTED
 PLUG AND ABANDON CLEAN OUT AND REPLUG TO GOB WELL.
 TARGET FORMATION PITTSBURGH ESTIMATED DEPTH 1284'
 WELL OPERATOR CNX GAS COMPANY LLC. (NORTH) DESIGNATED AGENT EDWIN L. MERRIFIELD
 ADDRESS 1800 WASHINGTON ROAD ADDRESS 116 1/2 HUNSAKER STREET
 PITTSBURGH, PA. 15421-1421 FAIRMONT, WV. 26554

PRECISION SURVEYS FORM IV-6

MDNO COUNTY 1470C PERMIT NO.

State of West Virginia
 Department of Environmental Protection
 Office of Oil and Gas

Well Operator's Report of Well Work

Farm Name: Greig, Timothy, Etal Operator Well No.: L-67

LOCATION: Elevation: 1546 Quadrangle: Mannington

District: Battelle County: Monongalia
 Latitude: 4530.0 Feet South of 39 Deg. 37 Min. 30 Sec.
 Longitude: 10026.66 Feet West of 80 Deg. 17 Min. 30 Sec.

Company: CNX Gas Company LLC (North)

	Casing & Tubing	Used In Drilling	Left In Well	Cement Fill Up Cu. Ft.
Address: 1800 Washington Road Pittsburgh, PA 15241				
Agent: Edwin Merrifield				
Inspector: Steve Mossor				
Date Permit Issued: 3/03/2003				
Date Well Work Commenced: Existing Borehole				
Date Well Work Completed: Converted to well				
Verbal Plugging:				
Date Permission granted on:				
Rotary Cable Rig				
Total Depth (feet): 1284				
Fresh Water Depth (ft.):				
Salt Water Depth (ft.):				
Is coal being mined in area (N/Y)? No				
Coal Depths (ft.): 1275				

OPEN FLOW DATA

Producing formation	<u>Pittsburgh Coal Seam</u>	Pay zone depth (ft)	<u>1275</u>
Gas: Initial open flow	<u>60</u> MCF/d	Oil: Initial open flow	<u>0</u> Bbl/d
Final open flow	<u>60</u> MCF/d	Final open flow	<u>0</u> Bbl/d
Time of open flow between initial and final tests	<u>0</u> Hours		
Static rock pressure	<u>1</u> psig (surface pressure) after	<u>-</u> Hours	
Second producing formation	<u>None</u>	Pay zone depth (ft)	
Gas: Initial open flow	<u></u> MCF/d	Oil: Initial open flow	<u></u> Bbl/d
Final open flow	<u></u> MCF/d	Final open flow	<u></u> Bbl/d
Time of open flow between initial and final tests	<u></u> Hours		
Static rock pressure	<u></u> psig (surface pressure) after	<u></u> Hours	

NOTE: ON BACK OF THIS FORM PUT THE FOLLOWING: 1). DETAILS OF PERFORATED INTERVALS, FRACTURING OR STIMULATING, PHYSICAL CHANGE, ETC. 2). THE WELL LOG WHICH IS A SYSTEMATIC DETAILED GEOLOGICAL RECORD OF ALL FORMATION INCLUDING COAL ENCOUNTERED BY THE WELLBORE.

Signed: Joseph P. Aman
 By: Joseph P. Aman
 Date: September 2, 2004

RECEIVED
 Director of Oil & Gas
 Office of Chief
 SEP 07 2004
 WV Department of
 Environmental Protection
 OCT 15 2004

MONO 1470