

10,741


LATITUDE 39° 40' 00"

10,741'

3,763'

LONGITUDE 80° 12' 30"

TOPO. LOC.  
BLACKSVILLE QUAD.  
7 1/2' SERIES

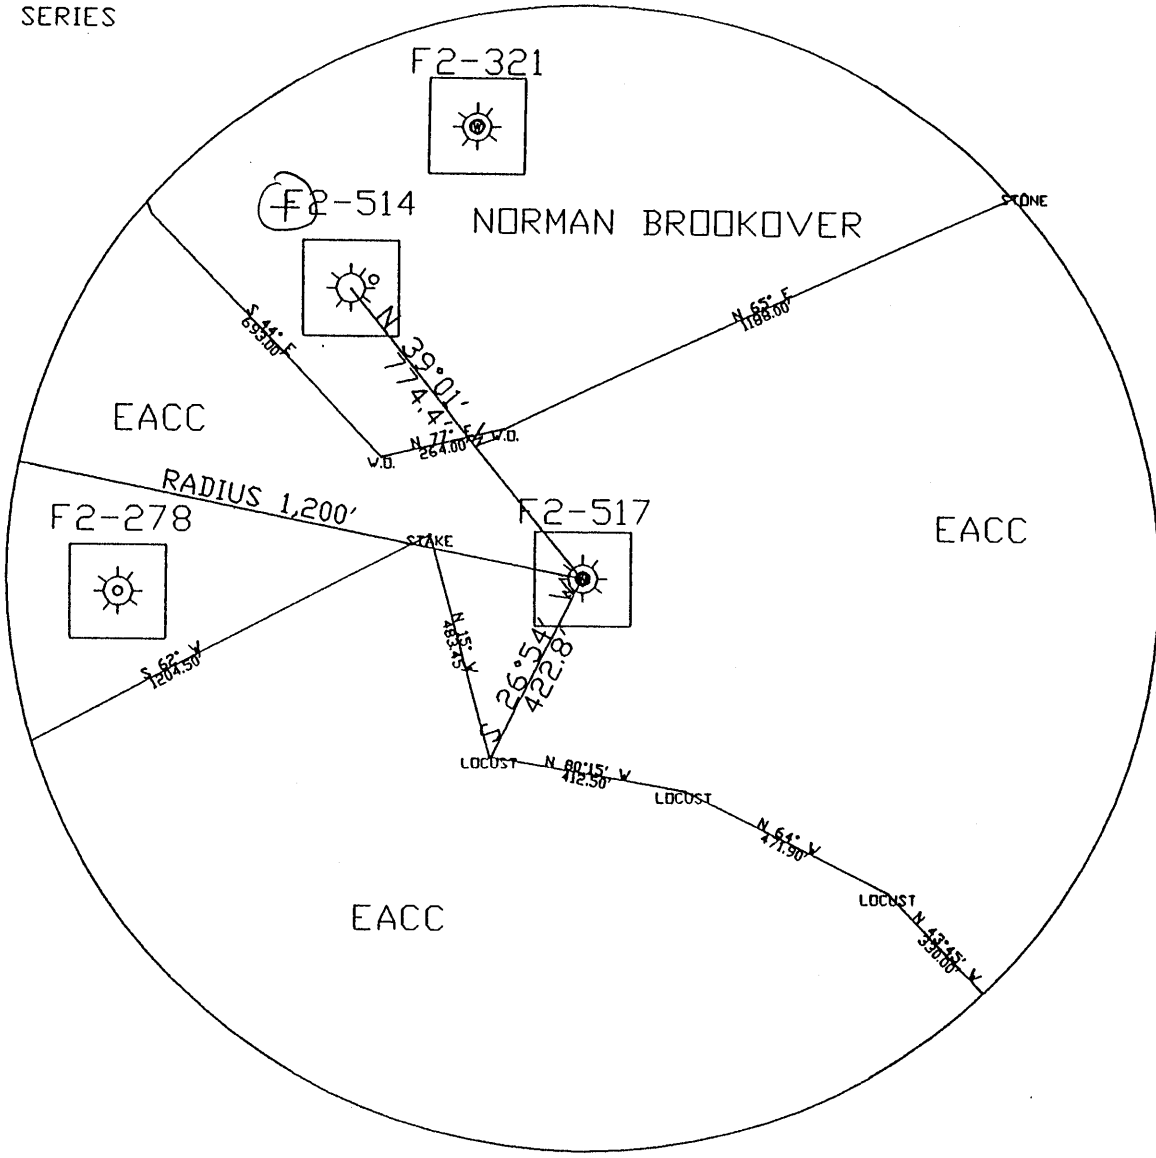


3763

FILE NO. N/A  
 DRAWING NO. F2-517 PLUG  
 SCALE 1"=400'  
 MINIMUM DEGREE OF  
 ACCURACY 1/2500'  
 PROVEN SOURCE OF  
 ELEVATION USGS B.M.

I THE UNDERSIGNED, HEREBY CERTIFY  
 THAT THIS PLAT IS CORRECT TO THE  
 BEST OF MY KNOWLEDGE AND BELIEF AND  
 SHOWS ALL THE INFORMATION REQUIRED  
 BY LAW AND THE REGULATIONS ISSUED  
 AND PRESCRIBED BY THE DEPARTMENT OF  
 MINES.

(SIGNED) John F. Ewell Jr.  
 R.P.E. 11133 L.L.S.

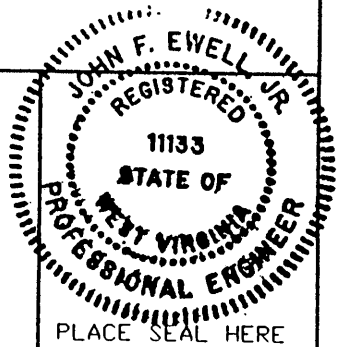

(+) DENOTES LOCATION OF  
 WELL ON UNITED STATES  
 TOPOGRAPHIC MAPS

DATE August 29, 2003  
 OPERATOR'S WELL NO. F2-517  
 API WELL NO.

FORM IV-6

(8-78)

STATE OF WEST VIRGINIA  
 DEPARTMENT OF ENVIRONMENTAL PROTECTION  
 OIL AND GAS DIVISION

47-061-01481P  
 STATE COUNTY PERMIT

was: 061 71136

WELL TYPE: OIL \_\_\_ GAS X LIQUID INJECTION \_\_\_ WASTE DISPOSAL \_\_\_  
 (IF GAS, PRODUCTION \_\_\_ STORAGE \_\_\_ DEEP \_\_\_ SHALLOW X \_\_\_)  
 LOCATION: ELEVATION 1,410' WATERSHED \_\_\_ DAYS RUN \_\_\_  
 DISTRICT BATTELLE COUNTY MONONGALIA  
 QUADRANGLE BLACKSVILLE  
 SURFACE OWNER EASTERN ASSOCIATED COAL CORP. ACREAGE 286.6  
 OIL & GAS ROYALTY OWNER UNKNOWN LEASE ACREAGE \_\_\_  
 LEASE NO. \_\_\_

PROPOSED WORK: DRILL \_\_\_ CONVERT \_\_\_ DRILL DEEPER \_\_\_ REDRILL X FRACTURE OR  
 STIMULATE \_\_\_ PLUG OFF OLD FORMATION \_\_\_ PERFORATE NEW  
 FORMATION \_\_\_ OTHER PHYSICAL CHANGE IN WELL (SPECIFY) \_\_\_

PLUG AND ABANDON \_\_\_ CLEAN OUT AND REPLUG X \_\_\_  
 TARGET FORMATION BAYARD SAND ESTIMATED DEPTH 3,250'  
 WELL OPERATOR EASTERN ASSOC. COAL CORP. DESIGNATED AGENT EDWARD Y. HOY  
 ADDRESS 1044 MIRACLE RUN ROAD ADDRESS 1044 MIRACLE RUN ROAD  
FAIRVIEW WV, 26570 FAIRVIEW WV, 26570

MONO 1481-P

SEP 14 2003