

TOP HOLE (UTM NAD 83)	
N)	4394775.0
E)	569973.9
BOTTOM HOLE (UTM NAD 83)	
N)	4396694.3
E)	568545.6

REFERENCE LINES	
1	N 23°19'38" W 1,040'
2	N 23°47'24" W 1,138'
3	N 34°42'57" E 1,040'

REFERENCE NOTES
Boundaries as shown taken from deeds, tax maps and field locations. A full boundary survey is not expressed nor implied. All bearings are based on true north. Ownership taken from public records MONONGALIA County, West Virginia JUNE 2013
State Plane Coordinates & NAD 83 Lat/Long by differential stationer mapping grade GPS drafted by EAM

NOTE:
NO WATER WELLS WERE FOUND WITHIN 250' OF THE CENTER OF WELL PAD.
NO DWELLINGS WERE FOUND WITHIN 625' OF THE CENTER OF WELL PAD.

FILE #: NNE12
DRAWING #: 2323
SCALE: PLAT: 1" = 1200'
TRK: 1" = 2000'
MINIMUM DEGREE OF ACCURACY: 1/200
PROVEN SOURCE OF ELEVATION: SUBMETER MAPPING GRADE GPS

I, THE UNDERSIGNED, HEREBY CERTIFY THAT THIS PLAT IS CORRECT TO THE BEST OF MY KNOWLEDGE AND BELIEF AND SHOWS ALL THE INFORMATION REQUIRED BY LAW AND THE REGULATIONS ISSUED AND PRESCRIBED BY THE DEPARTMENT OF ENVIRONMENTAL PROTECTION.
Signed: [Signature]
L.L.S. #2124 : Ernest J. Benchek III



(+) DENOTES LOCATION OF WELL ON UNITED STATES TOPOGRAPHIC MAPS WVDEP
OFFICE OF OIL & GAS
601 57TH STREET
CHARLESTON, WV 25304


Well Type: Oil Waste Diposal Production Deep
 Gas Liquid Injection Storage Shallow

WATERSHED: DUNKARD CREEK
COUNTY/DISTRICT: MONONGALIA / CLAY
SURFACE OWNER: ELLEN F. CAMPBELL
OIL & GAS ROYALTY OWNER: ELLEN FOLEY CAMPBELL, ET AL
LEASE NUMBERS: _____



DATE: AUGUST 11, 2015
OPERATOR'S WELL #: CAMPBELL NO. 3H
API WELL #: 47 61 D1722 H6A
STATE COUNTY PERMIT
AS-BUILT ELEVATION: 1,293.6' *Replacement Borehole*
QUADRANGLE: BLACKSVILLE
ACREAGE: 7.05 +/- 08/28/2015
ACREAGE: 558.85 +/-

TARGET FORMATION: MARCELLUS
ESTIMATED DEPTH: TVD: 8,118' TMD: 15,971'
WELL OPERATOR: NORTHEAST NATURAL ENERGY LLC
DESIGNATED AGENT: JOHN ADAMS
ADDRESS: 707 VIRGINIA STREET EAST, SUITE 1200
CITY: CHARLESTON STATE: WV ZIP CODE: 25301

DRILL CONVERT DRILL DEEPER REDRILL FRACTURE OR STIMULATE
PLUG OFF FORMATION PERFORATE NEW FORMATION PLUG & ABANDON
CLEAN OUT & REPLUG OTHER CHANGE (SPECIFY): _____

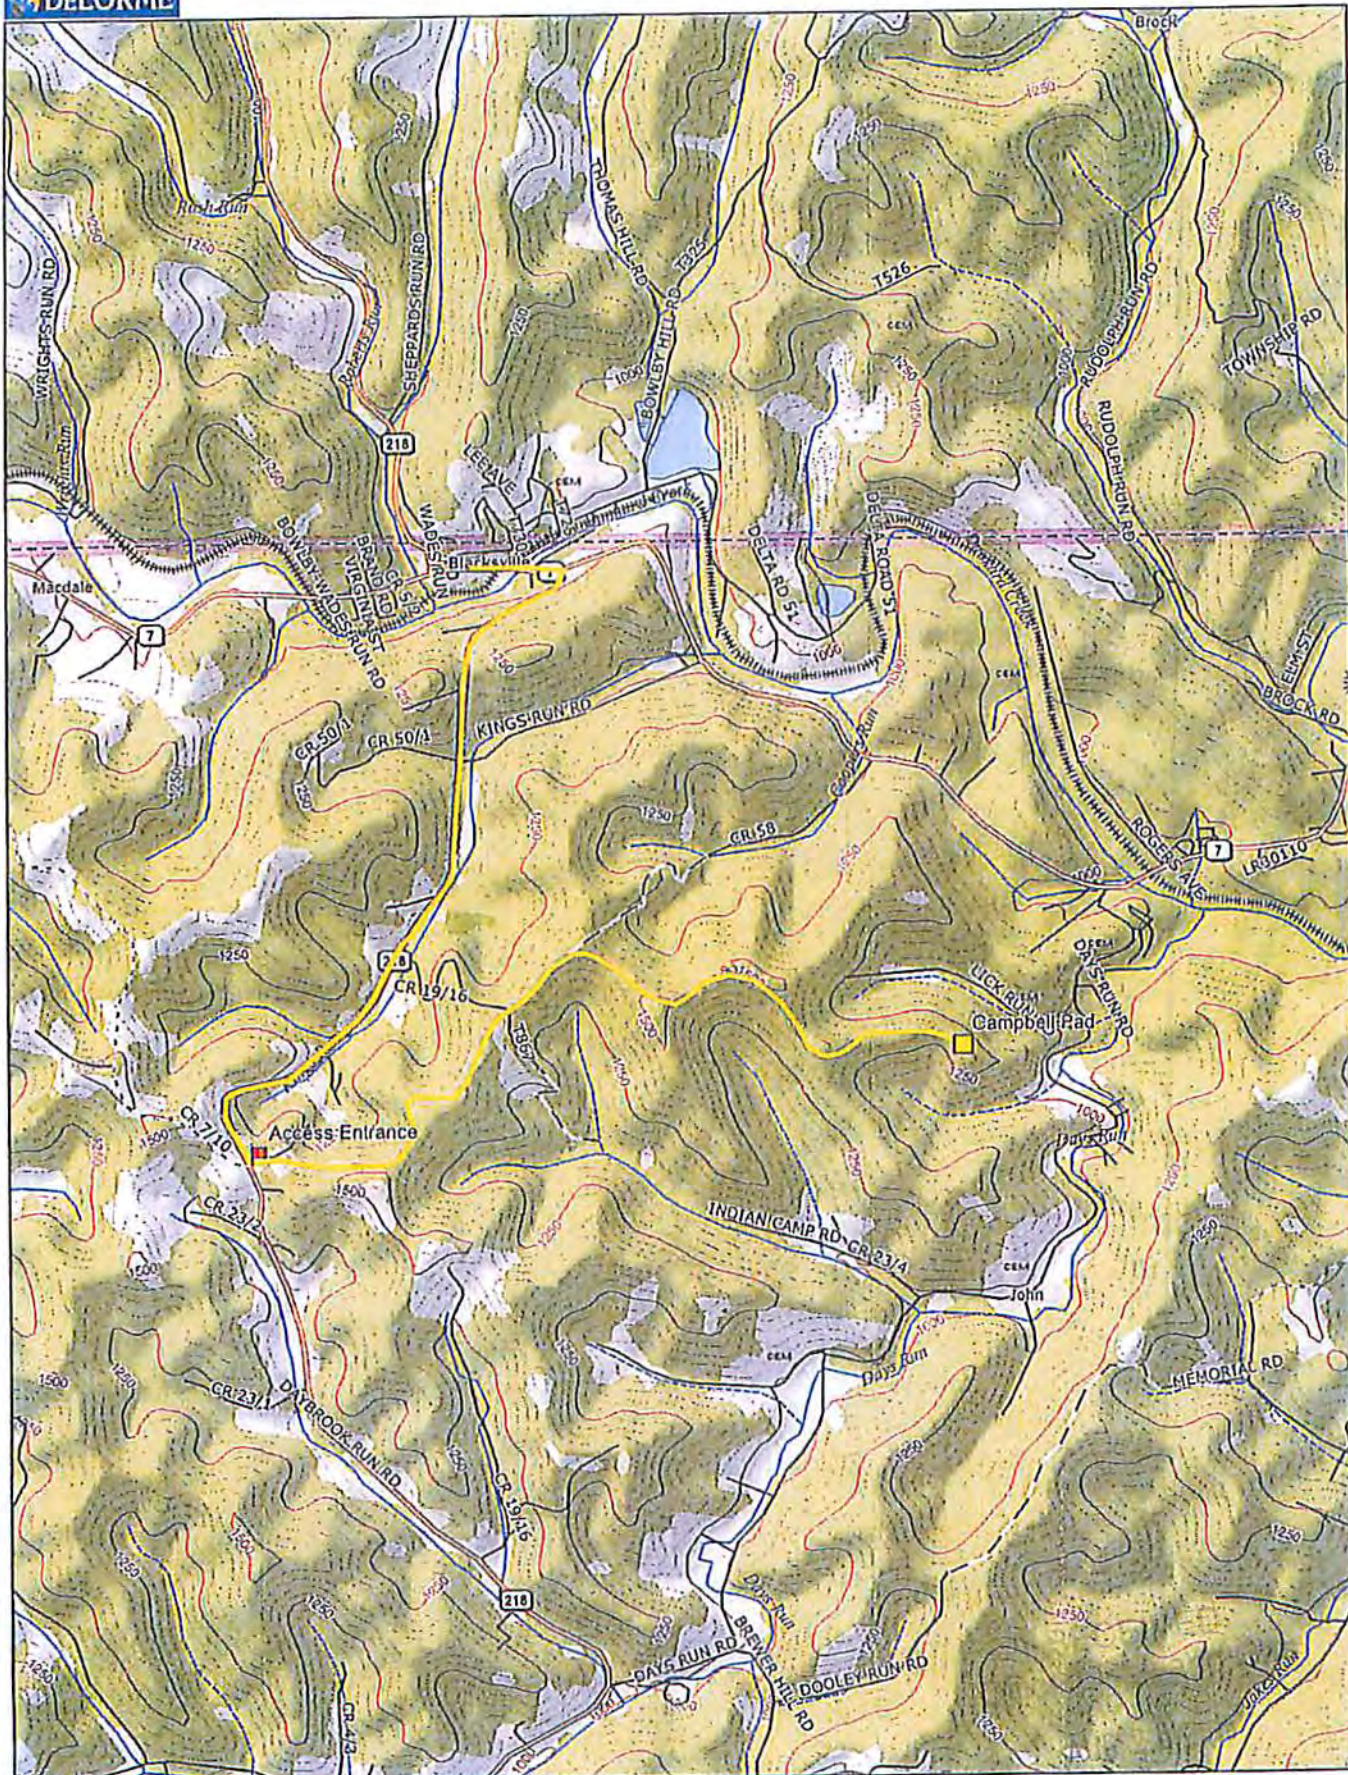

Data use subject to license.
© DeLorme. XMap® 7.
www.delorme.com

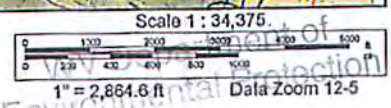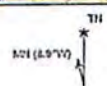

08/28/2015