

STATE OF WEST VIRGINIA
DEPARTMENT OF ENVIRONMENTAL PROTECTION
OFFICE OF OIL AND GAS

ORIGINAL

AFFIDAVIT OF PLUGGING AND FILLING WELL

AFFIDAVIT SHOULD BE IN TRIPLICATE, one copy mailed to the Department, one copy to be retained by the Well Operator and the third copy (and extra copies if required) should be mailed to each coal operator at their respective addresses.

Farm name: Consolidation Coal Company Operator Well No. 8333-B

LOCATION: Elevation: 1164.95' Quadrangle: HUNDRED WV, PA 7.5'
District: Battelle County: Monongalia
Latitude: _____ Feet South of 39 Deg. 38 Min. 12.17 Sec.
Longitude: _____ Feet West of 80 Deg. 23 Min. 00.89 Sec.

Well Type: OIL _____ GAS X

Company Consolidation Coal Co Coal Operator 1 Bridge St
or Owner Monongah, WV 26554
Coal Operator _____
Agent David Roddy or Owner _____
Permit Issued Date 04/23/2018

AFFIDAVIT

STATE OF WEST VIRGINIA,
County of Monongalia ss:

William H. Barker and Kevin S. Wright being first duly sworn according to law depose and say that they are experienced in the work of plugging and filling oil and gas wells and were employed by the above named well operator, and participated in the work of plugging and filling the above well say that said work was commenced on the 26th day of June, 2018, and the well was plugged and filled in the following manner:

| TYPE | FROM | TO | PIPE REMOVED | LEFT |
|--------------|---------|---------|--------------|------|
| Expandable | 279' | Surface | | |
| 7" Conductor | Surface | 15' | 0' | 15' |
| | | | | |
| | | | | |
| | | | | |
| | | | | |

RECEIVED
Office of Oil and Gas

JUL 27 2018

Description of monument: 77' of 7" casing with company name, well #, API #, and date cemented. and that the work of plugging and filling said well was completed on the 28th day of June, 2018.

And further deponents saith not. William H. Barker
Kevin S. Wright

Sworn and subscribe before me this _____ day of _____, 20____



My commission expires _____

Affidavit reviewed by the Office of Oil and Gas: Hayma J. Kuhn Notary Public Title: INSPECTOR

7/26/2018

Plugging Report for MSHA

Well Number: 8333-B Mine: Marion County Mine

Permit Number: 47-061-01808

Date Clean Out Started: 6/26/2018

Date Well Bore Plugged: 6/28/2018


Pillsburgh Coal Seam: _____ ft. To _____ ft.

Plugs:
From _____ To _____ Type of Cement _____

279' Surface Class A Expandable Cement

Casing Remaining in Well Bore

Total Depth: 279'

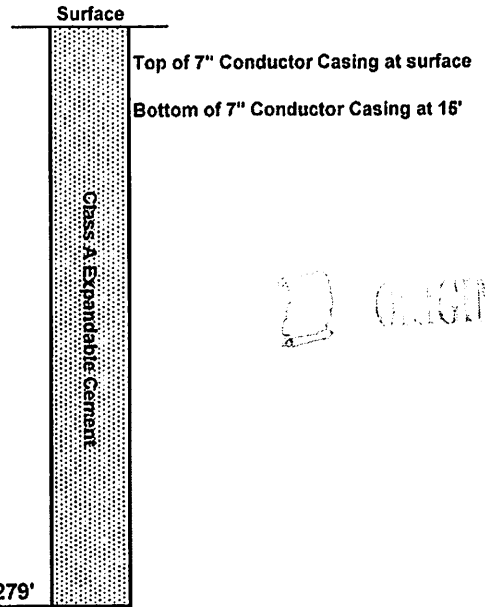

| | Top | Bottom | Left | Pulled |
|---------------|---------|--------|------|--------|
| Sucker Rods | | | | |
| 2 3/8" tubing | | | | |
| 5 1/2" casing | | | | |
| 7" Conductor | Surface | 15' | 15' | 0' |
| 7" casing | | | | |
| 8 5/8" casing | | | | |
| 16" casing | | | | |
| Other | | | | |

Cement:

Expandable _____ 55 _____ sacks
 Thixotropic _____ 0 _____ sacks
 Econofill _____ _____ sacks
 Mud Flush _____ 1000 _____ gal
 Other _____ _____
 Est. Top Thix _____ ft
 Did Cement Circ. _____ Yes _____

Comments:

Caving: Extreme Moderate Normal
 Lost Circulation: Extreme Moderate Normal
 Difficulty in Removing Casing: Extreme Moderate Normal Not Apply
 Debris in Well Bore: Wood Steel Other: _____

Surface Elevation (Surveyed) _____
 Bottom of Coal Structure (Map) _____
 Difference 0

RECEIVED
 Office of Oil and Gas
 JUL 27 2018
 WV Department of
 Environmental Protection

08/10/2018

Supplemental

FORM WR-38
(Affidavit of Plugging)

WEST VIRGINIA
DEPARTMENT OF ENVIRONMENTAL PROTECTION
OIL AND GAS WELLS DIVISION

AFFIDAVIT OF PLUGGING AND FILLING WELL

AFFIDAVIT SHOULD BE MADE IN TRIPPLICATE, one copy mailed to the Division, one copy to be retained by the Well Operator and the third copy (and extra copies if required) should be mailed to each coal operator at their respective addresses.

CONSOLIDATION COAL CO.
Coal Operator or Owner
1 BRIDGE STREET MONONGAH, WV 26554
Address
CONSOLIDATION COAL CO.
Coal Operator or Owner
1 BRIDGE STREET MONONGAH, WV 26554
Address
CONSOL MINING COMPANY LLC
Lease or Property Owner
1000 CONSOL ENERGY DRIVE CANONSBURG, PA 15317
Address

CONSOLIDATION COAL CO.
Name of Well Operator
1 BRIDGE STREET MONONGAH, WV 26554
Complete Address
HUNDRED WV, PA 7.5'
Well Location
BATTELLE
District
MONONGALIA
County
8333-B
Well No.
SABINA CAMP
Farm

 ORIGINAL

STATE INSPECTOR SUPERVISING PLUGGING

Maury J. Kuntz 7/21/2018

AFFIDAVIT

STATE OF WEST VIRGINIA,
County of MONONGALIA ss:
WILLIAM H. BARKER and KEVIN S. WRIGHT being first duly sworn according to law depose and say that they are experienced in the work of plugging and filling oil and gas wells and were employed by Consolidation Coal Company well operator, and participated in the work of plugging and filling the above well, that said work was commenced on the 26th day of June, 2018 and that the well was plugged in the following manner:

| Sand or Zone Record | Filling Material | Casing/Tubing Size | Casing Pulled | Casing Left In |
|---|------------------|--|---------------|----------------|
| Formation | | | | |
| Cleaned 6 1/2" hole from surface to 279'. New formation was found at 279'. | | 7" Conductor | 0' | 15' |
| Cemented hole from 279' back to the surface as follows: From 279' to the surface with 55 sacks of Class A Expandable cement. Cement did circulate at the surface. Left 15' of 7" conductor from the surface to 15'. | | | | |
| Coal Seams | | Description of Monument | | |
| Pittsburgh | (N/A) | 77" of 7" casing w/ company name, well number, permit number and date cemented stated on 7" casing. Well marker will be attached to cement plug at ground level. | | |

... and that the work of plugging and filling said well was completed on the 28th day of June, 2018

And further deponents saith not.

William H. Barker
William H. Barker
Kevin S. Wright
Kevin S. Wright


RECEIVED
Office of Oil and Gas
JUL 27 2018
WV Department of
Environmental Protection

Sworn to and subscribed before me this _____ day of _____

Notary Public

My commission expires:

Permit No. 47-061-01808-P
Well No. 8333-B
Latitude: 39° 38' 12.17"N
Longitude: 80° 23' 00.89"W

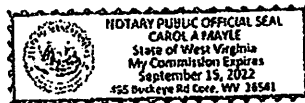

08/10/2018