


FILE #: _____
DRAWING #: 2958
SCALE: PLAT: 1" = 2400'
TICK: 1" = 2000'
MINIMUM DEGREE OF ACCURACY: 1/200
PROVEN SOURCE OF ELEVATION: SUBMETER MAPPING GRADE GPS

PLAT IS CORRECT TO THE BEST OF MY KNOWLEDGE AND BELIEF AND SHOWS ALL THE INFORMATION REQUIRED BY LAW AND THE REGULATIONS ISSUED AND PRESCRIBED BY THE DEPARTMENT OF ENVIRONMENTAL PROTECTION.
Signed: _____
L.L.S. #2124 : Ernest J. Benchek III

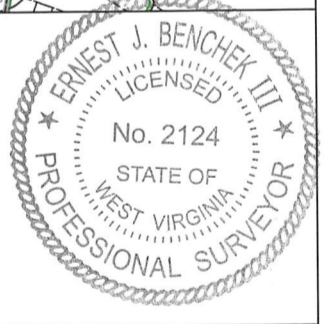

(+) DENOTES LOCATION OF WELL ON UNITED STATES TOPOGRAPHIC MAPS WYDEP
OFFICE OF OIL & GAS
601 57TH STREET
CHARLESTON, WV 25304
Well Type: Oil Waste Diposal Production Deep
 Gas Liquid Injection Storage Shallow
WATERSHED: DUNKARD CREEK
COUNTY/DISTRICT: MONONGALIA / BATELLE
SURFACE OWNER: CHARLES WENDELL MOORE & FRANK M. CHISLER
OIL & GAS ROYALTY OWNER: Pat L. Park, et al
LEASE NUMBERS: SEE PAGE 2
DRILL CONVERT DRILL DEEPER REDRILL FRACTURE OR STIMULATE
PLUG OFF FORMATION PERFORATE NEW FORMATION PLUG & ABANDON
CLEAN OUT & REPLUG OTHER CHANGE (SPECIFY): _____
TARGET FORMATION: MARCELLUS
WELL OPERATOR: NORTHEAST NATURAL ENERGY LLC
ADDRESS: 707 VIRGINIA STREET EAST, SUITE 1200
CITY: CHARLESTON STATE: WV ZIP CODE: 25301
DATE: MAY 30, 2023
OPERATOR'S WELL #: PHOENIX 4H AS-DRILLED
API WELL #: 47 61 01875
STATE COUNTY PERMIT
AS-BUILT ELEVATION: 1,503.5'
QUADRANGLE: WADESTOWN
ACREAGE: 466.30 +/-
ACREAGE: 1679.32/23/2024
DRILLED DEPTH: TVD: 8,057' TMD: 27,212'
DESIGNATED AGENT: JOHN ADAMS
ADDRESS: 707 VIRGINIA STREET EAST, SUITE 1200
CITY: CHARLESTON STATE: WV ZIP CODE: 25301

PROPERTY OWNER INDEX	
1-17-14.1	FRANK M. CHISLER
1-24-19.1	CHARLES WENDEL MOORE
1-24-18	JOHN RAYMOND & JENNIFER L. HORNSBY MYERS
4-19-12	EDITH L DARRAH
1-24-26	RANDY D & SUSAN K HAMILTON
4-19-18	CAROLYN S PAYTON
4-19-15	TIMOTHY ALAN DARRAH
4-19-16	CLAY & KATIE A FLUHARTY
4-26-10	BETTY C & BETTY A HAUGHT
4-26-8	BILLY C HAUGHT TRS ET AL
16-2-15	BILLY C & BETTY A HAUGHT
16-2-38	ROBERT E & LUELLA R CONAWAY
16-9-1.4	WACO OIL & GAS CO INC
16-2-14.5	SUE CHISLER
16-2-14.9	SUE CHISLER
16-9-41.1	JAMES R MOORE
16-9-2	AL MCPHERSON
16-9-40	JOHN & SANDRA J MOORE
4-26-11	CAROL S PAYTON

LEASE INDEX			
A	WV-061-004079-001	K	WV-061-004956-011
B	WV-061-004079-001	L	WV-061-004956-011
C	WV-061-003767-004	M	WV-061-005699-002
D	WV-061-004463-001	N	WV-061-005699-002
E	WV-061-004076-010	O	WV-061-000146-001-LOI
F	WV-061-005687-001	P	WV-061-000146-001-LOI
G	WV-061-001730-004	Q	WV-061-000146-001-LOI
H	WV-061-005109-026	R	WV-049-005267-001
I	WV-061-005588-001	S	WV-061-000146-001-LOI
J	WV-061-001906-020	T	WV-061-000146-001-LOI

RECEIVED
Office of Oil and Gas

JAN 16 2024

02/23/2024

WV Department of
Environmental Protection

FILE #: NEE14

DRAWING #: 2958

SCALE: N/A

DATE: MAY 30, 2023

OPERATOR'S WELL #: PHOENIX 4H AS-DRILLED

API WELL #: 47 61 01875
STATE COUNTY PERMIT