


FILE #: NNE14  
 DRAWING #: 2995  
 SCALE: PLAT: 1" = 2000'  
 TICK: 1" = 2000'  
 MINIMUM DEGREE OF ACCURACY: 1/200  
 PROVEN SOURCE OF ELEVATION: SUBMETER MAPPING GRADE GPS

I, THE UNDERSIGNED, HEREBY CERTIFY THAT THIS PLAT IS CORRECT TO THE BEST OF MY KNOWLEDGE AND BELIEF AND SHOWS ALL THE INFORMATION REQUIRED BY LAW AND THE REGULATIONS ISSUED AND PRESCRIBED BY THE DEPARTMENT OF ENVIRONMENTAL PROTECTION.  
 Signed: [Signature]  
 L.L.S. #2124 : Ernest J. Benchek III

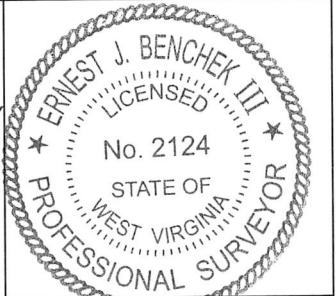

(+) DENOTES LOCATION OF WELL ON UNITED STATES TOPOGRAPHIC MAPS  
 WVDEP  
 OFFICE OF OIL & GAS  
 601 57TH STREET  
 CHARLESTON, WV 25304

DATE: SEPTEMBER 28, 2023  
 OPERATOR'S WELL #: McCLELLAN 1H SIDE TRACK AS-DRILLED  
 API WELL #: 47 61 01882  
 STATE COUNTY PERMIT  
 AS-BUILT ELEVATION: 1,411.7'

Well Type:  Oil  Waste Diposal  Production  Deep  
 Gas  Liquid Injection  Storage  Shallow

WATERSHED: UPPER MONONGAHELA  
 COUNTY/DISTRICT: MONONGALIA / BATTELLE  
 SURFACE OWNER: KLONDIKE REAL ESTATE PARTNERSHIP  
 OIL & GAS ROYALTY OWNER: Barbara June Sutton, et al  
 LEASE NUMBERS: \_\_\_\_\_

QUADRANGLE: MANNINGTON  
 ACREAGE: 1,143.1 +/-  
 ACREAGE: 129.4 **02/23/2024**

DRILL  CONVERT  DRILL DEEPER  REDRILL  FRACTURE OR STIMULATE   
 PLUG OFF FORMATION  PERFORATE NEW FORMATION  PLUG & ABANDON   
 CLEAN OUT & REPLUG  OTHER CHANGE  (SPECIFY): \_\_\_\_\_

TARGET FORMATION: MARCELLUS  
 DRILLED DEPTH: 1H TVD: 8,076' TMD: 23,323' SIDE TRACK TVD: 8,079' TMD: 21,139'  
 WELL OPERATOR: NORTHEAST NATURAL ENERGY LLC  
 DESIGNATED AGENT: JOHN ADAMS  
 ADDRESS: 707 VIRGINIA STREET EAST, SUITE 1200  
 ADDRESS: 707 VIRGINIA STREET EAST, SUITE 1200  
 CITY: CHARLESTON STATE: WV ZIP CODE: 25301  
 CITY: CHARLESTON STATE: WV ZIP CODE: 25301

PROPERTY OWNER INDEX	
1-26-7	KLONDIKE REAL ESTATE PARTNERSHIP
1-26-6	ROBERT G SANTEE ESTATE
1-24-7	CNX LAND LLC
1-24-8	NIFTY-FIFTY LLC
1-24-6	ALLEGHENY FORESTLANDS LLC
1-24-5	FRANCIS G SWISHER & THERESA TUTTLE
1-24-4	FRANCIS G SWISHER & THERESA TUTTLE
1-24-1	NELSON DALE & CHERYL LISBETH GALLAGHER
1-24-9.1	MARY C WALLS
1-18-43	BETTY J MARTINO
1-18-17	ERP FEDERAL MINING COMPLEX LLC

LEASE INDEX			
A	WV-061-004172-011	G	WV-061-004860-020
B	WV-061-004173-066	H	WV-061-004227-002
C	WV-061-004002-005	I	WV-061-700075-001
D	WV-061-004287-038	J	WV-061-005769-001
E	WV-061-005933-001	K	WV-061-003729-001
F	WV-061-004332-001	L	WV-061-003767-004

02/23/2024

FILE #: NEE14

DRAWING #: 2995

SCALE: N/A

DATE: SEPTEMBER 28, 2023

OPERATOR'S WELL #: McCLELLAN 1H SIDE TRACK  
AS-DRILLED

API WELL #: 47 61 01882  
STATE COUNTY PERMIT