

FILE #: NEE14
 DRAWING #: 3036
 SCALE: PLAT: 1" = 1800'
TICK MARK: 1" = 2000'
 MINIMUM DEGREE OF ACCURACY: 1/200
 PROVEN SOURCE OF ELEVATION: SUBMETER MAPPING GRADE GPS

I, THE UNDERSIGNED, HEREBY CERTIFY THAT THIS PLAT IS CORRECT TO THE BEST OF MY KNOWLEDGE AND BELIEF AND SHOWS ALL THE INFORMATION REQUIRED BY LAW AND THE REGULATIONS ISSUED AND PRESCRIBED BY THE DEPARTMENT OF ENVIRONMENTAL PROTECTION.
 Signed: [Signature]
 L.L.S. #2124 : Ernest J. Benchek III



(+) DENOTES LOCATION OF WELL ON UNITED STATES TOPOGRAPHIC MAPS WYDEP
 OFFICE OF OIL & GAS
 601 57TH STREET
 CHARLESTON, WV 25304

Well Type: Oil Waste Diposal Production Deep
 Gas Liquid Injection Storage Shallow

WATERSHED: DUNKARD CREEK
 COUNTY/DISTRICT: MONONGALIA / CLAY
 SURFACE OWNER: YOST HERITAGE INC
 OIL & GAS ROYALTY OWNER: _____
 LEASE NUMBERS: _____

DATE: OCTOBER 7, 2021
 OPERATOR'S WELL #: YOST 4H
 API WELL #: 47 61 01893
 STATE COUNTY PERMIT

AS-BUILT ELEVATION: 1,494.93'
 QUADRANGLE: BLACKSVILLE, WV
 ACREAGE: 93.08
 ACREAGE: 1104.079 +/-

DRILL CONVERT DRILL DEEPER REDRILL FRACTURE OR STIMULATE
 PLUG OFF FORMATION PERFORATE NEW FORMATION PLUG & ABANDON
 CLEAN OUT & REPLUG OTHER CHANGE (SPECIFY): _____

TARGET FORMATION: MARCELLUS
 ESTIMATED DEPTH: TVD: 8,280' TMD: 12,724'
 WELL OPERATOR: NORTHEAST NATURAL ENERGY LLC
 ADDRESS: 707 VIRGINIA STREET EAST, SUITE 1200
 CITY: CHARLESTON STATE: WV ZIP CODE: 25301
 DESIGNATED AGENT: JOHN ADAMS
 ADDRESS: 707 VIRGINIA STREET EAST, SUITE 1200
 CITY: CHARLESTON STATE: WV ZIP CODE: 25301

PROPERTY OWNER INDEX	
4-19-43.1	YOST HERITAGE INC
4-19-44.1	YOST HERITAGE INC
4-19-44	FREDDIE C, LOIS JEAN MCCOY ET AL
4-20-44	GARY D YOST
4-20-44.1	YOST HERITAGE INC
4-19-43.2	YOST HERITAGE INC

LEASE INDEX	
A	WV-061-001043-002
B	WV-061-003452-000
C	WV-061-001043-002
D	WV-061-001043-002
E	WV-061-004923-001

12/03/2021

FILE #: NEE14


DRAWING #: 2977

SCALE: N/A

DATE: OCTOBER 7, 2021

OPERATOR'S WELL #: YOST 4H


API WELL #: 47 61 01893
STATE COUNTY PERMIT

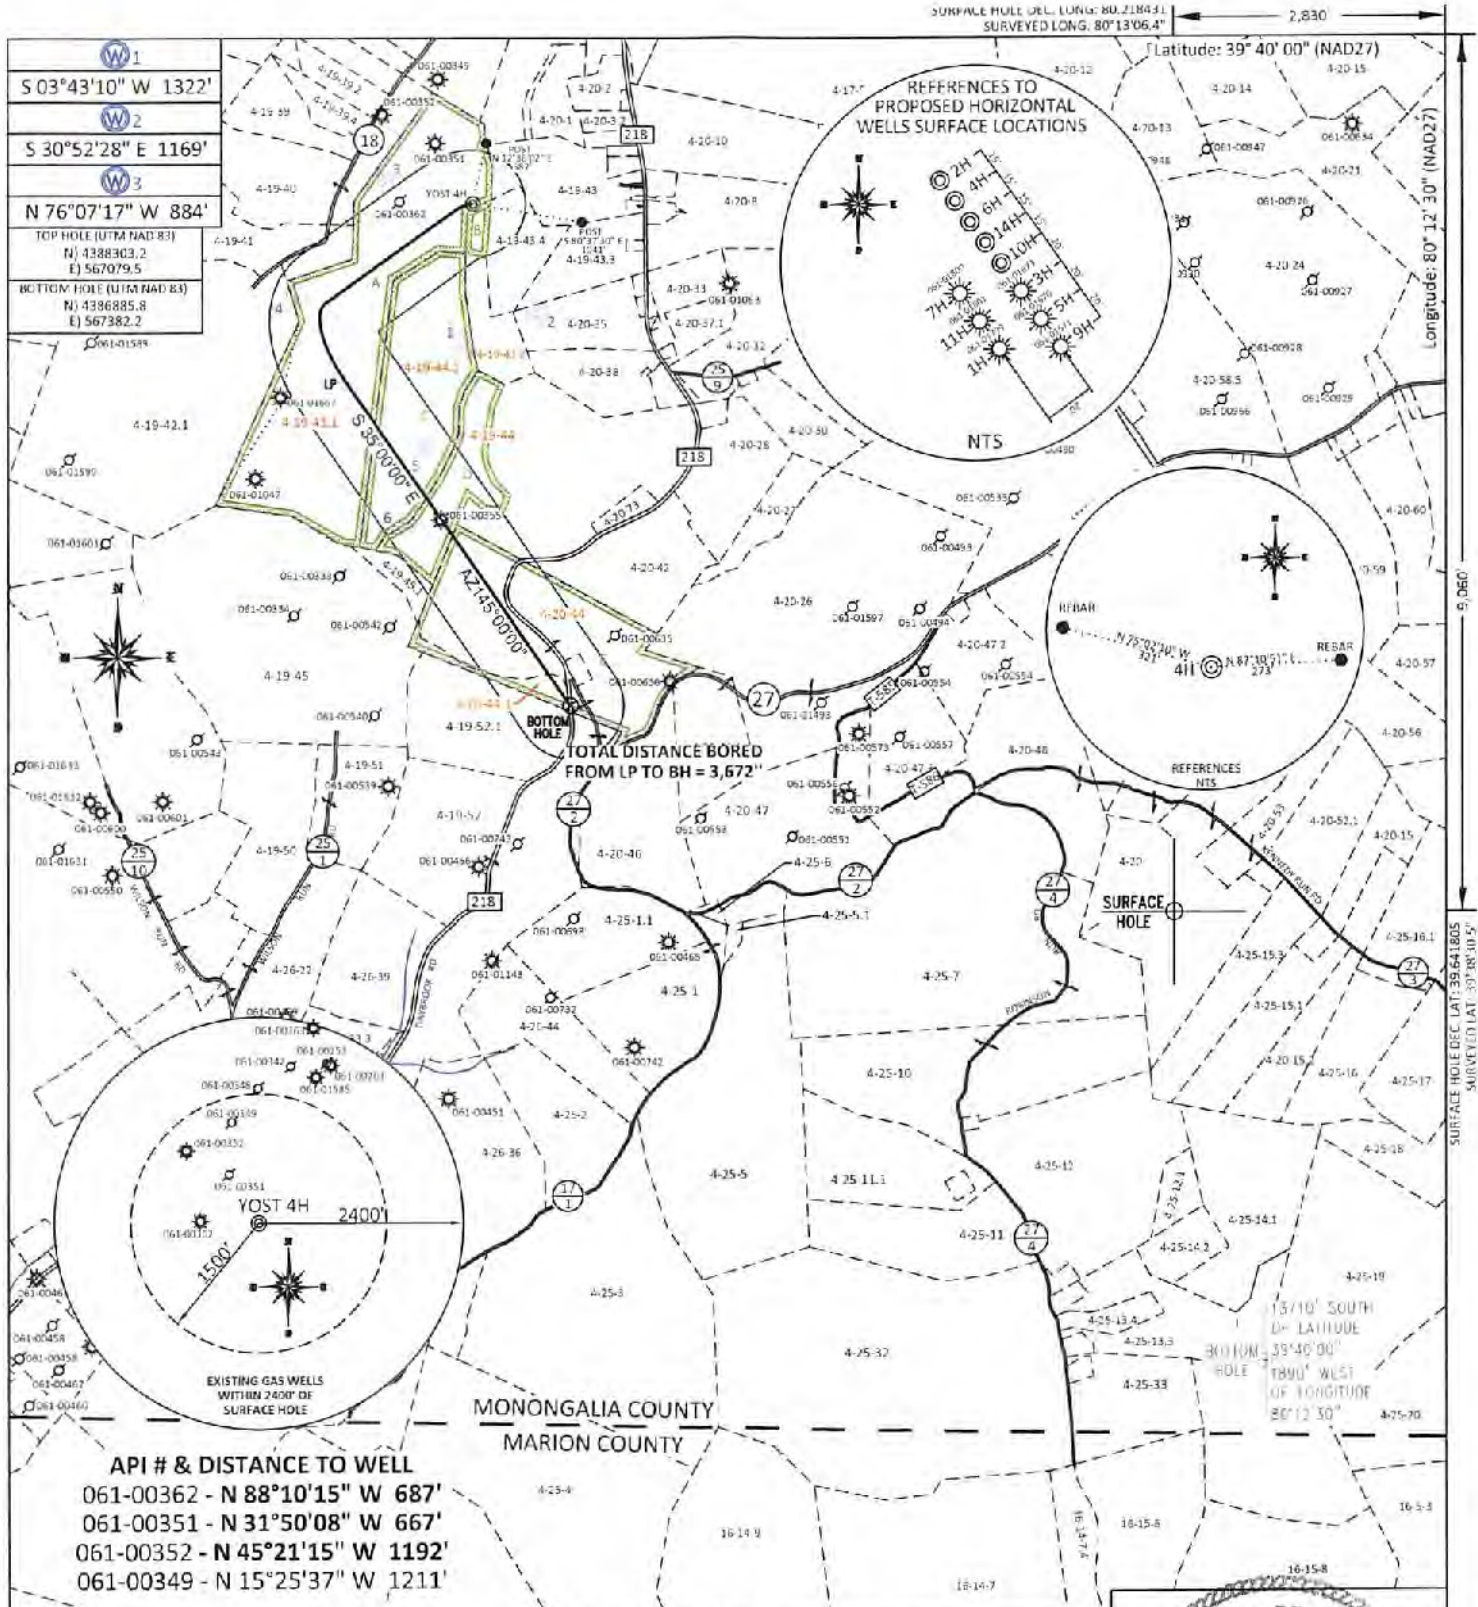

FILE #: NEE14
 DRAWING #: 3036
 SCALE: PLAT: 1" = 1800' TICK MARK: 1" = 2000'
 MINIMUM DEGREE OF ACCURACY: 1/200
 PROVEN SOURCE: SUBMETER MAPPING OF ELEVATION: GRADE GPS

I, THE UNDERSIGNED, HEREBY CERTIFY THAT THIS PLAT IS CORRECT TO THE BEST OF MY KNOWLEDGE AND BELIEF AND SHOWS ALL THE INFORMATION REQUIRED BY LAW AND THE REGULATIONS ISSUED AND PRESCRIBED BY THE DEPARTMENT OF ENVIRONMENTAL PROTECTION.

Signed: *[Signature]*
 L.L.S. #2124 : Ernest J. Benchek III

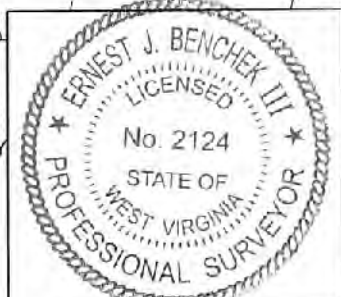

(+) DENOTES LOCATION OF WELL ON UNITED STATES TOPOGRAPHIC MAPS WYDEP

OFFICE OF OIL & GAS
 601 57TH STREET
 CHARLESTON, WV 25304

Well Type: Oil Waste Diposal Production Deep Gas Liquid Injection Storage Shallow

WATERSHED: DUNKARD CREEK

COUNTY/DISTRICT: MONONGALIA / CLAY

SURFACE OWNER: YOST HERITAGE INC

OIL & GAS ROYALTY OWNER:

LEASE NUMBERS:

DATE: OCTOBER 7, 2021

OPERATOR'S WELL #: YOST 4H

API WELL #: 47 61 01893
 STATE COUNTY PERMIT

AS-BUILT ELEVATION: 1,494.93'

QUADRANGLE: BLACKSVILLE, WV

ACREAGE: 93.08 12/03/2021

ACREAGE: 1104.079 +/-

DRILL CONVERT DRILL DEEPER REDRILL FRACTURE OR STIMULATE
 PLUG OFF FORMATION PERFORATE NEW FORMATION PLUG & ABANDON
 CLEAN OUT & REPLUG OTHER CHANGE (SPECIFY):

TARGET FORMATION: MARCELLUS

ESTIMATED DEPTH: TVD: 8,280' TMD: 12,724'

WELL OPERATOR: NORTHEAST NATURAL ENERGY LLC
 ADDRESS: 707 VIRGINIA STREET EAST, SUITE 1200
 CITY: CHARLESTON STATE: WV ZIP CODE: 25301

DESIGNATED AGENT: JOHN ADAMS
 ADDRESS: 707 VIRGINIA STREET EAST, SUITE 1200
 CITY: CHARLESTON STATE: WV ZIP CODE: 25301

PROPERTY OWNER INDEX	
4-19-43.1	YOST HERITAGE INC
4-19-44.1	YOST HERITAGE INC
4-19-44	FREDDIE C, LOIS JEAN MCCOY ET AL
4-20-44	GARY D YOST
4-20-44.1	YOST HERITAGE INC
4-19-43.2	YOST HERITAGE INC

LEASE INDEX	
A	WV-061-001043-002 ✓
B	WV-061-003452-000 ✓
C	WV-061-001043-002 ✓
D	WV-061-001043-002 ✓
E	WV-061-004923-001 ✓

RECEIVED
Office of Oil and Gas
OCT 29 2021
WV Department of
Environmental Protection

12/03/2021

FILE #: NEE14

DRAWING #: 2977

SCALE: N/A

DATE: OCTOBER 7, 2021

OPERATOR'S WELL #: YOST 4H

API WELL #: 47 61 01893
STATE COUNTY PERMIT

YOST WATER WELL EXHIBIT
OCTOBER 26, 2021
SCALE - (1"=500')



RECEIVED
Department of Oil and Gas
29 2021
Department of
Environmental Protection

WELL NAME: YOST 4H
BLACKSVILLE, WV



12/03/2021

OCT 29 2021

WV Department of
Environmental Protection

