


API # & DISTANCE TO WELL
 061-00362 - N 88°10'15" W 687'
 061-00351 - N 31°50'08" W 667'
 061-00352 - N 45°21'15" W 1192'
 061-00349 - N 15°25'37" W 1211'

TOTAL DISTANCE BORED FROM LP TO BH = 12,217'

FILE #: NEE14
 DRAWING #: 3036
 SCALE: PLAT: 1" = 1800'
 TICK MARK: 1" = 2000'
 MINIMUM DEGREE OF ACCURACY: 1/200
 PROVEN SOURCE: SUBMETER MAPPING
 OF ELEVATION: GRADE GPS

I, THE UNDERSIGNED, HEREBY CERTIFY THAT THIS PLAT IS CORRECT TO THE BEST OF MY KNOWLEDGE AND BELIEF AND SHOWS ALL THE INFORMATION REQUIRED BY LAW AND THE REGULATIONS ISSUED AND PRESCRIBED BY THE DEPARTMENT OF ENVIRONMENTAL PROTECTION.
 Signed: *[Signature]*
 L.L.S. #2124 : Ernest J. Benchek III

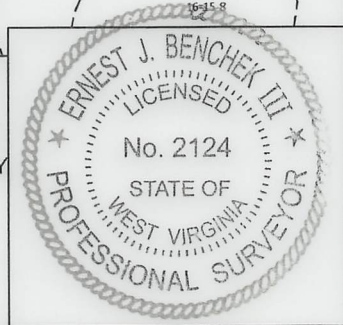

(+) DENOTES LOCATION OF WELL ON UNITED STATES TOPOGRAPHIC MAPS WYDEP
 OFFICE OF OIL & GAS
 601 57TH STREET
 CHARLESTON, WV 25304

Well Type: Oil Waste Diposal Production Deep
 Gas Liquid Injection Storage Shallow

WATERSHED: DUNKARD CREEK
 COUNTY/DISTRICT: MONONGALIA / CLAY
 SURFACE OWNER: YOST HERITAGE INC
 OIL & GAS ROYALTY OWNER:
 LEASE NUMBERS:

DATE: OCTOBER 26, 2022
 OPERATOR'S WELL #: YOST 4H
 API WELL #: 47 61 01893
 STATE COUNTY PERMIT

AS-BUILT ELEVATION: 1,494.93'
 QUADRANGLE: BLACKSVILLE, WV
 ACREAGE: 93.08 **02/23/2024**
 ACREAGE: 1104.079 +/-

DRILL CONVERT DRILL DEEPER REDRILL FRACTURE OR STIMULATE
 PLUG OFF FORMATION PERFORATE NEW FORMATION PLUG & ABANDON
 CLEAN OUT & REPLUG OTHER CHANGE (SPECIFY):

TARGET FORMATION: MARCELLUS
 WELL OPERATOR: NORTHEAST NATURAL ENERGY LLC
 ADDRESS: 707 VIRGINIA STREET EAST, SUITE 1200
 CITY: CHARLESTON STATE: WV ZIP CODE: 25301

DRILLED DEPTH: TVD: 8,270' TMD: 21,184'
 DESIGNATED AGENT: JOHN ADAMS
 ADDRESS: 707 VIRGINIA STREET EAST, SUITE 1200
 CITY: CHARLESTON STATE: WV ZIP CODE: 25301

PROPERTY OWNER INDEX	
4-19-43.1	YOST HERITAGE INC
4-19-44.1	YOST HERITAGE INC
4-19-44	LOIS JEAN MCCOY, SANDY L MOORE ET AL
4-20-44	GARY D YOST
4-20-44.1	YOST HERITAGE INC
4-19-52.1	YOST HERITAGE INC
4-19-52	LARRY F & BRENDA KAY KUHN
4-25-11.1	KITTY S HAYES
4-25-1	JOHN G & PATRICIA CONAWAY
4-25-5	EDWARD & KARLA STROSNIDER
4-25-11	KITTY S HAYES
4-25-32	EDWARD & KARLA STROSNIDER
4-20-46	YOST & YOST PIPE CO
4-20-47	DARRELL E EDDY
4-25-6	JOHN G & PATRICIA CONAWAY
4-25-1	JOHN G & PATRICIA CONAWAY
4-25-5.1	EQUITRANS LP
4-25-7	EVA V & ROGER A TULANOWSKI; RONALD T TULANOWSKI II
4-25-10	KITTY S WOLFE & CRYSTAL L HAYES
4-25-33	EDWARD & KARLA STROSNIDER

LEASE INDEX			
A	WV-061-001043-002	H	WV-061-004923-001
B	WV-061-001043-002	I	WV-061-005854-001
C	WV-061-001043-002	J	WV-061-004923-001
D	WV-061-003452-000	K	WV-061-004016-013
E	WV-061-001043-002	L	WV-049-004080-001
F	WV-061-004923-001	M	WV-061-005853-001
G	WV-061-005854-001	N	WV-061-005853-001
		O	WV-061-005854-001
		P	WV-049-004080-001

02/23/2024

FILE #: NEE14

DRAWING #: 2977

SCALE: N/A

DATE: OCTOBER 26, 2022

OPERATOR'S WELL #: YOST 4H

API WELL #: 47 61 01893
STATE COUNTY PERMIT