

SURFACE HOLE DEC. LONG: 80.217749
 SURVEYED LONG: 80°13'03.9"

Latitude: 39° 40' 00" (NAD27)

Longitude: 80° 12' 30" (NAD27)

1.520'

SURFACE HOLE DEC. LAT: 39.662488
 SURVEYED LAT: 39°39'45.0"

W 1

S 33°57'00" E 1067'

NTS

WELL (BOTTOM HOLE) BUNNER 5H
 WV-N (NAD 83)
 N: 439875.2
 E: 1757448.4
 UTM (NAD 83)
 N: 4395314.2
 E: 564281.2

WELL (BOTTOM HOLE) BUNNER 5H
 WV-N (NAD 83)
 N: 433886.3
 E: 1757448.4
 UTM (NAD 83)
 N: 4395317.7
 E: 564286.0

WELL (LANDING POINT) BUNNER 5H
 WV-N (NAD 83)
 N: 424756.6
 E: 1767577.0
 UTM (NAD 83)
 N: 4390758.7
 E: 567429.1

WELL (LANDING POINT) BUNNER 5H
 WV-N (NAD 83)
 N: 424762.3
 E: 1767536.3
 UTM (NAD 83)
 N: 4390761.1
 E: 567431.7

WELL (SURFACE HOLE) BUNNER 5H
 WV-N (NAD 83)
 N: 424248.4
 E: 1766498.0
 UTM (NAD 83)
 N: 4390599.3
 E: 567118.0

WELL (SURFACE HOLE) BUNNER 5H
 WV-N (NAD 83)
 N: 424248.4
 E: 1766498.0
 UTM (NAD 83)
 N: 4390599.3
 E: 567118.0

FILE #: NEE14

DRAWING #: 3076

SCALE: PLAT: 1" = 2200'
 TICK MARK: 1" = 2000'


MINIMUM DEGREE OF ACCURACY: 1/200

PROVEN SOURCE OF ELEVATION: SUBMETER MAPPING GRADE GPS

I, THE UNDERSIGNED, HEREBY CERTIFY THAT THIS PLAT IS CORRECT TO THE BEST OF MY KNOWLEDGE AND BELIEF AND SHOWS ALL THE INFORMATION REQUIRED BY LAW AND THE REGULATIONS ISSUED AND PRESCRIBED BY THE DEPARTMENT OF ENVIRONMENTAL PROTECTION.

Signed: *[Signature]*

L.L.S. #2124 : Ernest J. Benchek III

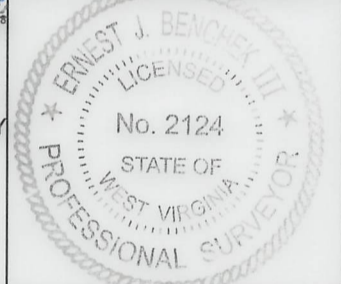

(+) DENOTES LOCATION OF WELL ON UNITED STATES TOPOGRAPHIC MAPS WVDEP

OFFICE OF OIL & GAS
 601 57TH STREET
 CHARLESTON, WV 25304

Well Type: Oil Waste Diposal Production Deep
 Gas Liquid Injection Storage Shallow

WATERSHED: DUNKARD CREEK

COUNTY/DISTRICT: MONONGALIA / CLAY

SURFACE OWNER: PATRICIA A. BUNNER

OIL & GAS ROYALTY OWNER: PATRICIA BUNNER, et al

LEASE NUMBERS:

DATE: JANUARY 10, 2024

OPERATOR'S WELL #: BUNNER 5H DRILLED

API WELL #: 47 61 01908

STATE COUNTY PERMIT

AS-BUILT

ELEVATION: 1277.25'

QUADRANGLE: BLACKSVILLE, WV

ACREAGE: 94.72

ACREAGE: 839.16 +/-

DRILL CONVERT DRILL DEEPER REDRILL FRACTURE OR STIMULATE
 PLUG OFF FORMATION PERFORATE NEW FORMATION PLUG & ABANDON
 CLEAN OUT & REPLUG OTHER CHANGE (SPECIFY):

TARGET FORMATION: MARCELLUS

DRILLED DEPTH: TVD: 8,138' TMD: 26,835'

DESIGNATED AGENT: JOHN ADAMS

ADDRESS: 707 VIRGINIA STREET EAST, SUITE 1200

CITY: CHARLESTON STATE: WV ZIP CODE: 25301

| PROPERTY OWNER INDEX | |
|----------------------|--|
| 4-9-44 | MAKAYLA ROSE, HALEY BROOKE & ABAGAIL PAIGE BARR |
| 4-9-43 | CHISLER INC |
| 4-9-43.1 | CHARLES W & KENALL L MOORE; JASON T MOORE ET AL |
| 4-9-45.1 | JERRY WILSON ET AL |
| 4-9-49 | RONNIE LYNN MCCORD |
| 4-18-33 | 4 BROTHERS LLC |
| 4-9-45 | JERRY WILSON ET AL |
| 4-17A-39 | EDWARD BAEZ JR & TERESA BAEZ |
| 4-17A-40 | EDWARD BAEZ JR & TERESA BAEZ |
| 4-17A-36 | GLENNA D OWENS |
| 4-17A-37 | DAYBROOK CHURCH OF CHRIST |
| 4-17-5 | JUDITH R SINE |
| 4-17A-43 | GARY L & ANNA M SIMPSON |
| 4-17A-44 | CHRISTOPHER MARK TENNANT JR |
| 4-17-33.1 | LINDSAY J & PATRICIA A TENNANT |
| 4-9-15 | LOIS J MCCOY ET AL |
| 4-9-3 | JEFFREY TODD & CARLENE SUE MOORE ET AL |
| 4-9-4 | BRUCE & CATHY L CHISLER |
| 4-9-14 | FRED A MASON |
| 4-17-2 | ANGELA L CHISLER |
| 4-17-3 | ANGELA L CHISLER |
| 4-17-4 | DAYBROOK CHURCH OF CHRIST |
| 4-18-32 | PATRICIA A BUNNER |
| 4-17A-41 | EDWARD BAEZ JR & TERESA BAEZ |
| 4-17A-38.1 | EVERETT & DOROTHY BARR |
| 4-17-35 | CNX LAND LLC |
| 4-17A-34 | ANTIOCH CHRISTIAN CHURCH |
| 4-8-2 | KATHY LYNN SNYDER, ELIZABETH ANN REESE & JOHN M BUTCHER SR |
| 4-8-3.1 | RAYMOND L ALLEN |
| 4-8-4.2 | CRISTY G MCHENRY & LEONARD D TENNANT |
| 4-8-4 | L DOUGLAS & VICKI L TENNANT |
| 1-8-5 | KENNETH W & DONNA P EFAW |
| 4-8-5.2 | KIEARA PAIGE SNYDER |
| 4-9-52 | SANDRA BLEIGH |
| 4-17-35.1 | JEFFREY & MARSHA GUM |
| 4-17-35.2 | LISA JO BARNETTE A/K/A/ LISA BARNETT & JEFFERY WAYNE |
| 4-17-35.3 | JACKIE P GUM |
| 4-17-45 | JACK L MCCOY JR & BARBARA S PHILLIPS |
| 4-17A-42 | EDWARD BAEZ JR & TERESA BAEZ |
| 4-17-36 | EDWARD BAEZ JR & TERESA BAEZ |
| 4-18-33 | 4 BROTHERS LLC |
| 4-17A-38 | EDWARD BAEZ JR & TERESA BAEZ |
| 4-17A-38.2 | EDWARD BAEZ JR & TERESA BAEZ |

| LEASE INDEX | | | | | |
|-------------|-------------------|---|-------------------|----|----------------------|
| A | WV-061-004154-001 | N | WV-061-003959-010 | AA | WV-061-003887-001 |
| B | WV-061-005157-033 | O | WV-061-004096-000 | BB | WV-061-005813-001 |
| C | WV-061-005157-033 | P | WV-061-004110-000 | CC | WV-061-004183-001 |
| D | WV-061-005157-033 | Q | WV-061-005711-001 | DD | WV-061-005837-001 |
| E | WV-061-005157-033 | R | WV-061-005711-001 | EE | WV-061-003670-037 |
| F | WV-061-004824-001 | S | WV-061-005711-001 | FF | WV-061-003670-037 |
| G | WV-061-003958-000 | T | WV-061-005878-001 | GG | WV-061-005946-002 |
| H | WV-061-002341-000 | U | WV-061-005808-002 | HH | WV-061-00161-01-LA |
| I | WV-061-005118-000 | V | WV-061-004983-001 | II | WV-061-006004-001 |
| J | WV-061-003958-000 | W | WV-061-005826-001 | JJ | WV-061-000160-001-LA |
| K | WV-061-005118-000 | X | WV-061-005884-005 | KK | WV-061-005863-002 |
| L | WV-061-003849-000 | Y | WV-061-004968-001 | LL | WV-061-005147-000 |
| M | WV-061-003959-010 | Z | WV-061-005884-005 | MM | WV-061-005118-000 |

02/23/2024

FILE #: NEE14

DATE: JANUARY 10, 2024

DRAWING #: 3076

OPERATOR'S WELL #: BUNNER 5H DRILLED

SCALE: N/A

API WELL #: 47 61 01908
STATE COUNTY PERMIT