


FILE #: NEE14
 DRAWING #: 3077
 SCALE: PLAT: 1" = 2200'
 TICK MARK: 1" = 2000'
 MINIMUM DEGREE OF ACCURACY: 1/200
 PROVEN SOURCE OF ELEVATION: SUBMETER MAPPING GRADE GPS

I, THE UNDERSIGNED, HEREBY CERTIFY THAT THIS PLAT IS CORRECT TO THE BEST OF MY KNOWLEDGE AND BELIEF AND SHOWS ALL THE INFORMATION REQUIRED BY LAW AND THE REGULATIONS ISSUED AND PRESCRIBED BY THE DEPARTMENT OF ENVIRONMENTAL PROTECTION.
 Signed: *[Signature]*
 L.L.S. #2124 : Ernest J. Benchek III

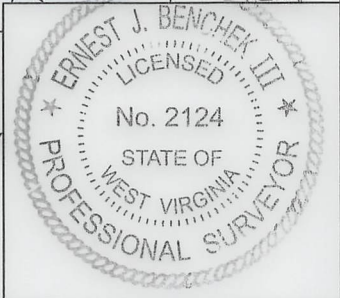

(+) DENOTES LOCATION OF WELL ON UNITED STATES TOPOGRAPHIC MAPS WYDEP
 OFFICE OF OIL & GAS
 601 57TH STREET
 CHARLESTON, WV 25304
 Well Type: Oil Waste Diposal Production Deep
 Gas Liquid Injection Storage Shallow
 WATERSHED: DUNKARD CREEK
 COUNTY/DISTRICT: MONONGALIA / CLAY
 SURFACE OWNER: PATRICIA A. BUNNER
 OIL & GAS ROYALTY OWNER: PATRICIA BUNNER, et al
 LEASE NUMBERS:

DATE: JANUARY 10, 2024
 OPERATOR'S WELL #: BUNNER 7H DRILLED
 API WELL #: 47 61 01909
 STATE COUNTY PERMIT
 AS-BUILT
 ELEVATION: 1277.25'
 QUADRANGLE: BLACKSVILLE, WV
 ACREAGE: 94.72 +/-
 ACREAGE: 792.09 +/-

DRILL CONVERT DRILL DEEPER REDRILL FRACTURE OR STIMULATE
 PLUG OFF FORMATION PERFORATE NEW FORMATION PLUG & ABANDON
 CLEAN OUT & REPLUG OTHER CHANGE (SPECIFY):
 TARGET FORMATION: MARCELLUS
 DRILLED DEPTH: TVD: 8,113' TMD: 25,060'
 WELL OPERATOR: NORTHEAST NATURAL ENERGY LLC
 ADDRESS: 707 VIRGINIA STREET EAST, SUITE 1200
 CITY: CHARLESTON STATE: WV ZIP CODE: 25301
 DESIGNATED AGENT: JOHN ADAMS
 ADDRESS: 707 VIRGINIA STREET EAST, SUITE 1200
 CITY: CHARLESTON STATE: WV ZIP CODE: 25301

PROPERTY OWNER INDEX	
4-18-30	PRUDENCE G BERRY
4-18-32	PATRICIA A BUNNER
4-18-31	ROBERT ELDON BERRY; PRUDENCE G BERRY & DEBRA JEAN JONES
4-18-29.1	BILLY VON DEVINE
4-9-34	DANNY K & MONICA MOORE
4-18-28	SHANNON REEVES
4-18-29	GILBERT DONALD BERRY (LIFE-ROBERT E BERRY SR)
1-6-19	VERNON C VARNER & TAMMY R TENNANT
1-6-18	DAVID N & WILLA R HOWARD
1-6-18.1	CLAY BATTELLE PUBLIC SERVICE DISTRICT
1-6-24	ROGER E SWANSON; MELVIN L SWANSON, ET AL (LIFE SHELBY LEARY)
1-6-25.2	DANIEL A ROBBINS
1-6-25	JOSEPH T & DEBRA L MERCER
1-15-1.1	ROD L & DEBORAH E CARPENTER
1-15-2	ERP FEDERAL MINING COMPLEX LLC
4-9-18	JODIE DAWN & JEFFREY LANE SHRIVER
4-9-19	BART L, CHRIS M & BUCKEY L WILSON
1-15-3	SHUMAN INC
4-9-24.2	EVERETT D WILSON; DOTTIE REEMAN; CINDY DONALDSON
4-9-24.3	AARON D & CARLA R WILSON
4-9-24	HAMPTON D COTTRELL
4-9-25.1	JEFFREY J & SANDRA J MOORE
4-9-31	ALLEN K & VIRGINIA L MOORE
4-9-33	CHRISTOPHER BLAINE & SHARON WILSON

LEASE INDEX			
A	WV-061-004154-001	M	WV-061-004823-023
B	WV-061-005378-013	N	WV-061-004823-023
C	WV-061-005639-001	O	WV-061-004823-023
D	WV-061-005378-013	P	WV-061-004823-023
E	WV-061-005966-001	Q	WV-061-004821-004
F	WV-061-005899-001	R	WV-061-005889-001
G	WV-061-005890-001	S	WV-061-004139-001
H	WV-061-005189-001	T	WV-061-005889-001
I	WV-061-005189-011	U	WV-061-005806-001
J	WV-061-004996-001	V	WV-061-005829-001
K	WV-061-000160-001-LA	W	WV-061-005806-001
L	WV-061-000160-001-LA	X	WV-061-003896-005

02/23/2024

FILE #: NEE14

DRAWING #: 3077

SCALE: N/A

DATE: JANUARY 10, 2024

OPERATOR'S WELL #: BUNNER 7H DRILLED

API WELL #: 47 61 01907
STATE COUNTY PERMIT